
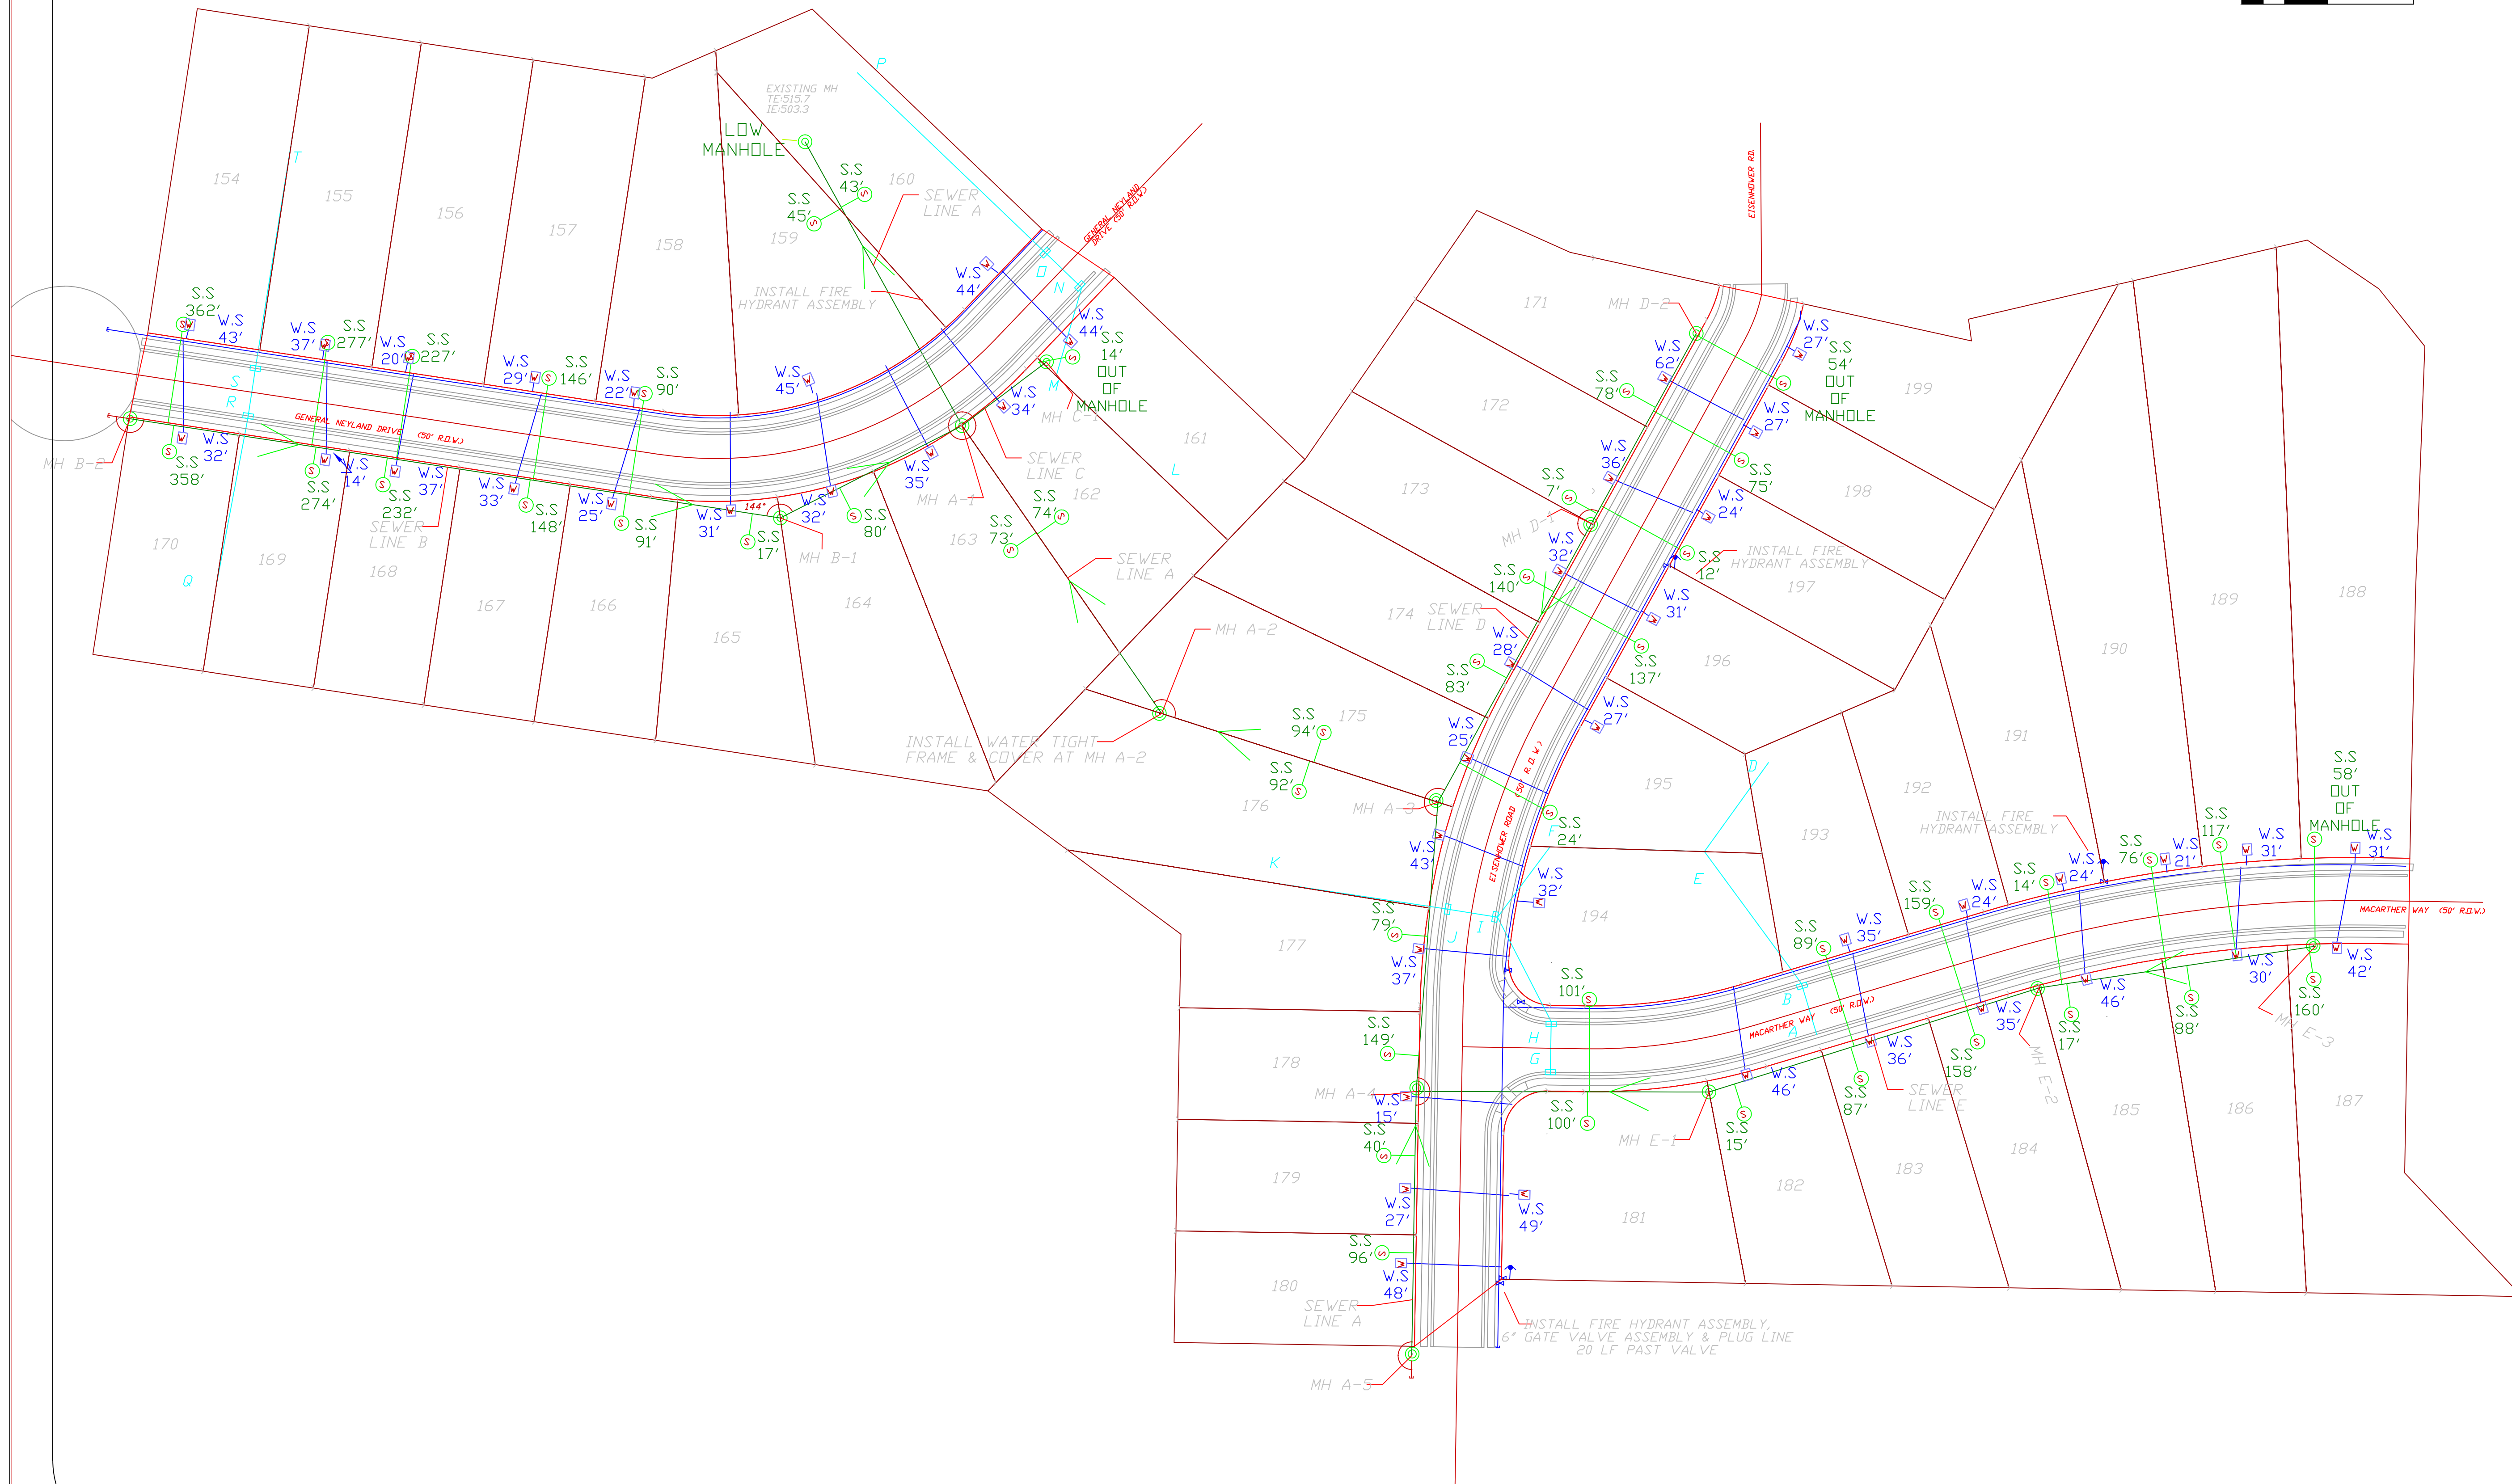


Autumn Creek Section 4 As-Built file

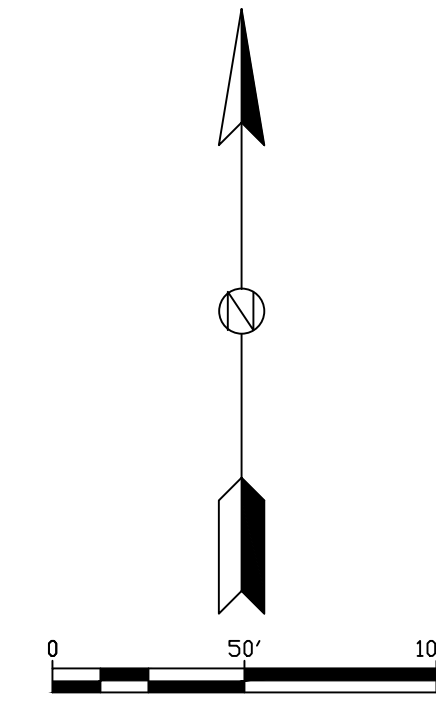

General Notes

All sewer service locations are measured from the nearest downstream manhole.

No.	Revision/Issue	Date

Firm Name and Address

Project Name and Address
 Autumn Creek Sec 4
 Utility As-Built

Project	Sheet
Date 1/4/2013	A-1
Scale 1" = 50'	

ACreek 4 AsBuilts 13113.dwg