
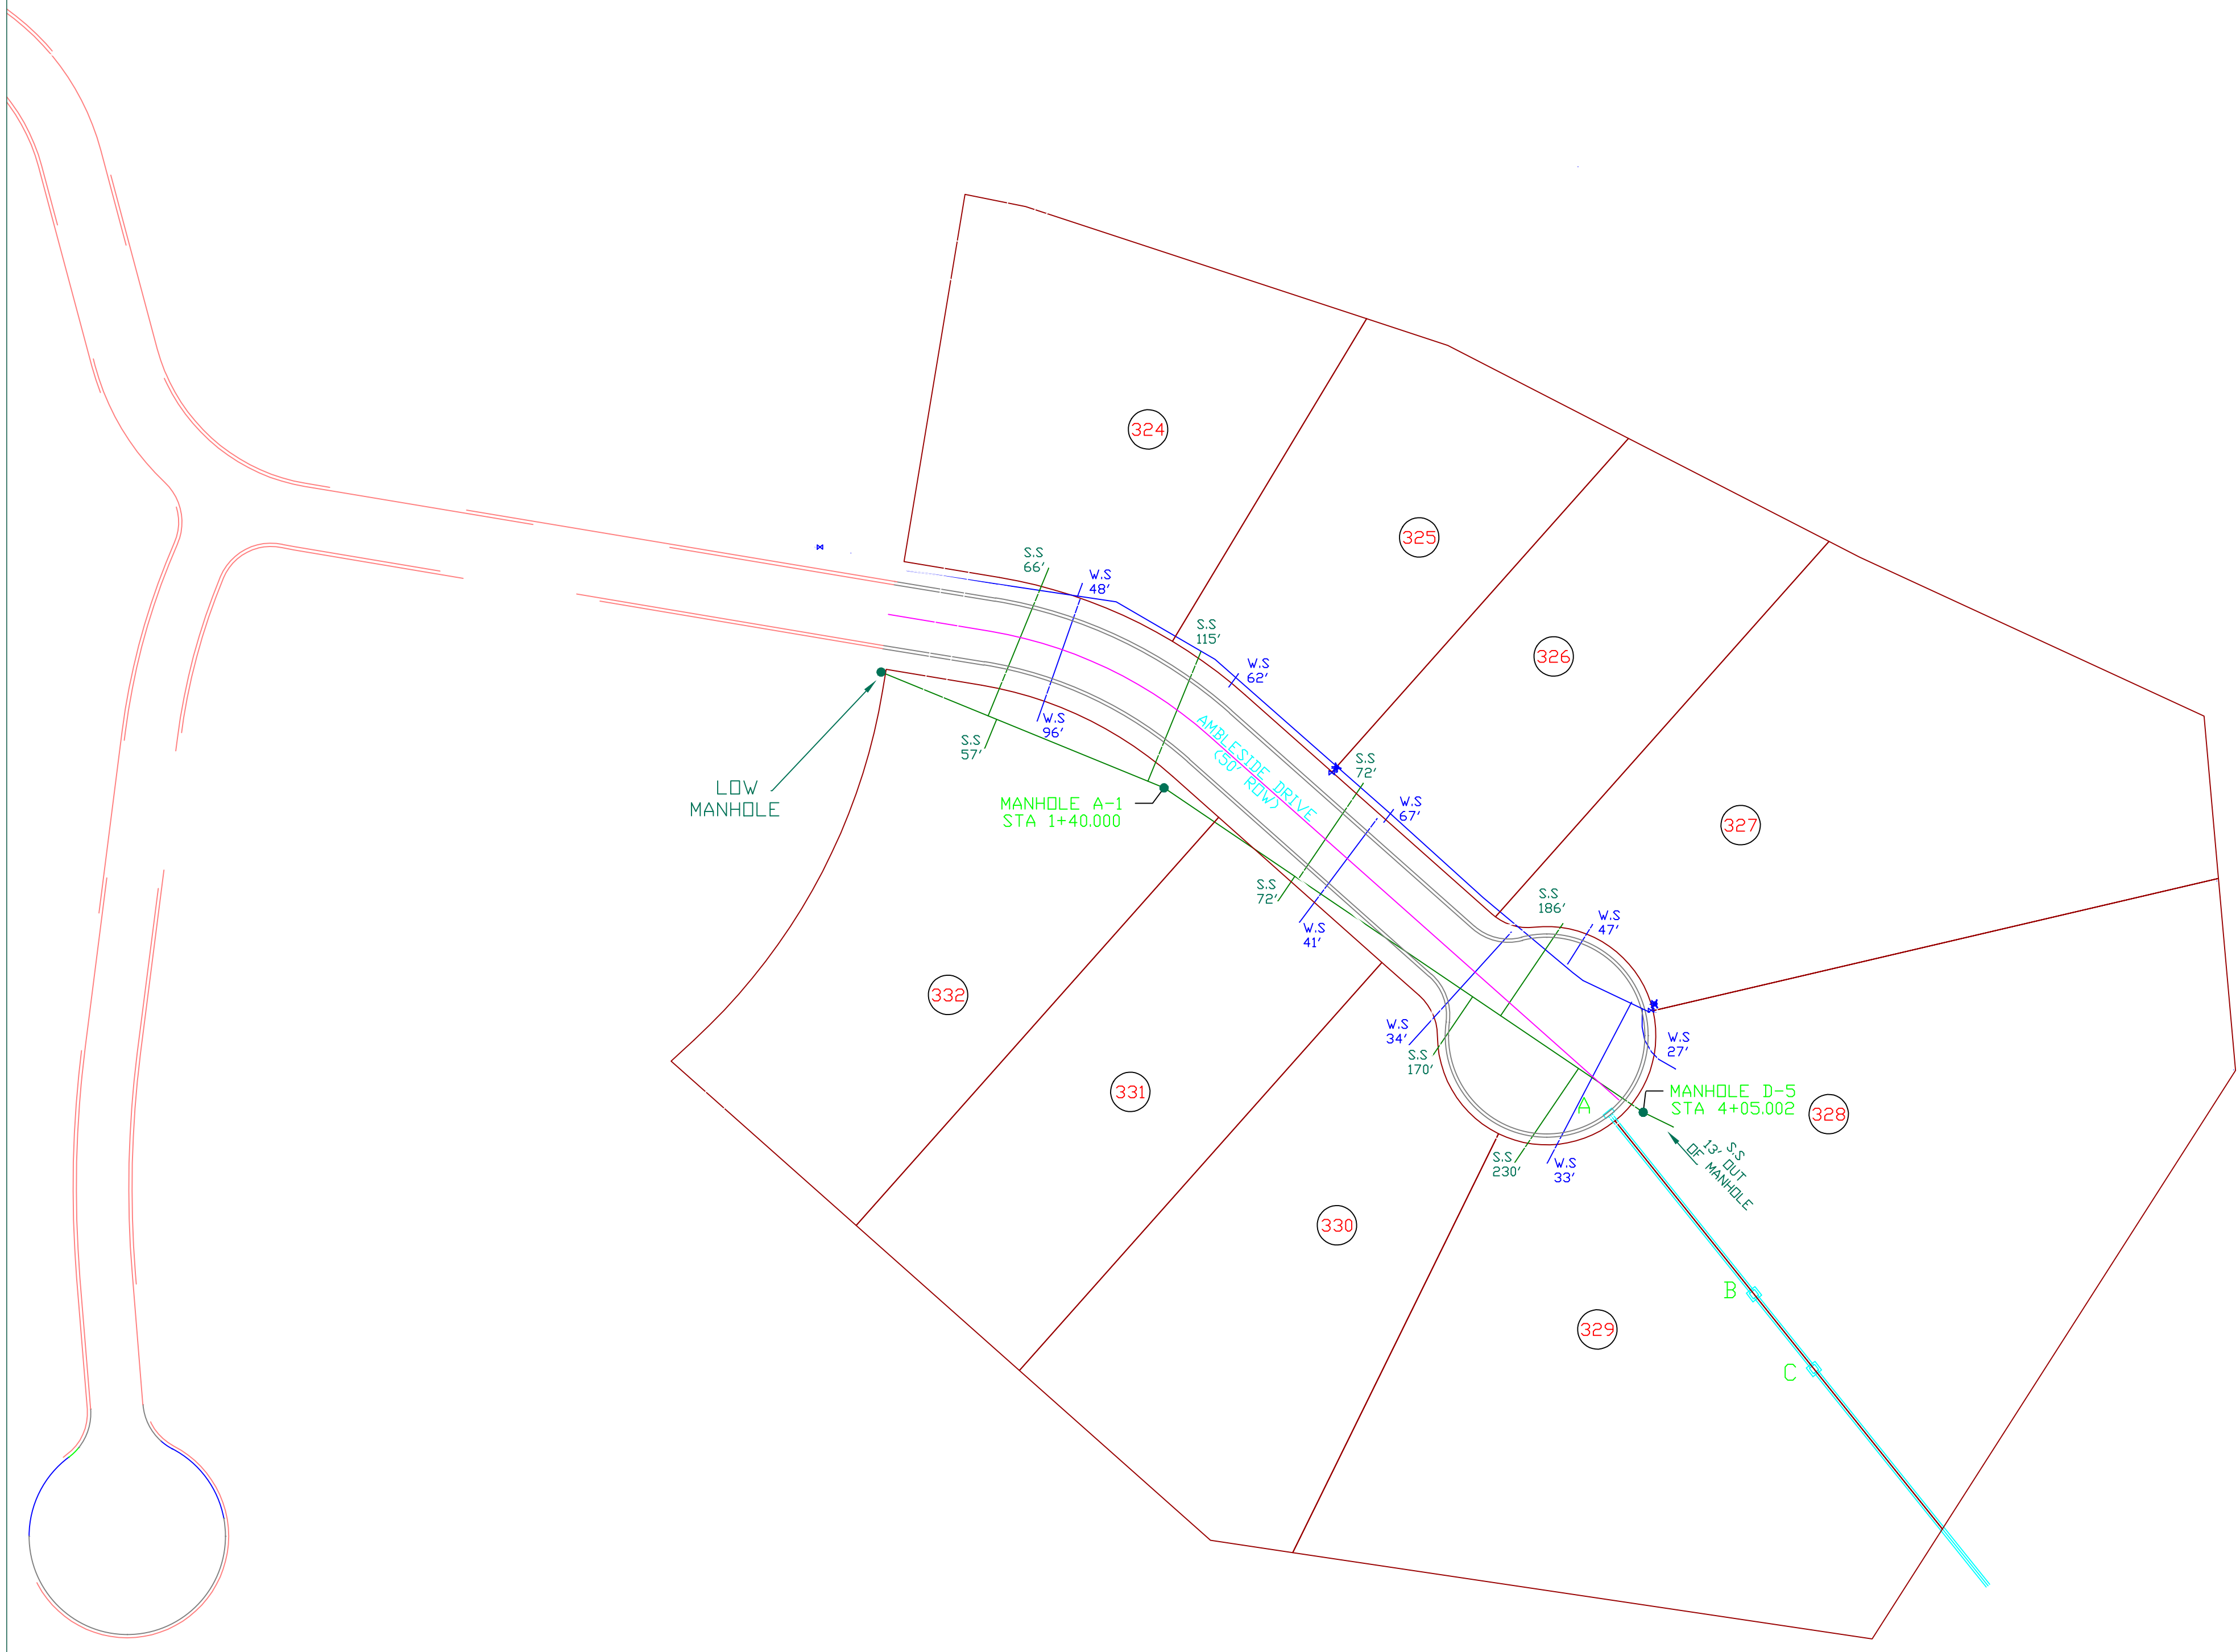


Benton Park

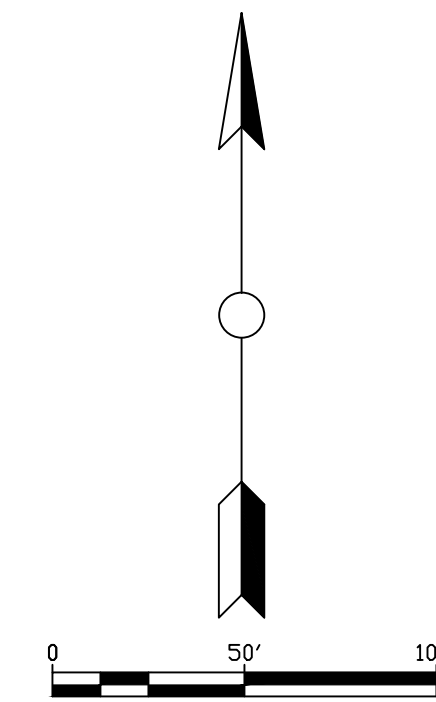

General Notes

AS-BUILTS		
No.	Revision/Issue	Date

Firm Name and Address

Project Name and Address
 BENTON PARK

Project BENTON PARK	Sheet
Date 7/12/2012	01
Scale 1" = 50'	