



Copperstone

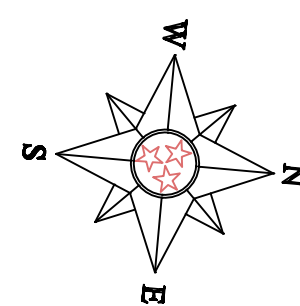

Graphic Scale 1" = 100'
 50 0 100

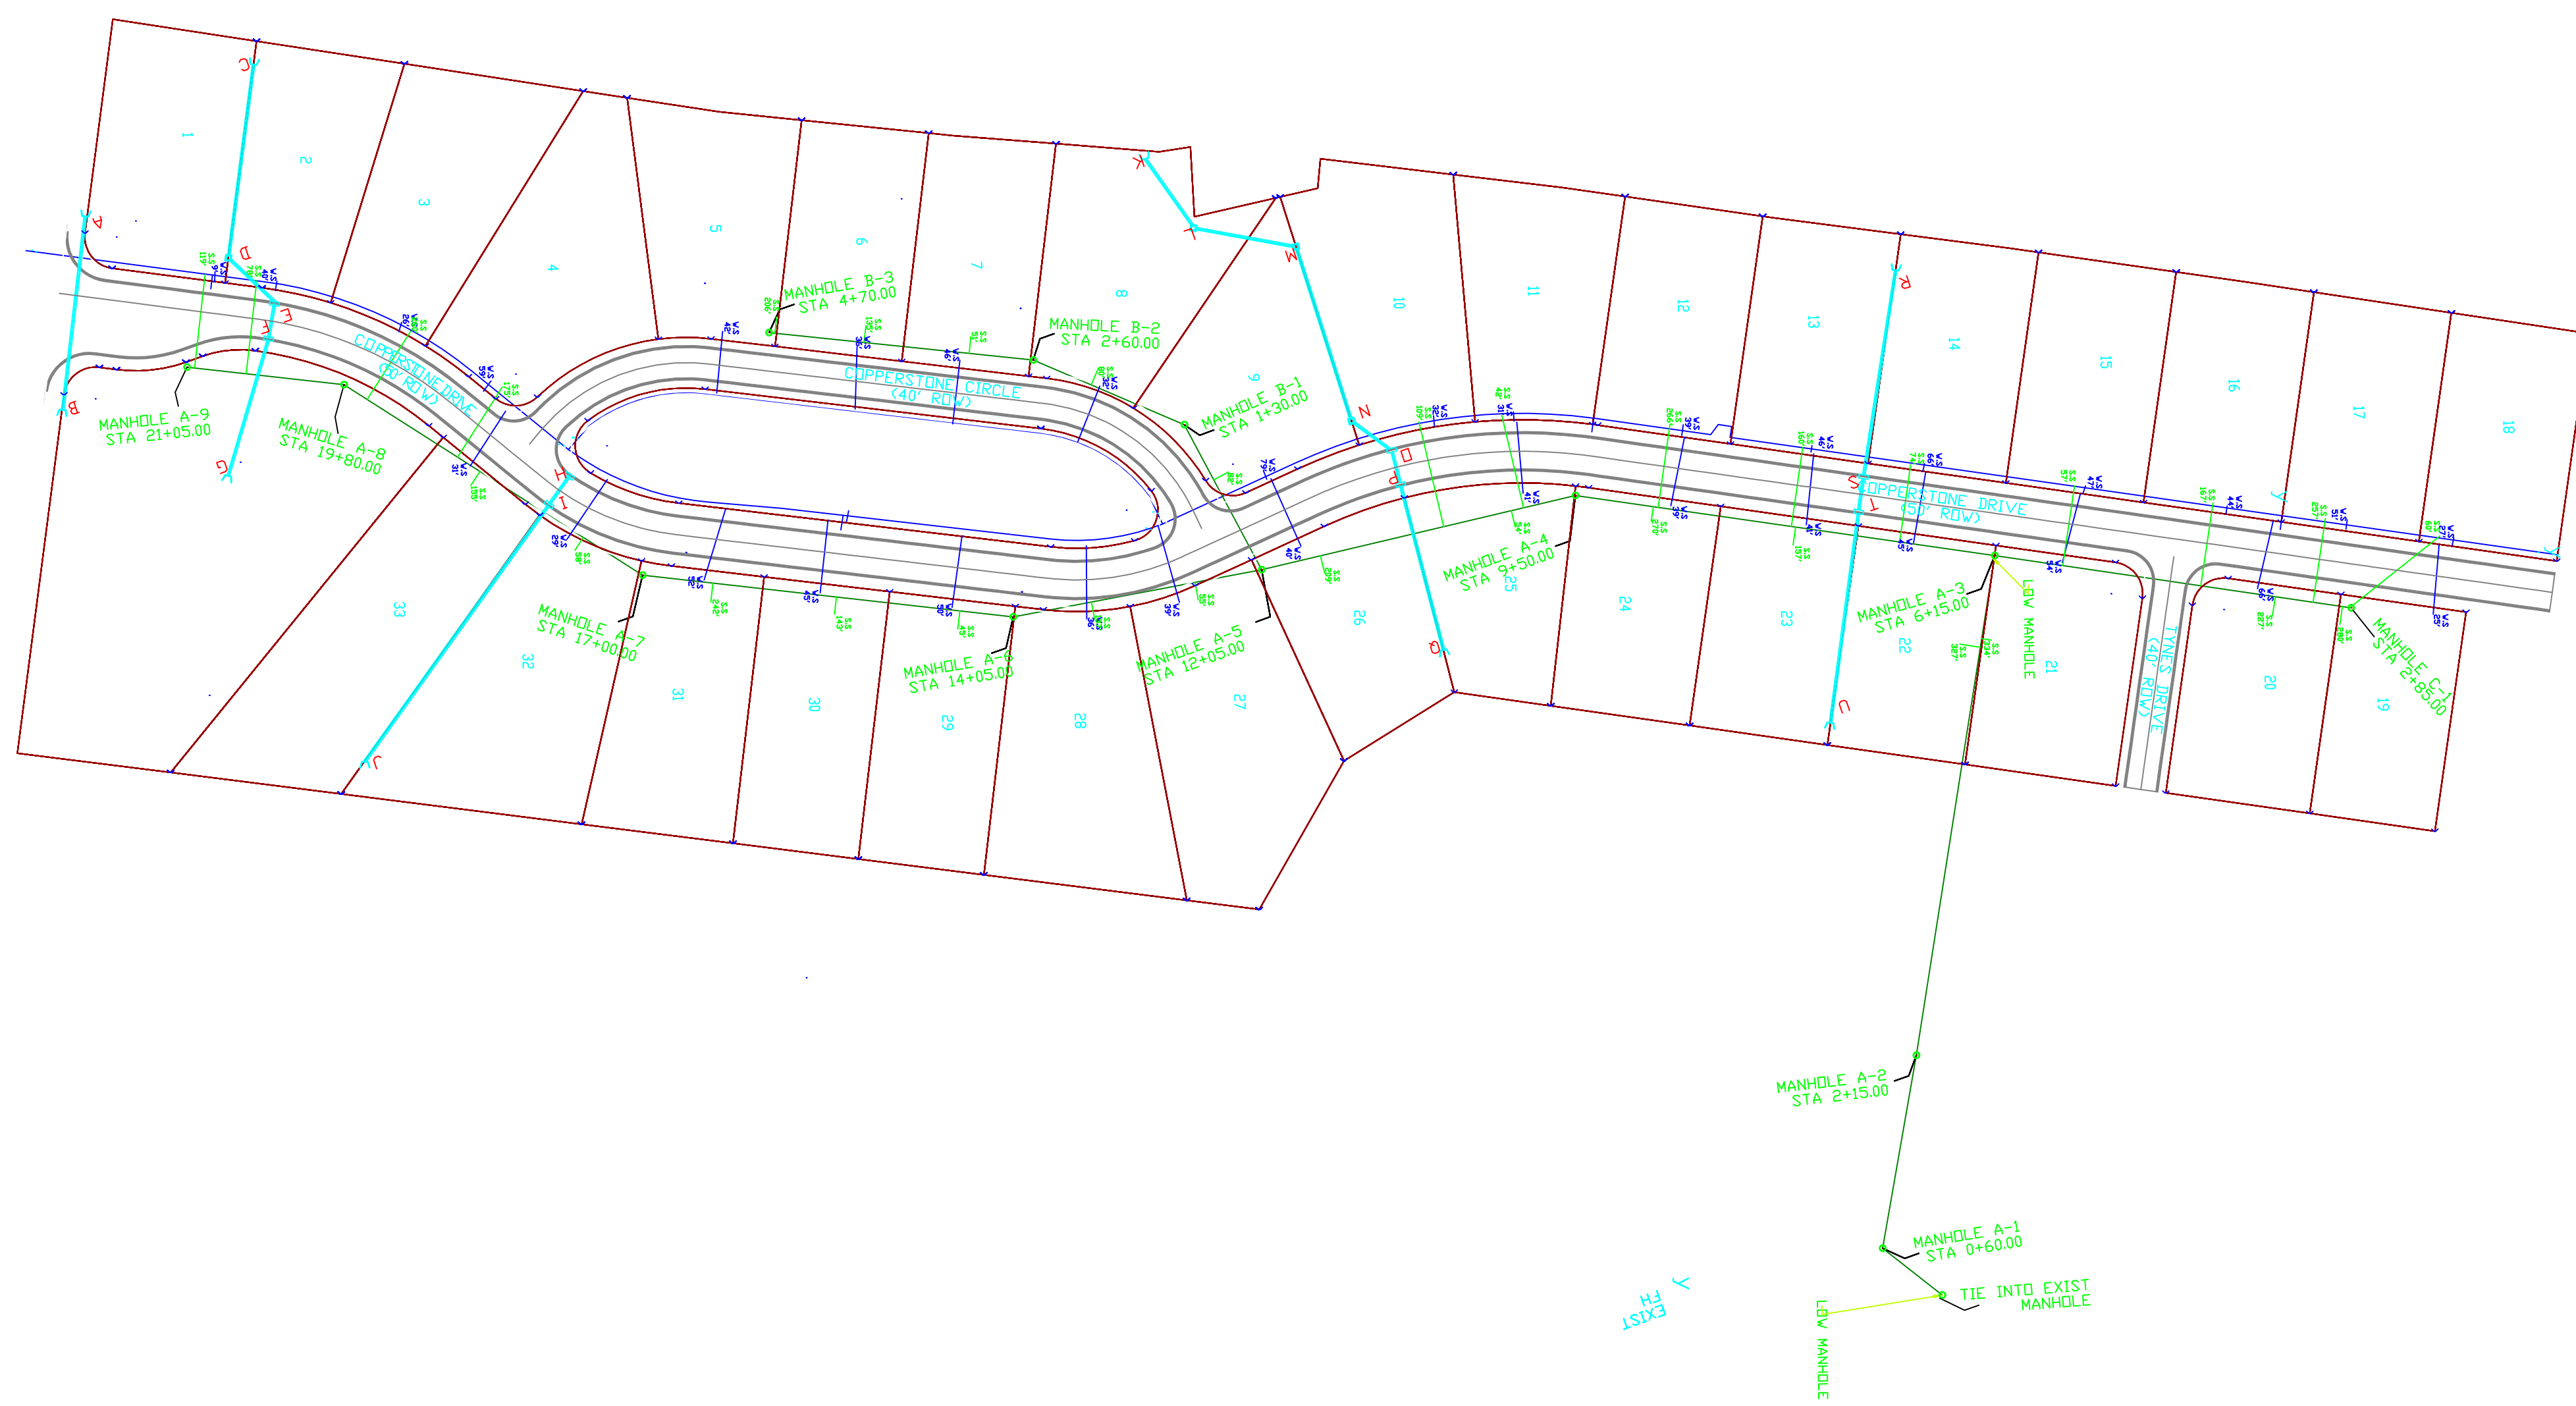

General Notes

No.	Revision/Issue	Date

Firm Name and Address

Project Name and Address

Project COPPERSTONE	Sheet 01
Date 12/1/2011	
Scale 1:100	