




3136 OLD SANGD RD.  
CLARKSVILLE, TN

UTILITY AS-BUILTS  
FARMINGTON SEC 4B  
CLARKSVILLE, TN

SCALE: 1"=50'

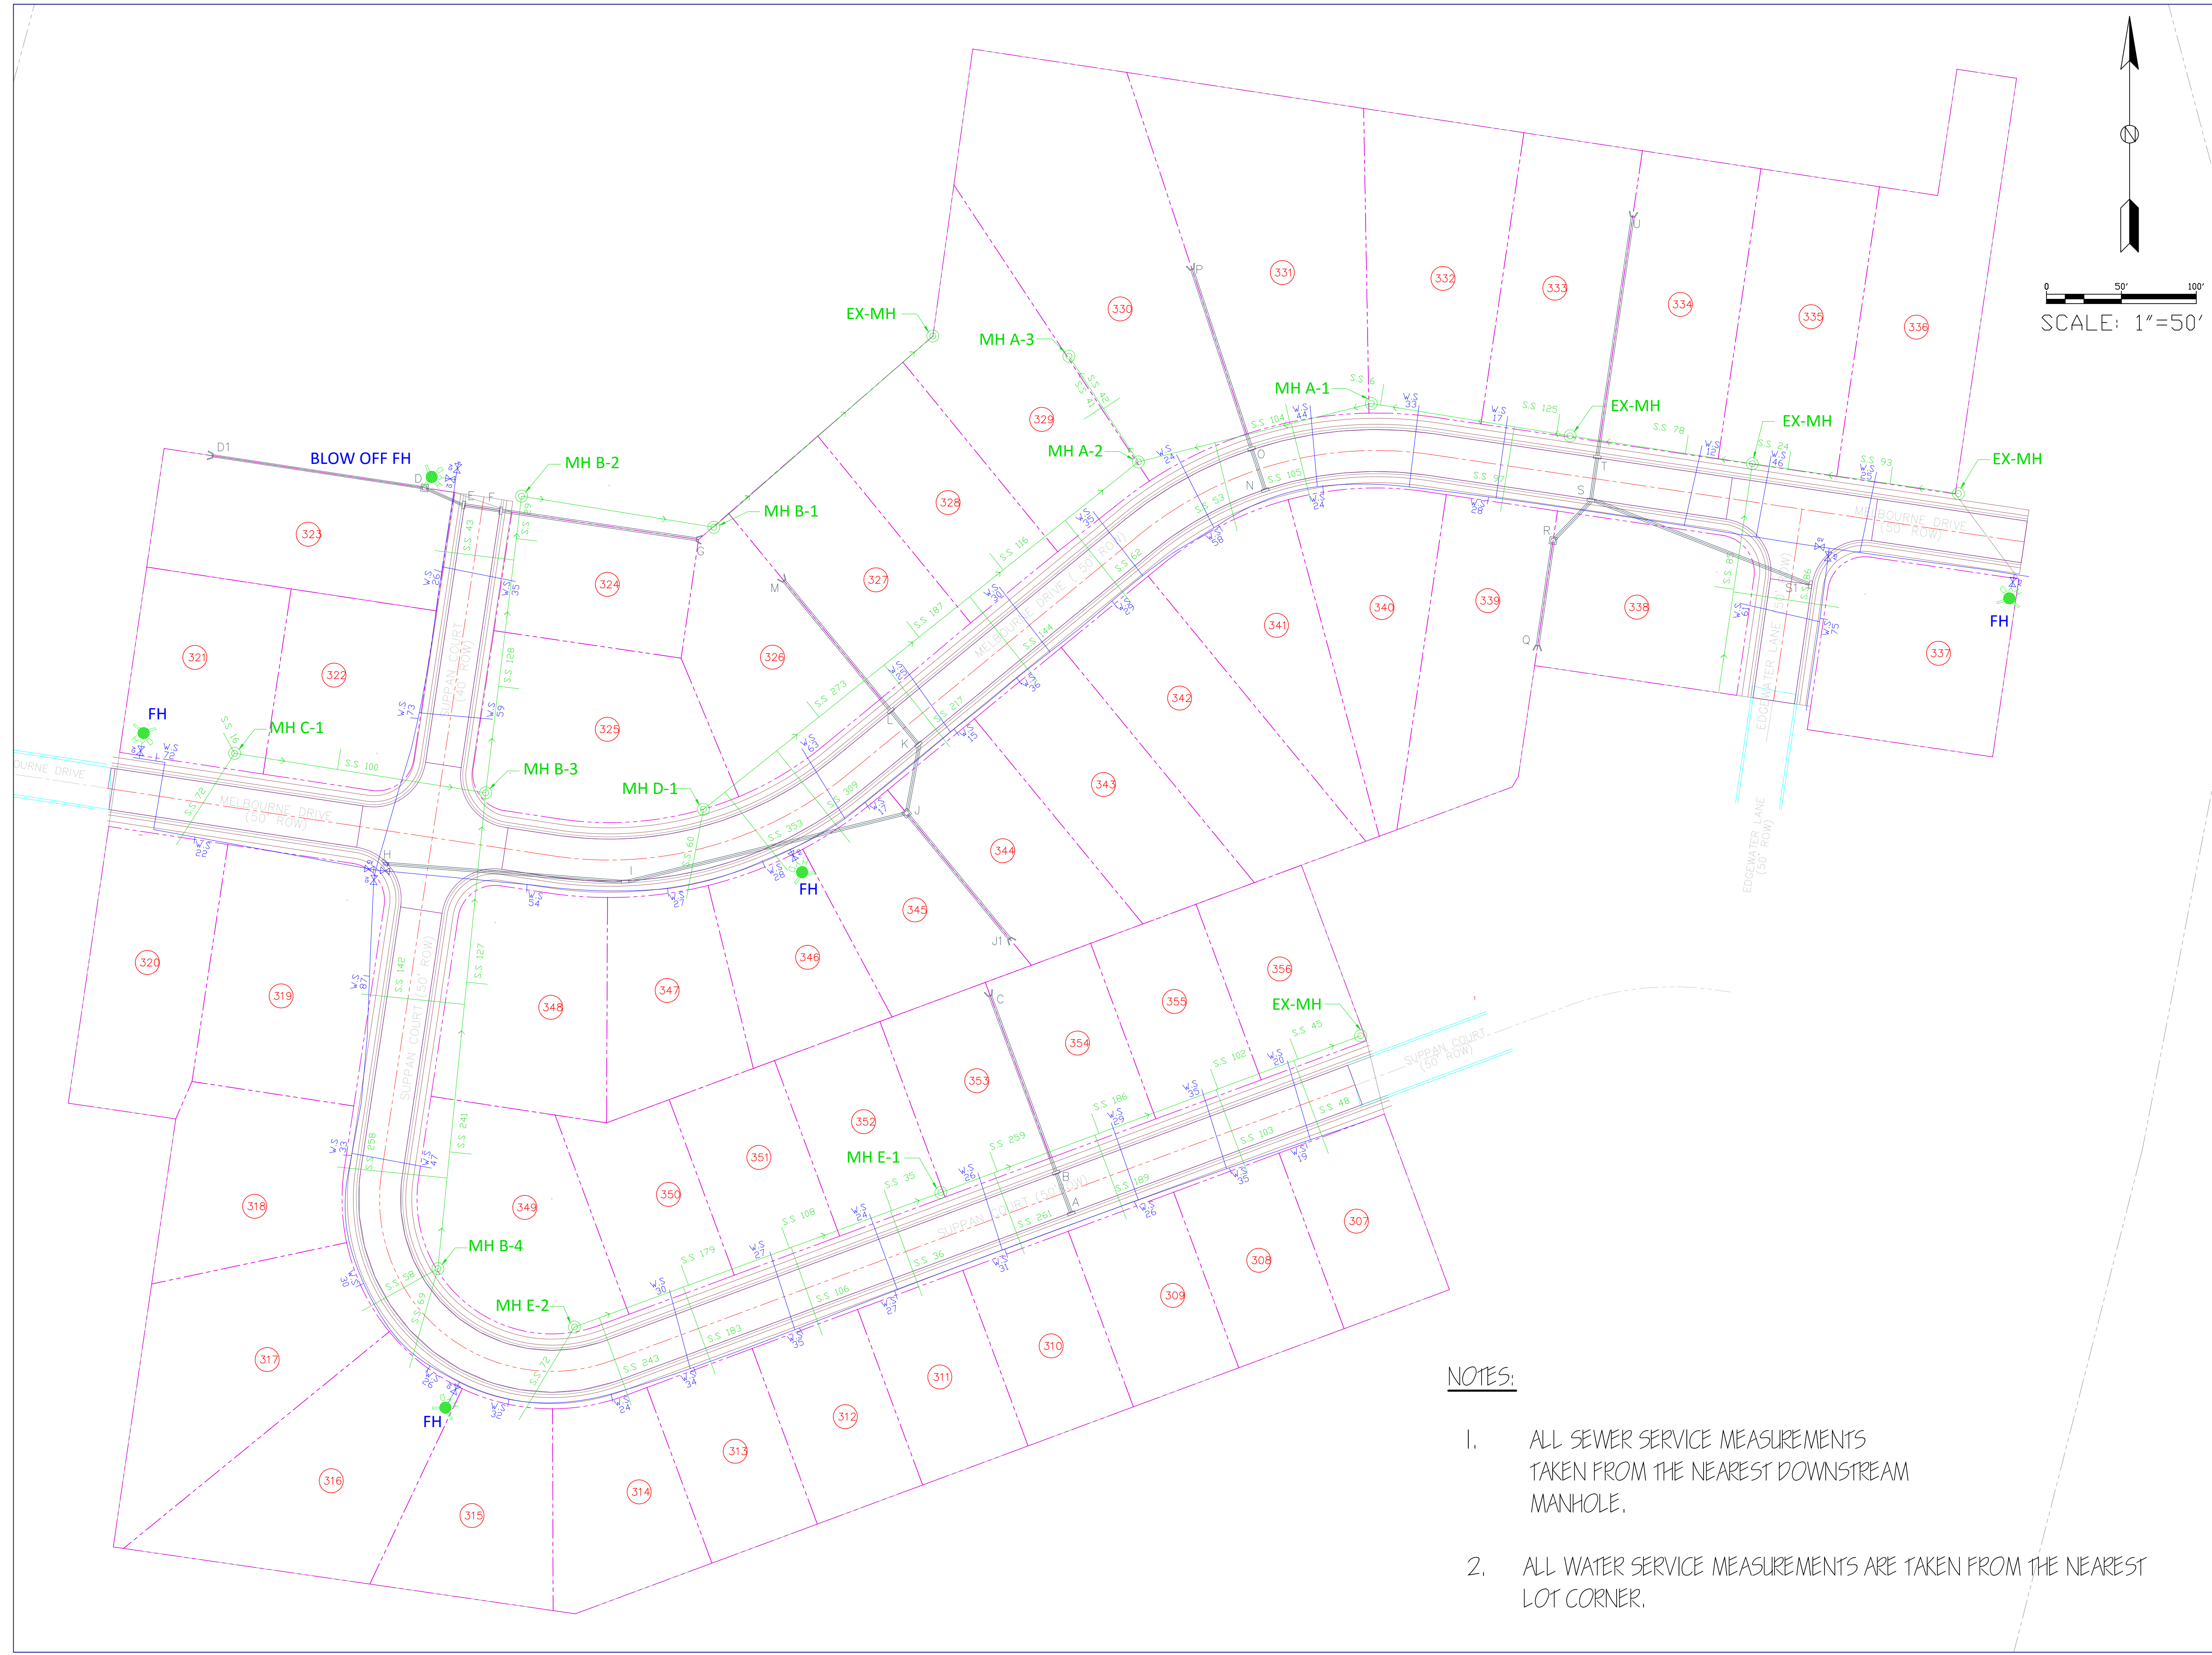

NOTES:

1. ALL SEWER SERVICE MEASUREMENTS TAKEN FROM THE NEAREST DOWNSTREAM MANHOLE.
2. ALL WATER SERVICE MEASUREMENTS ARE TAKEN FROM THE NEAREST LOT CORNER.

| No. | Revision/Issue | Date |
|-----|----------------|------|
|     |                |      |
|     |                |      |
| No. | Revision/Issue | Date |
|-----|----------------|------|
|     |                |      |

|                |         |
|----------------|---------|
| Project Name   | Sheet # |
| Date 1/29/2016 | AB-1    |
| Scale 1"=50'   |         |