


Graphic Scale 1" = 100'
 50 0 100
 All Sewer Structures pulled from the downstream Manhole

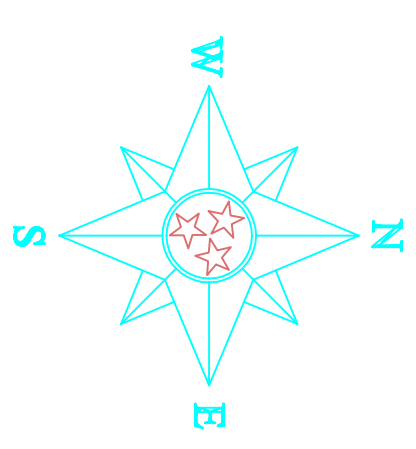

Franklin Meadows