


OAKLANDS PH 2 & 3

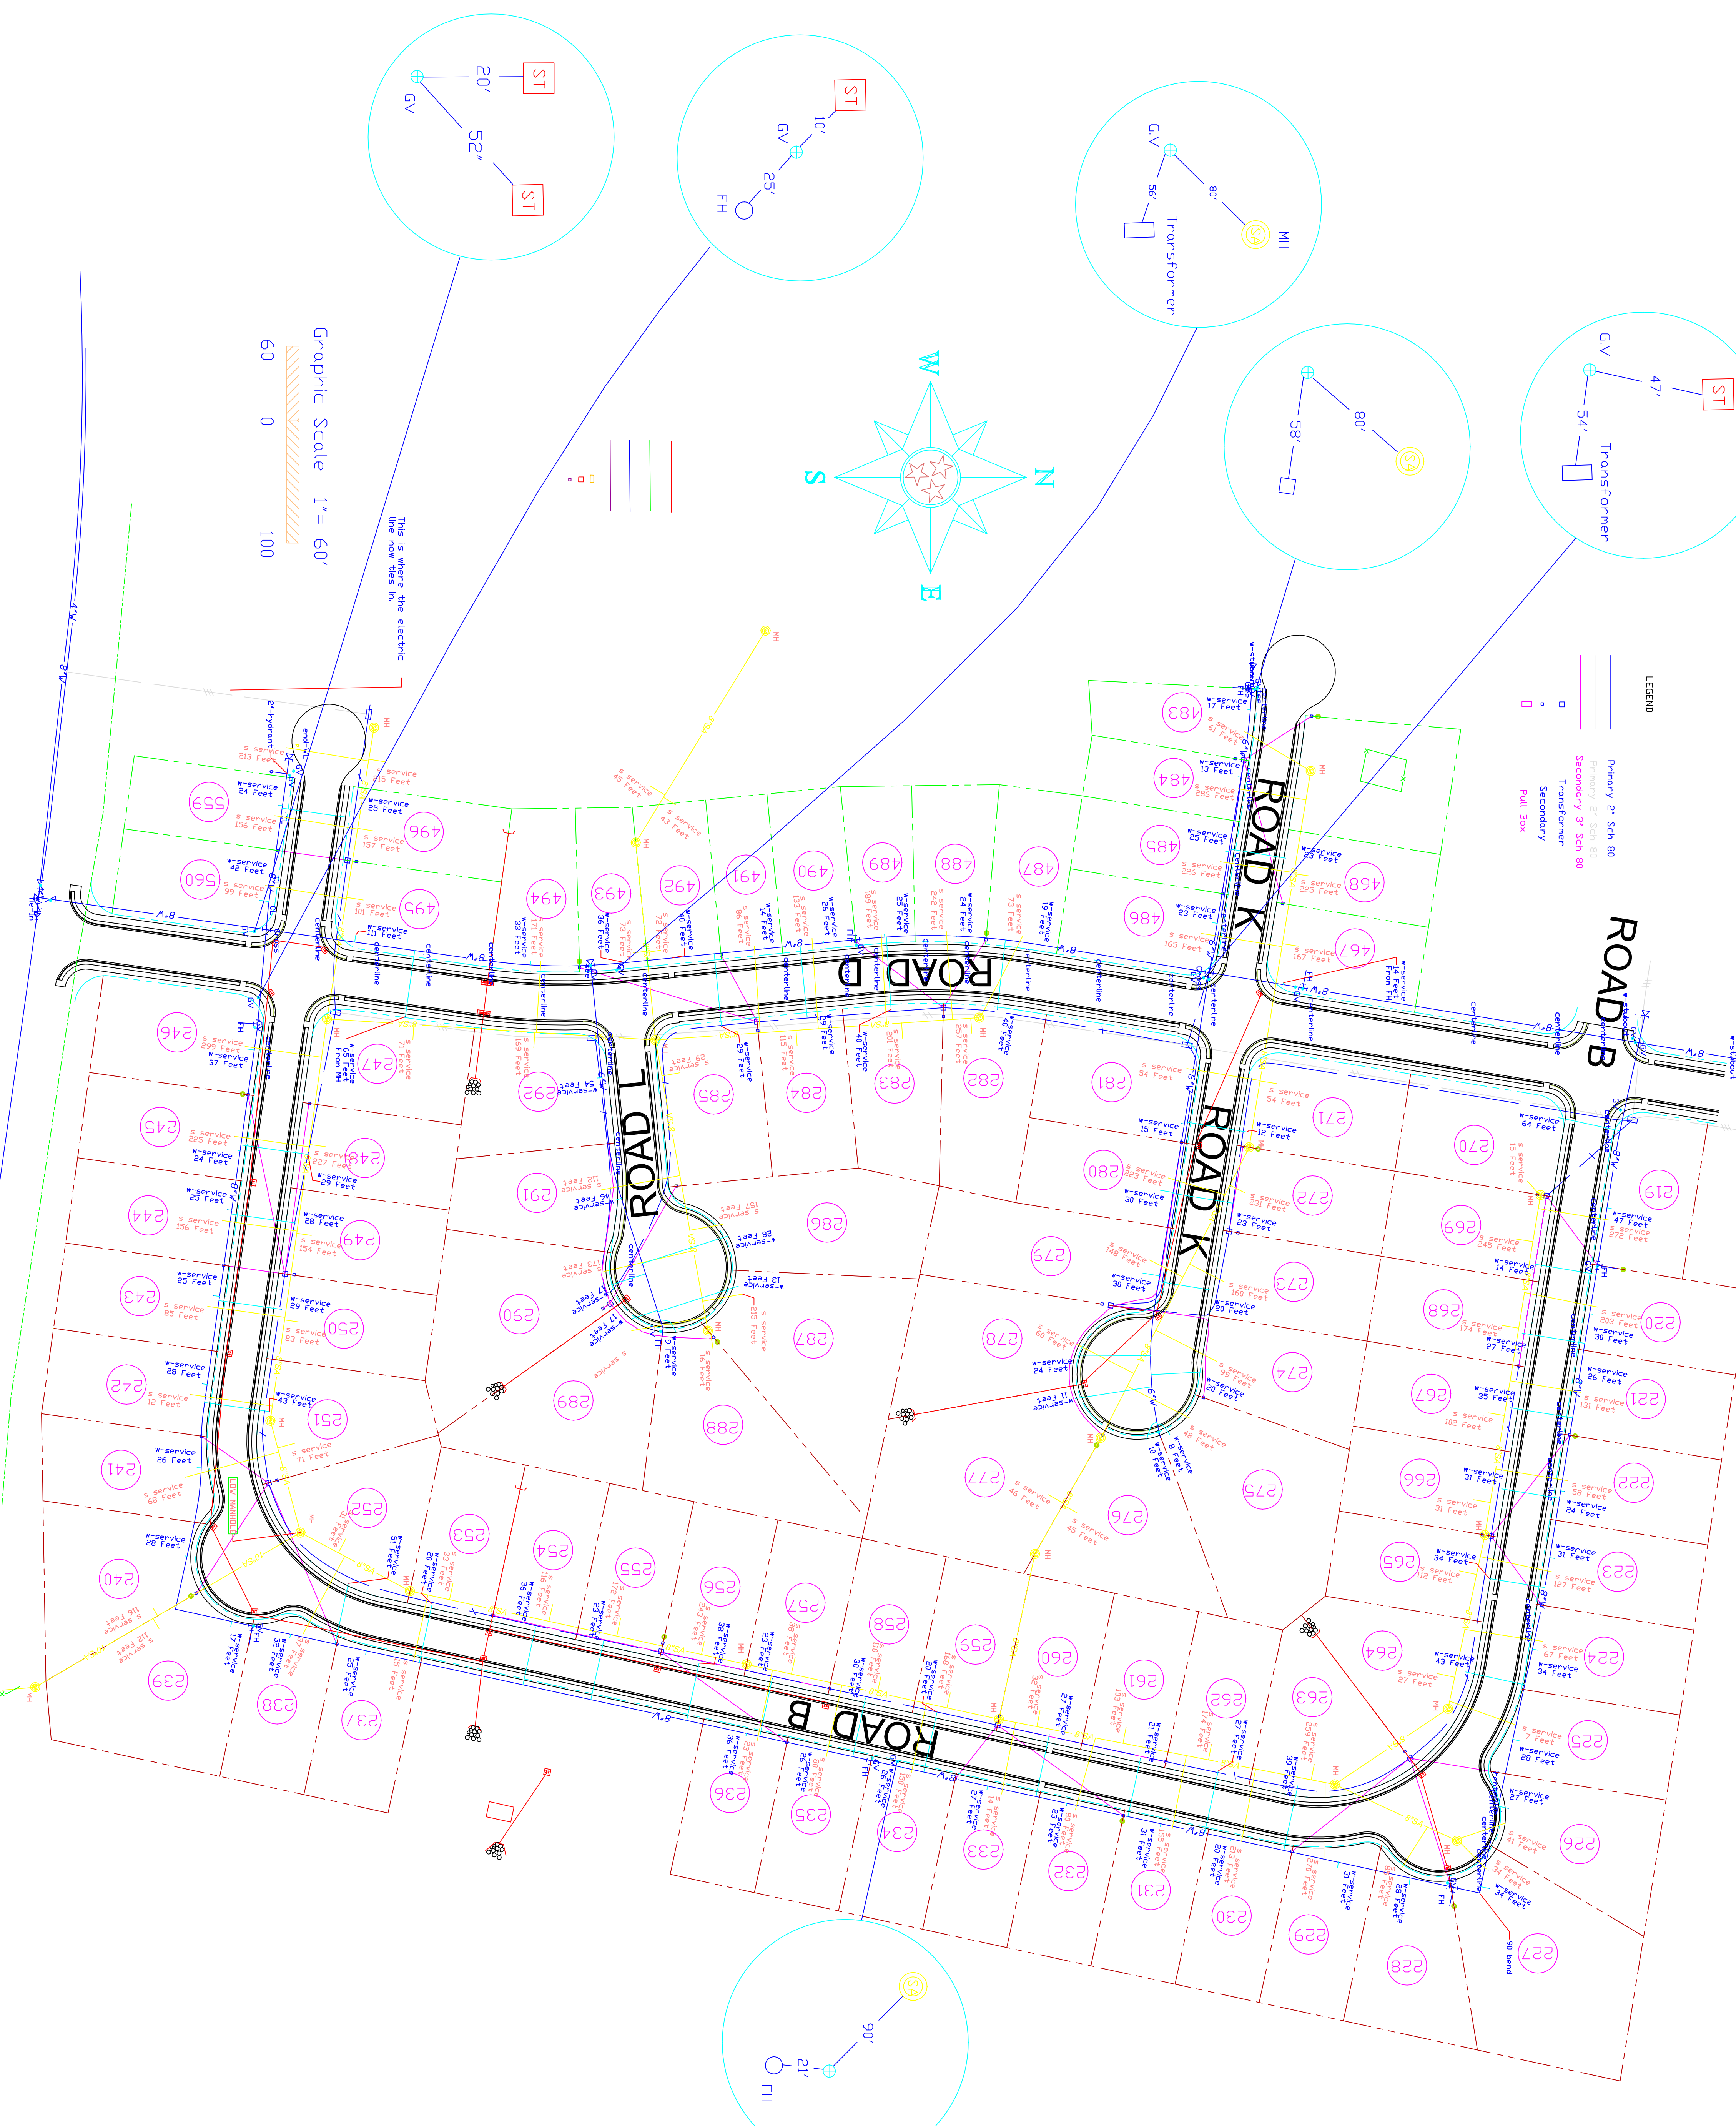

LEGEND

- Primary 2" Sch 80
- Primary 3" Sch 80
- Secondary
- Transformer
- Pull Box

Graphic Scale 1" = 60'

60 0 100

This is where the electric line now lies in.