
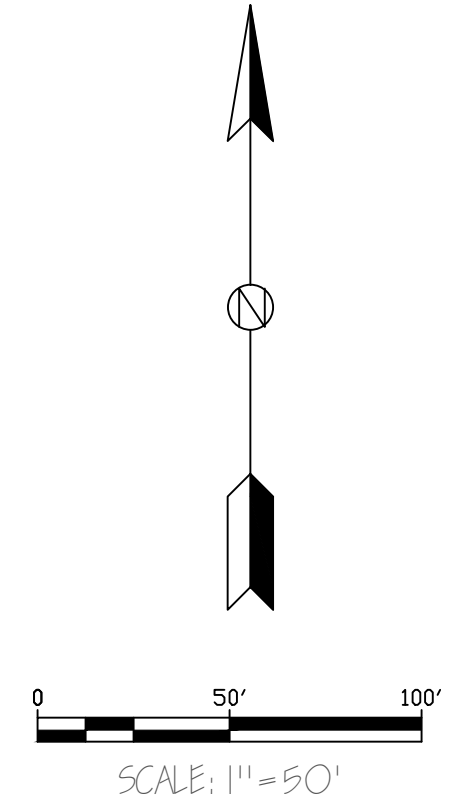



NOTES:

- 1. ALL SEWER SERVICE MEASUREMENTS ARE TAKEN FROM THE NEAREST DOWNSTREAM MANHOLE.
- 2. ALL WATER SERVICE MEASUREMENTS ARE TAKEN FROM THE NEAREST LOT CORNER.

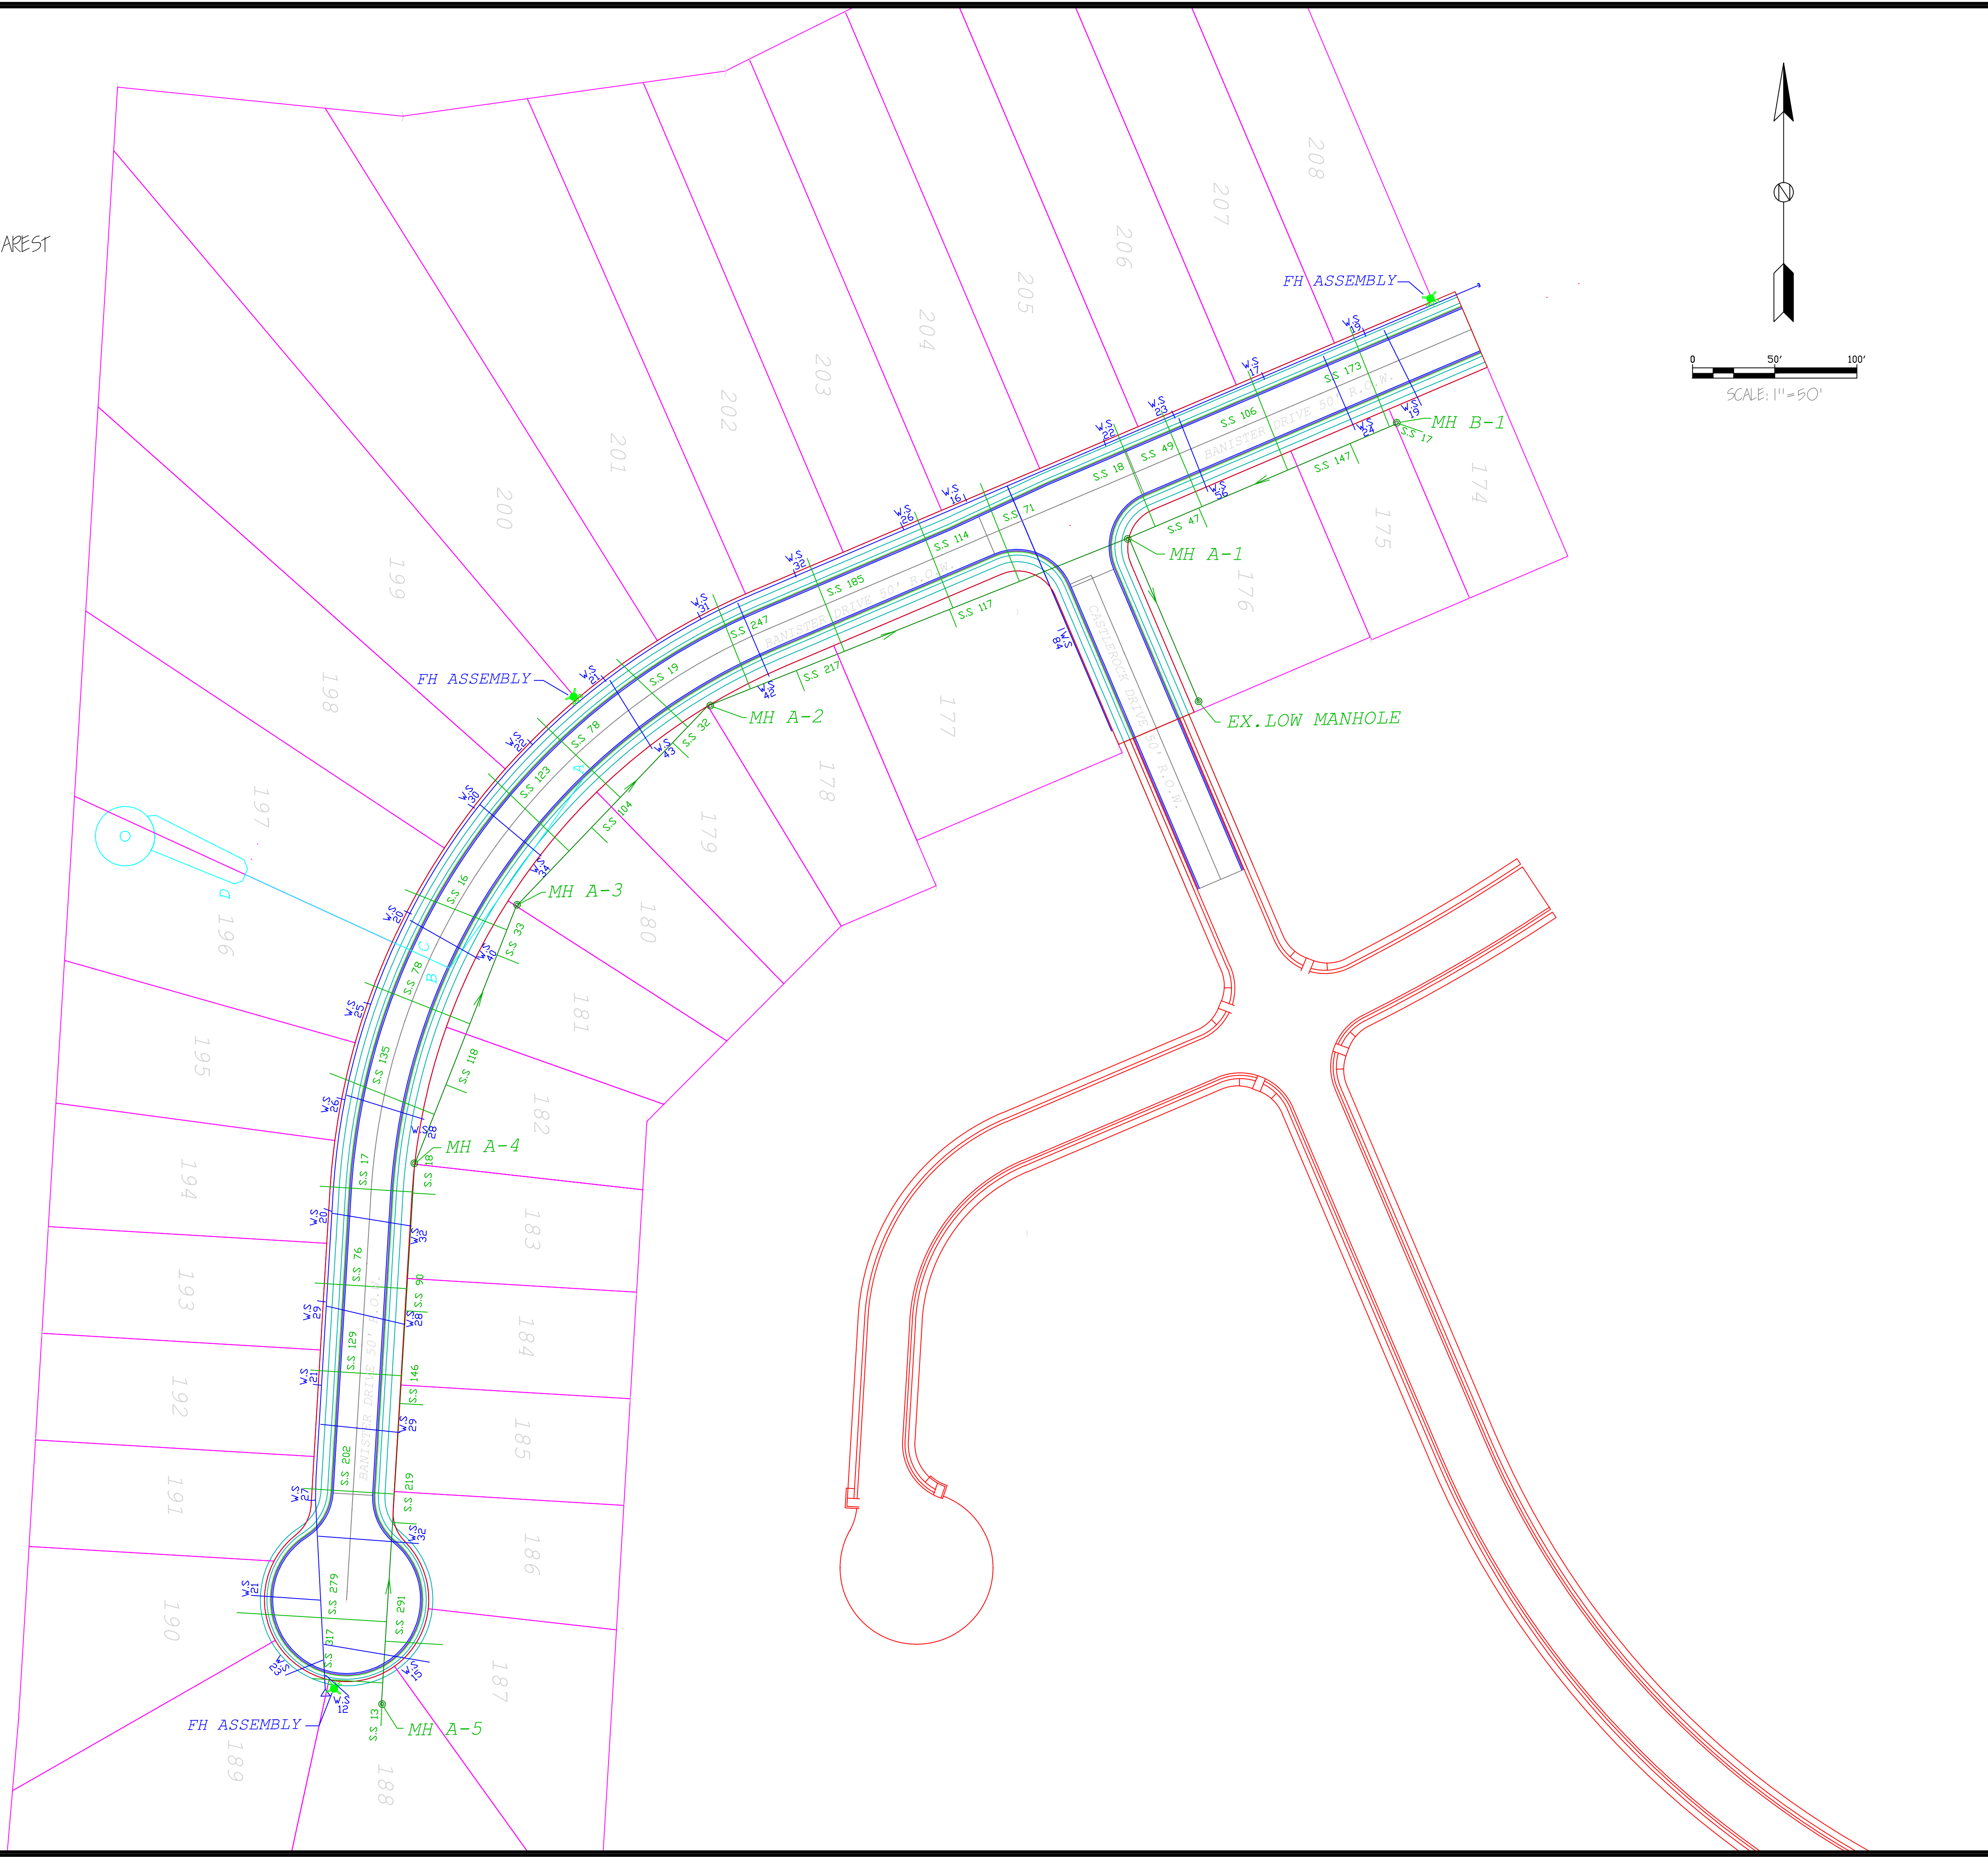

AS-BUILTS	RINGOLD ESTATES CLARKSVILLE, TENNESSEE
	
SCALE:	1" = 50'
DATE:	OCTOBER 2014
DESIGNED BY:	
FIELD INFO:	
DRAWN BY:	T. SWINK
CHECKED BY:	
QUALITY CHECK:	
APPROVED BY:	
REVISED:	
DWG:	RINGOLD EST.
PROJECT NO.:	
SHEET NO.:	AB-1