



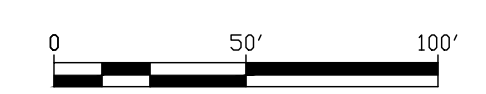

**NOTES:**

1. ALL SEWER SERVICE MEASUREMENTS TAKEN FROM THE NEAREST DOWNSTREAM MANHOLE.
2. ALL WATER SERVICE MEASUREMENTS ARE TAKEN FROM THE NEAREST LOT CORNER.

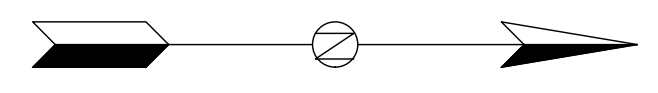

SCALE: 1"=50'

SCALE:	1"=50'
DATE:	12/28/2015
FIELD INFO:	
DRAWN BY:	
CHECKED BY:	
QUALITY CHECK:	
APPROVED BY:	
REVISED:	
DWG:	SUNSET MEADOWS 2
PROJECT NO.:	
SHEET NO.:	AB-1



AS-BUILTS  
 SUNSET MEADOWS 2  
 CLARKSVILLE, TENNESSEE