


WestCreek AS-BUILTS PH 1 12113.dwg

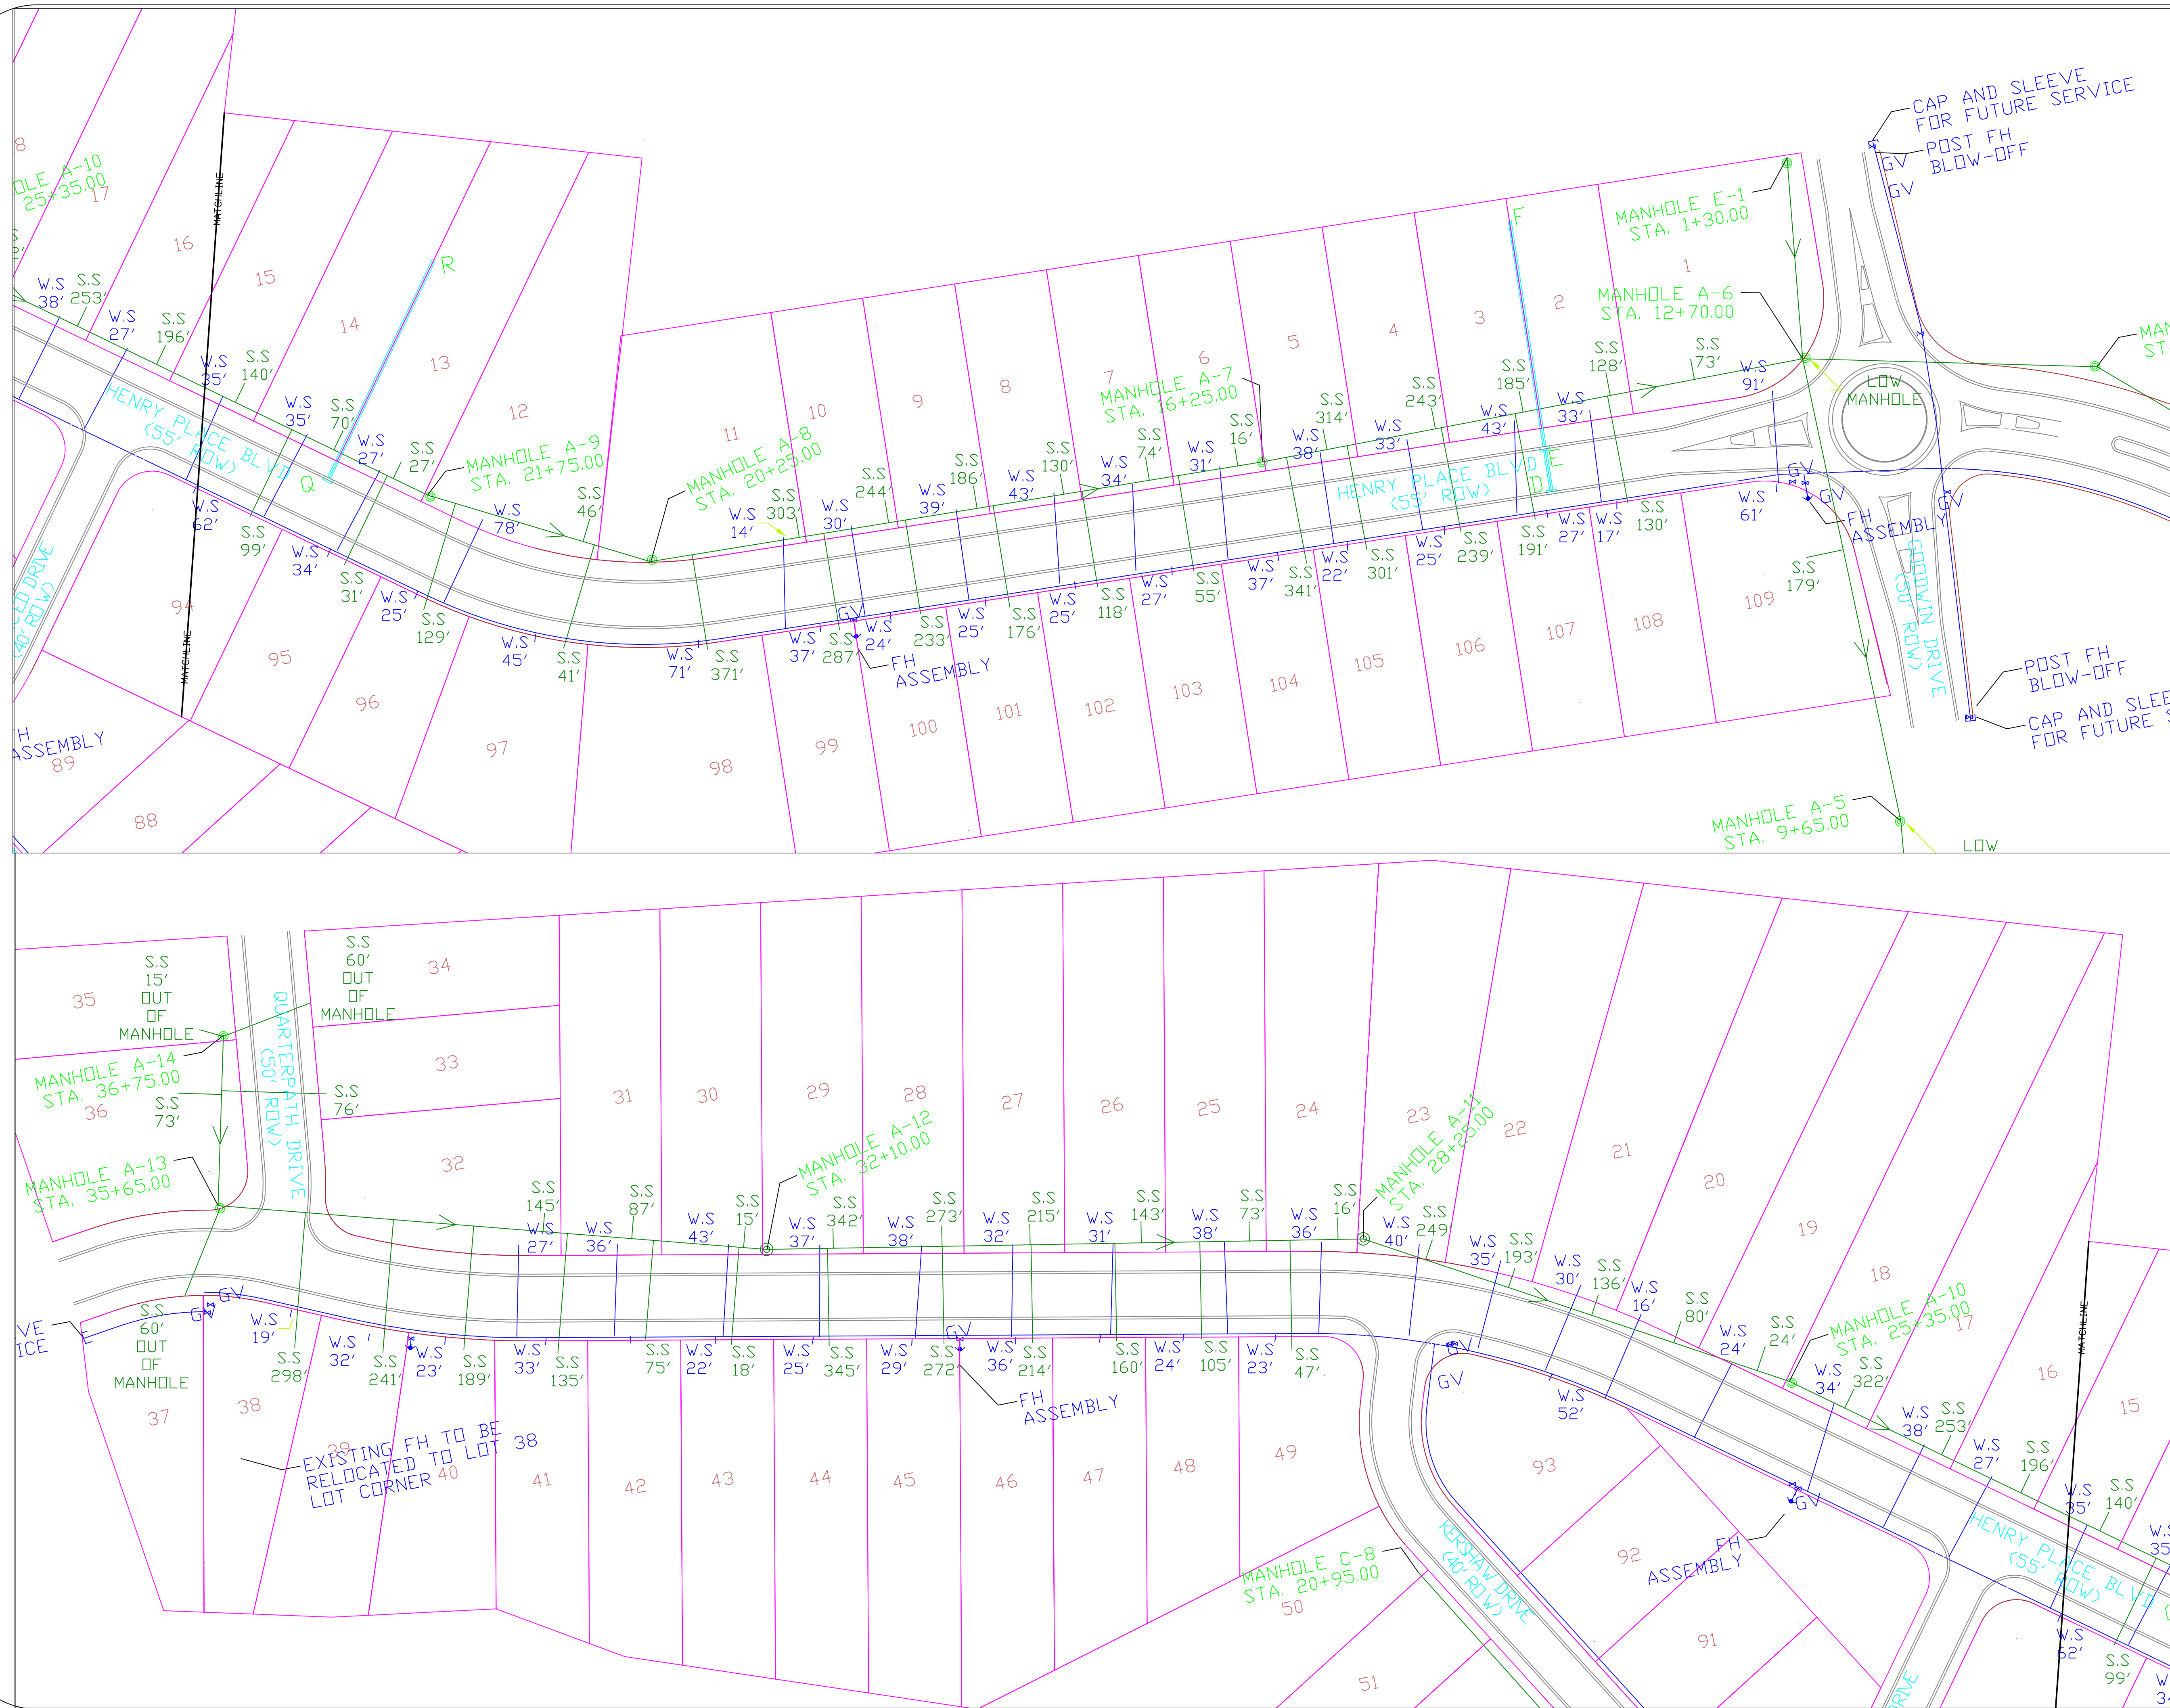

General Notes

All Sewer Service measurements are taken from the nearest downstream manhole.

All Water Service text is placed between the water service and the property corner used for the measurement.

Scale: 1" = 50'

No.	Revision/Issue	Date

Firm Name and Address

Project Name and Address

Westcreek
Utility As-BUILTS
Phase I-A

Project	Sheet
Date 1/22/2013	A-1
Scale 1" = 50'	