


NOTES:

1. ALL SEWER SERVICE MEASUREMENTS ARE TAKEN FROM THE NEAREST DOWNSTREAM MANHOLE.
2. ALL WATER SERVICE MEASUREMENTS ARE TAKEN FROM THE NEAREST LOT CORNER.

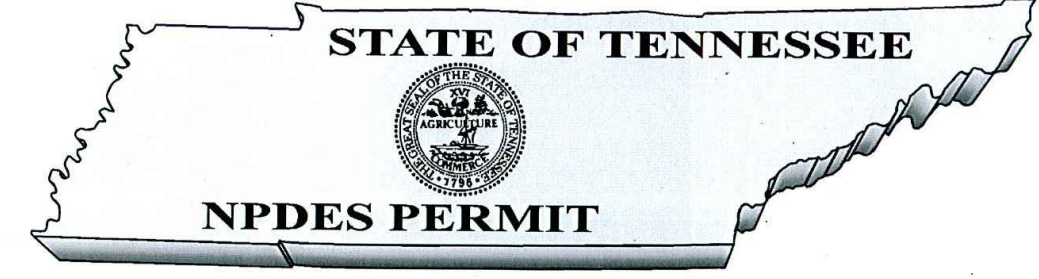

STATE OF TENNESSEE
NPDES PERMIT
 Tracking Number TNRI48828
NOTICE OF COVERAGE UNDER THE GENERAL NPDES PERMIT FOR STORMWATER DISCHARGES ASSOCIATED WITH CONSTRUCTION ACTIVITY (CGP)
 Tennessee Department of Environment and Conservation
 Division of Water Resources
 William R. Snodgrass Tennessee Tower
 312 Ross L. Parks Avenue, 11th Floor
 Nashville TN 37243

Under authority of the Tennessee Water Quality Control Act of 1977 (T.C.A. 69-3-101 et seq.) and the delegation of authority from the United States Environmental Protection Agency under the Federal Water Pollution Control Act, as amended by the Clean Water Act of 1977 (33 U.S.C. 1251, et seq.):

Name of the Construction Project: **West Creek Farms (24.32 acres)**
 Master Tracking Number at the Site: **TNRI48828**
 Permittee Name: **Durrett Management LLC**
 Contractor(s): **Byardt Construction**

is authorized to discharge: storm water associated with construction activity
 from site located at: **North of West Creek Coyote Trail and West of Peachers Mill, Montgomery County**
 to receiving waters named: **Little West Fork**
 in accordance with effluent limitations, monitoring requirements and other conditions set forth herein.

Likely presence of threatened or endangered species in one mile radius: **NO**
 Likely presence of threatened or endangered species downstream: **NO**

Additional pollution prevention requirements apply for discharges into waters which TDEC identifies as:
 a) impaired: **YES** b) discharging into Exceptional Tennessee Waters: **NO**

Your coverage under the CGP shall become effective on **October 22, 2013**, and shall be terminated upon receipt of **Notice of Termination**.

AS-BUILTS
WESTCREEK SEC 2
 CLARKSVILLE, TENNESSEE

SCALE: 1"=50'
 DATE: JAN, 2015
 DESIGNED BY:
 FIELD INFO:
 DRAWN BY:
 CHECKED BY:
 APPROVED BY:
 REVISIONS:
 DWG: WESTCREEK SEC 2
 PROJECT NO.:
 SHEET NO.: AB-1