


Graphic Scale 1"= 100'
50 0 100

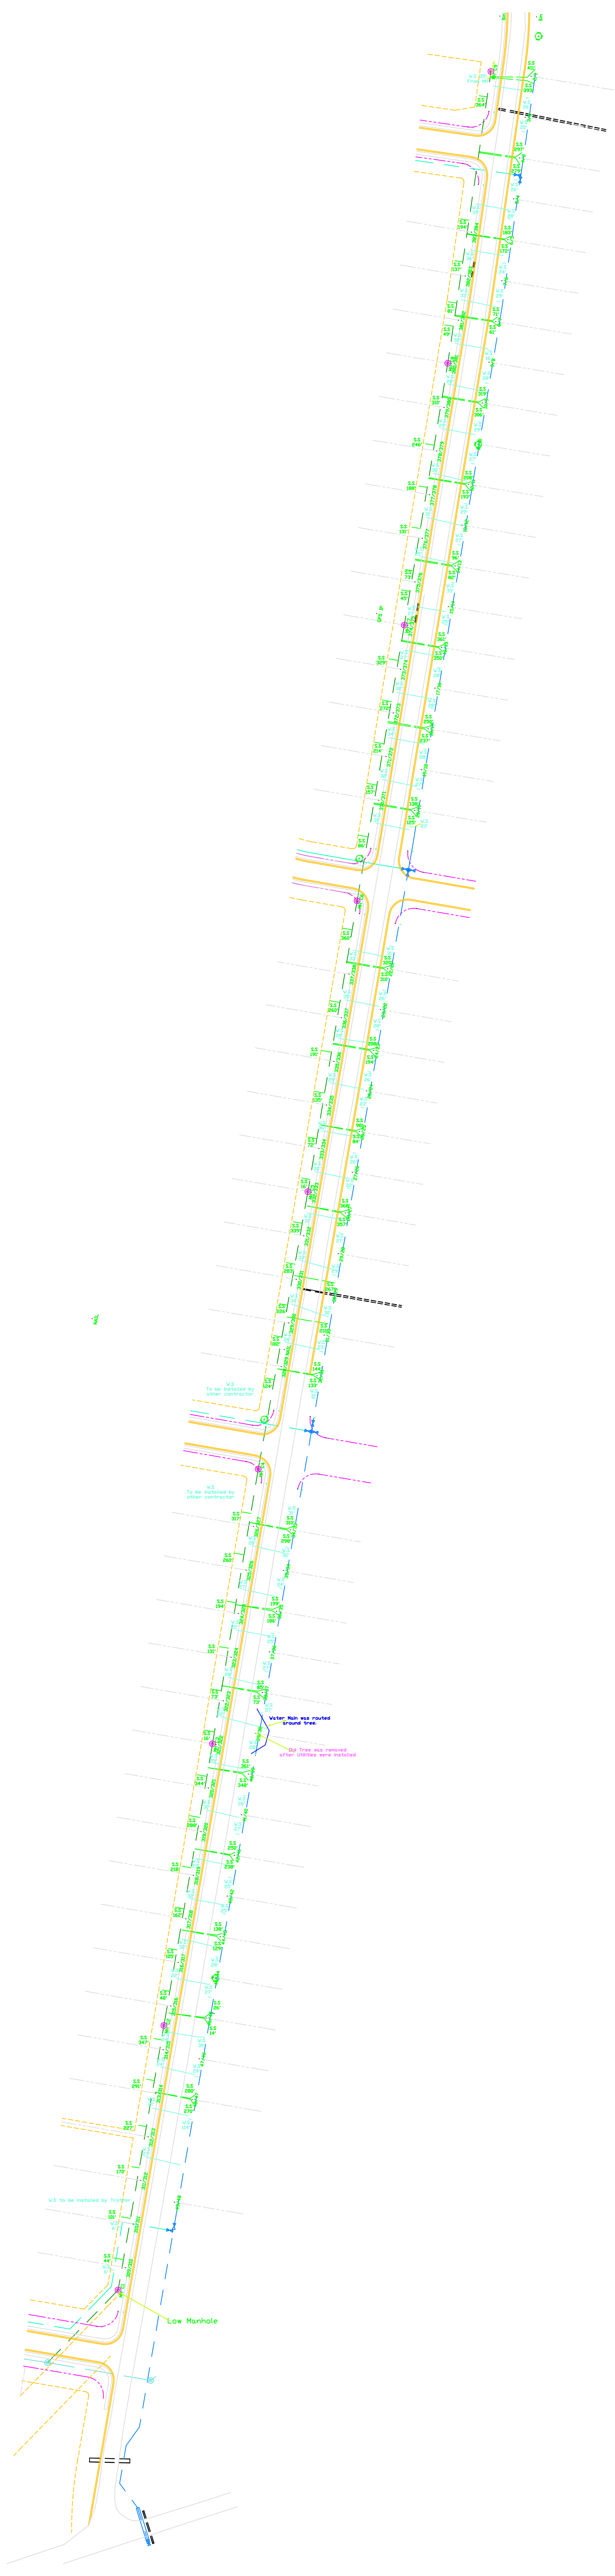

Crosswinds Sec 1B