


NOTES:

- 1. ALL SEWER SERVICE MEASUREMENTS TAKEN FROM THE NEAREST DOWNSTREAM MANHOLE.
- 2. ALL WATER SERVICE MEASUREMENTS ARE TAKEN FROM THE LOT CORNER NEAREST TO THE MEASUREMENT TEXT.

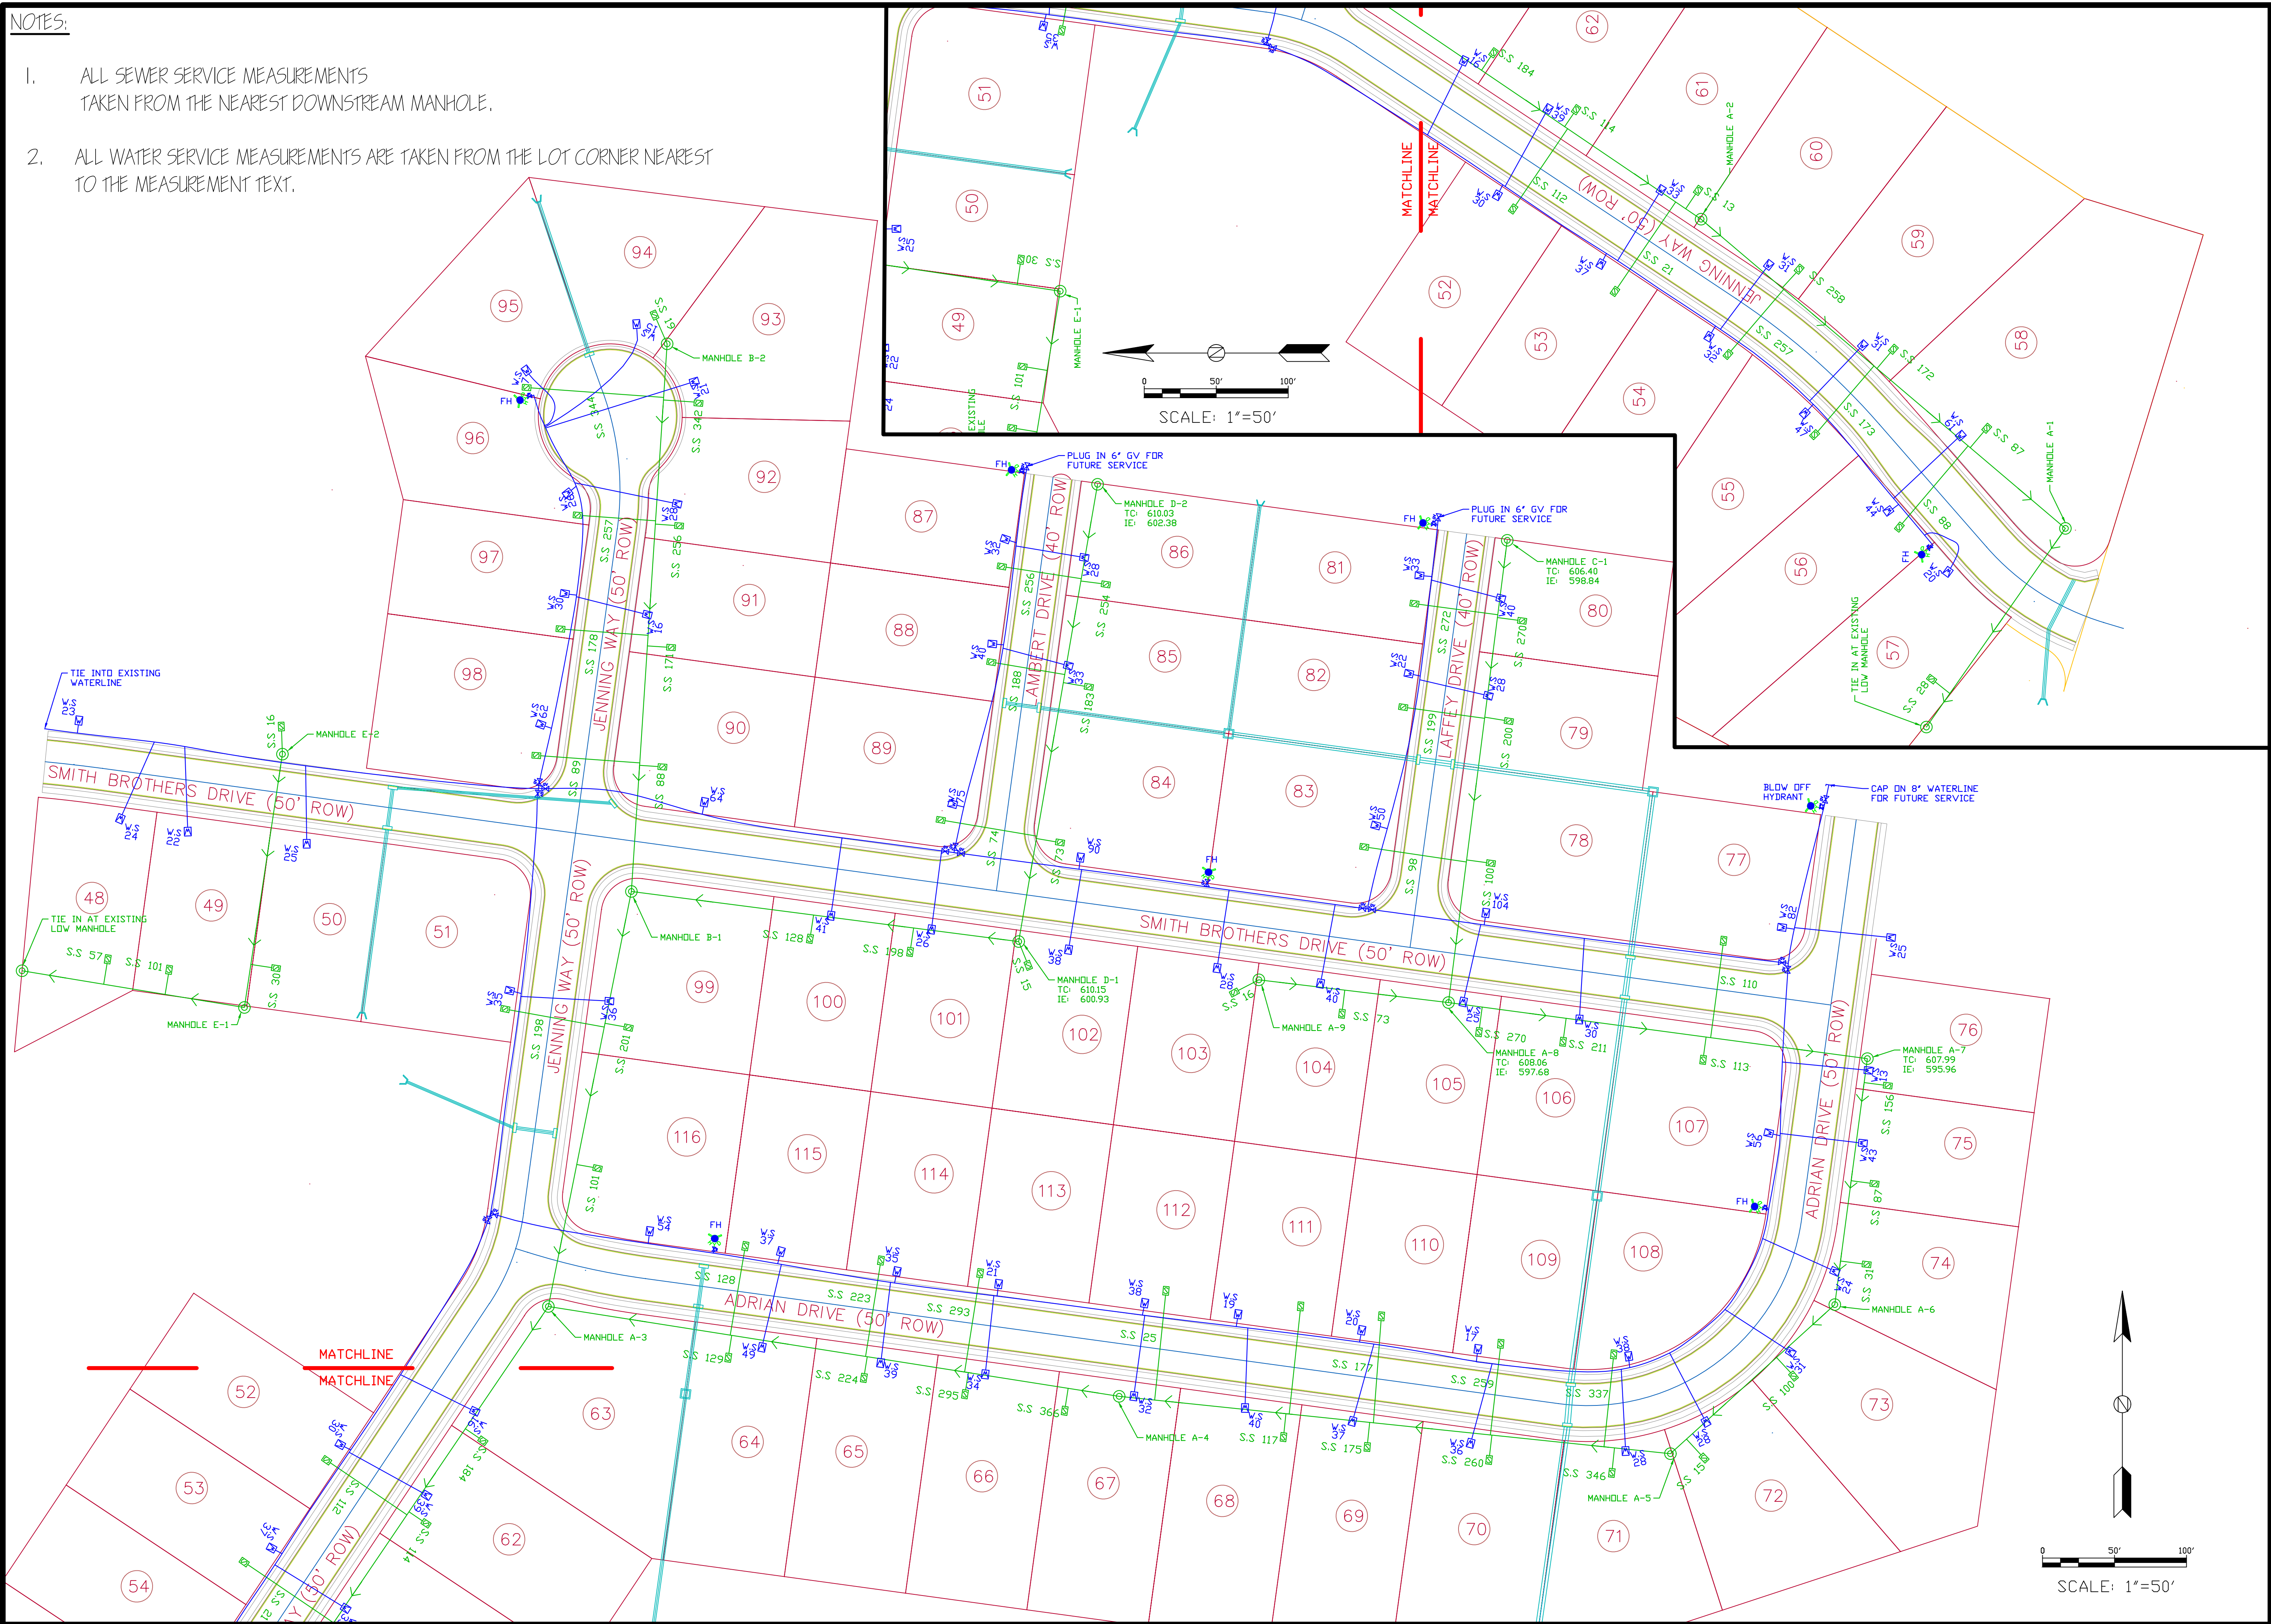

AS-BUILTS

EASTHAVEN 2  
CLARKSVILLE, TENNESSEE



SCALE:	1"=50'
DATE:	12/29/2016
DESIGNED BY:	
FIELD INFO:	
DRAWN BY:	
CHECKED BY:	
QUALITY CHECK:	
APPROVED BY:	
REVISED:	
DWG:	
PROJECT NO.:	
SHEET NO.:	AB-1