



AS BUILTS
SYCAMORE HILLS
CLARKSVILLE, TENNESSEE

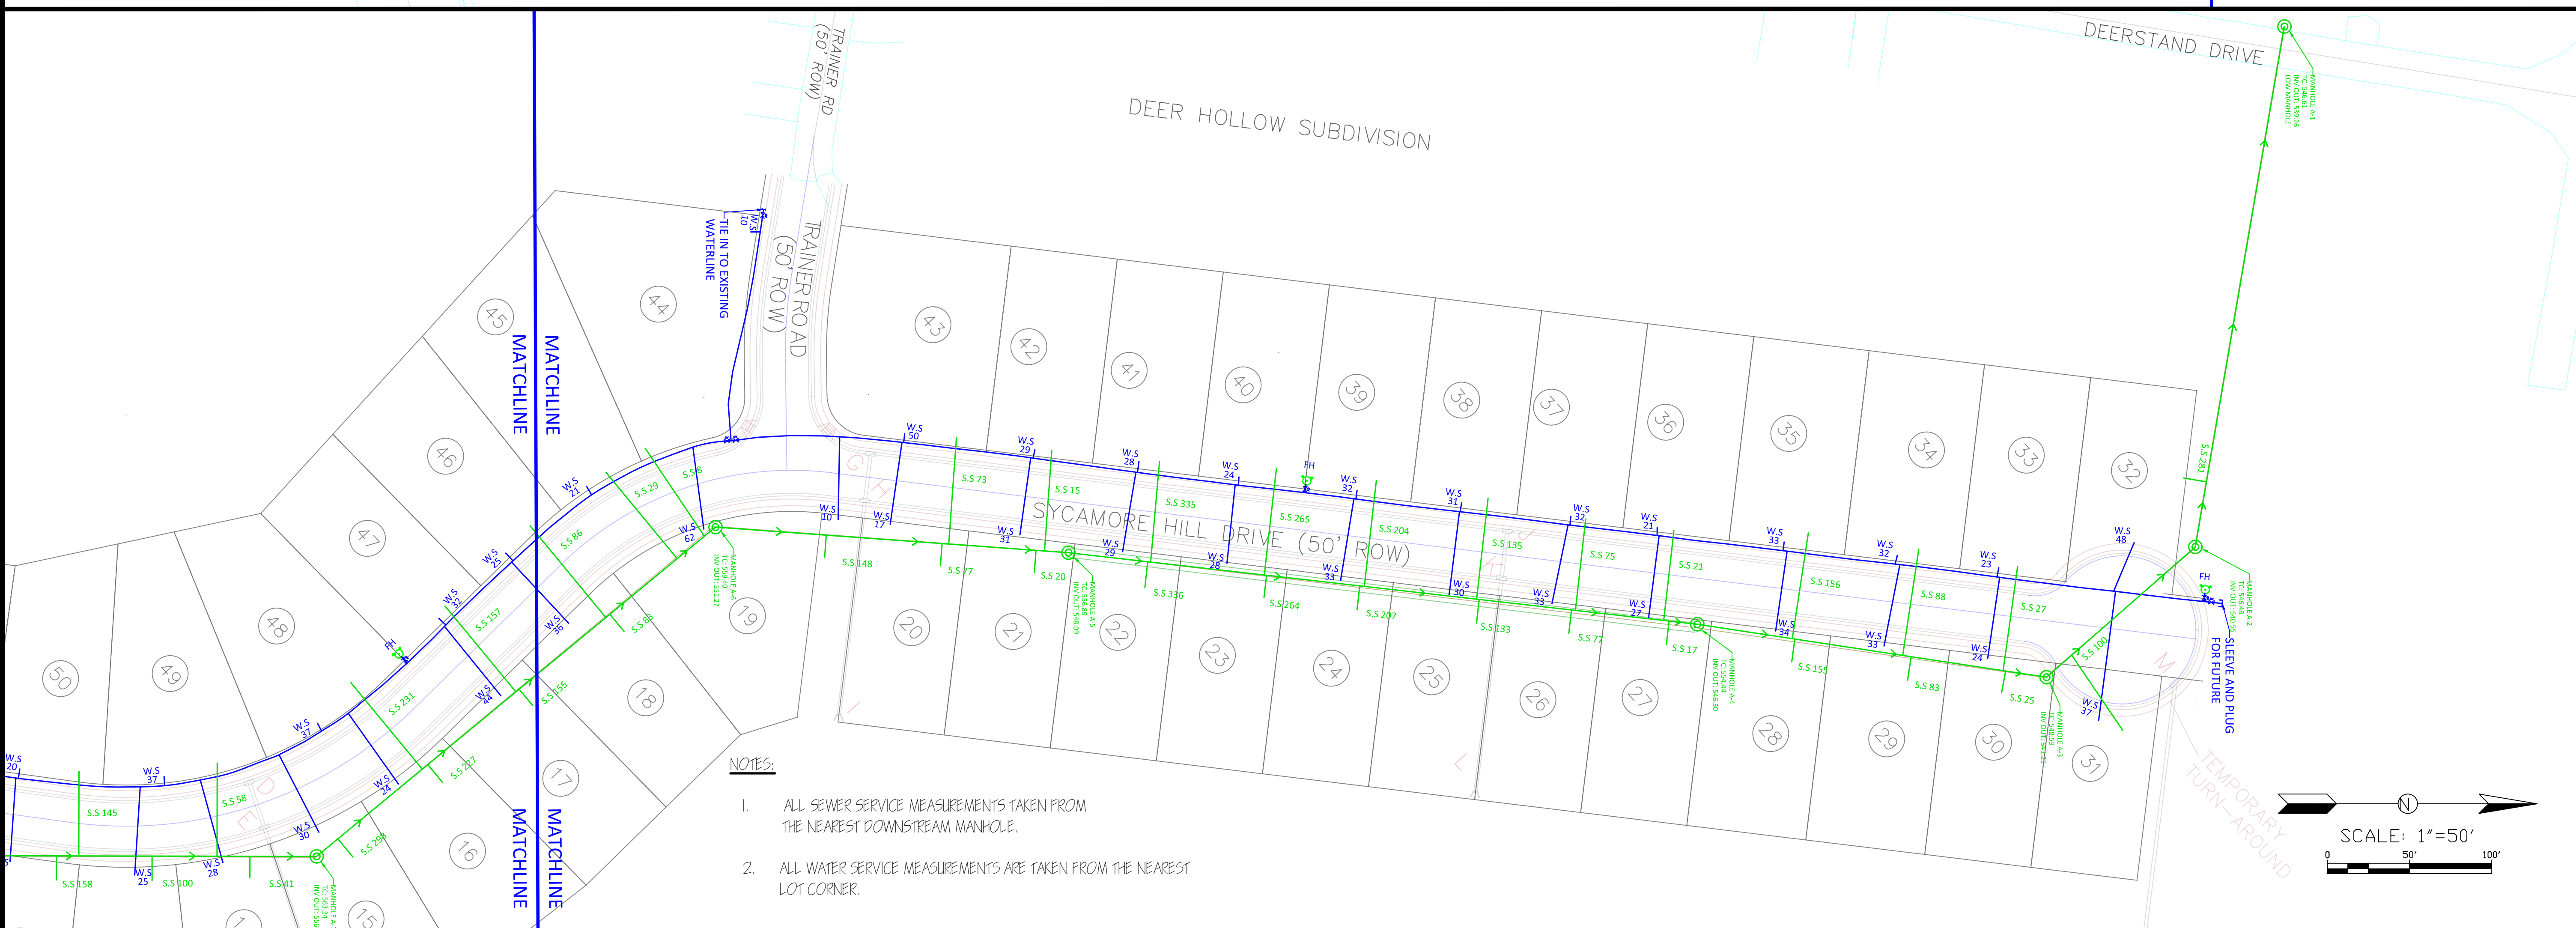

- NOTES:
1. ALL SEWER SERVICE MEASUREMENTS TAKEN FROM THE NEAREST DOWNSTREAM MANHOLE.
 2. ALL WATER SERVICE MEASUREMENTS ARE TAKEN FROM THE NEAREST LOT CORNER.

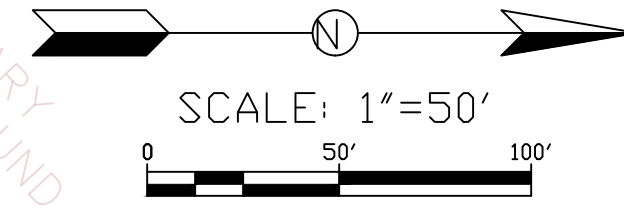

SCALE: 1"=50'
DATE: 07-28-2016
DESIGNED BY:
FIELD INFO:
DRAWN BY:
CHECKED BY:
QUALITY CHECK:
APPROVED BY:
REVISED:
DWG:
PROJECT NO.:
SHEET NO.: AB-1