


SCALE: 1"=50'

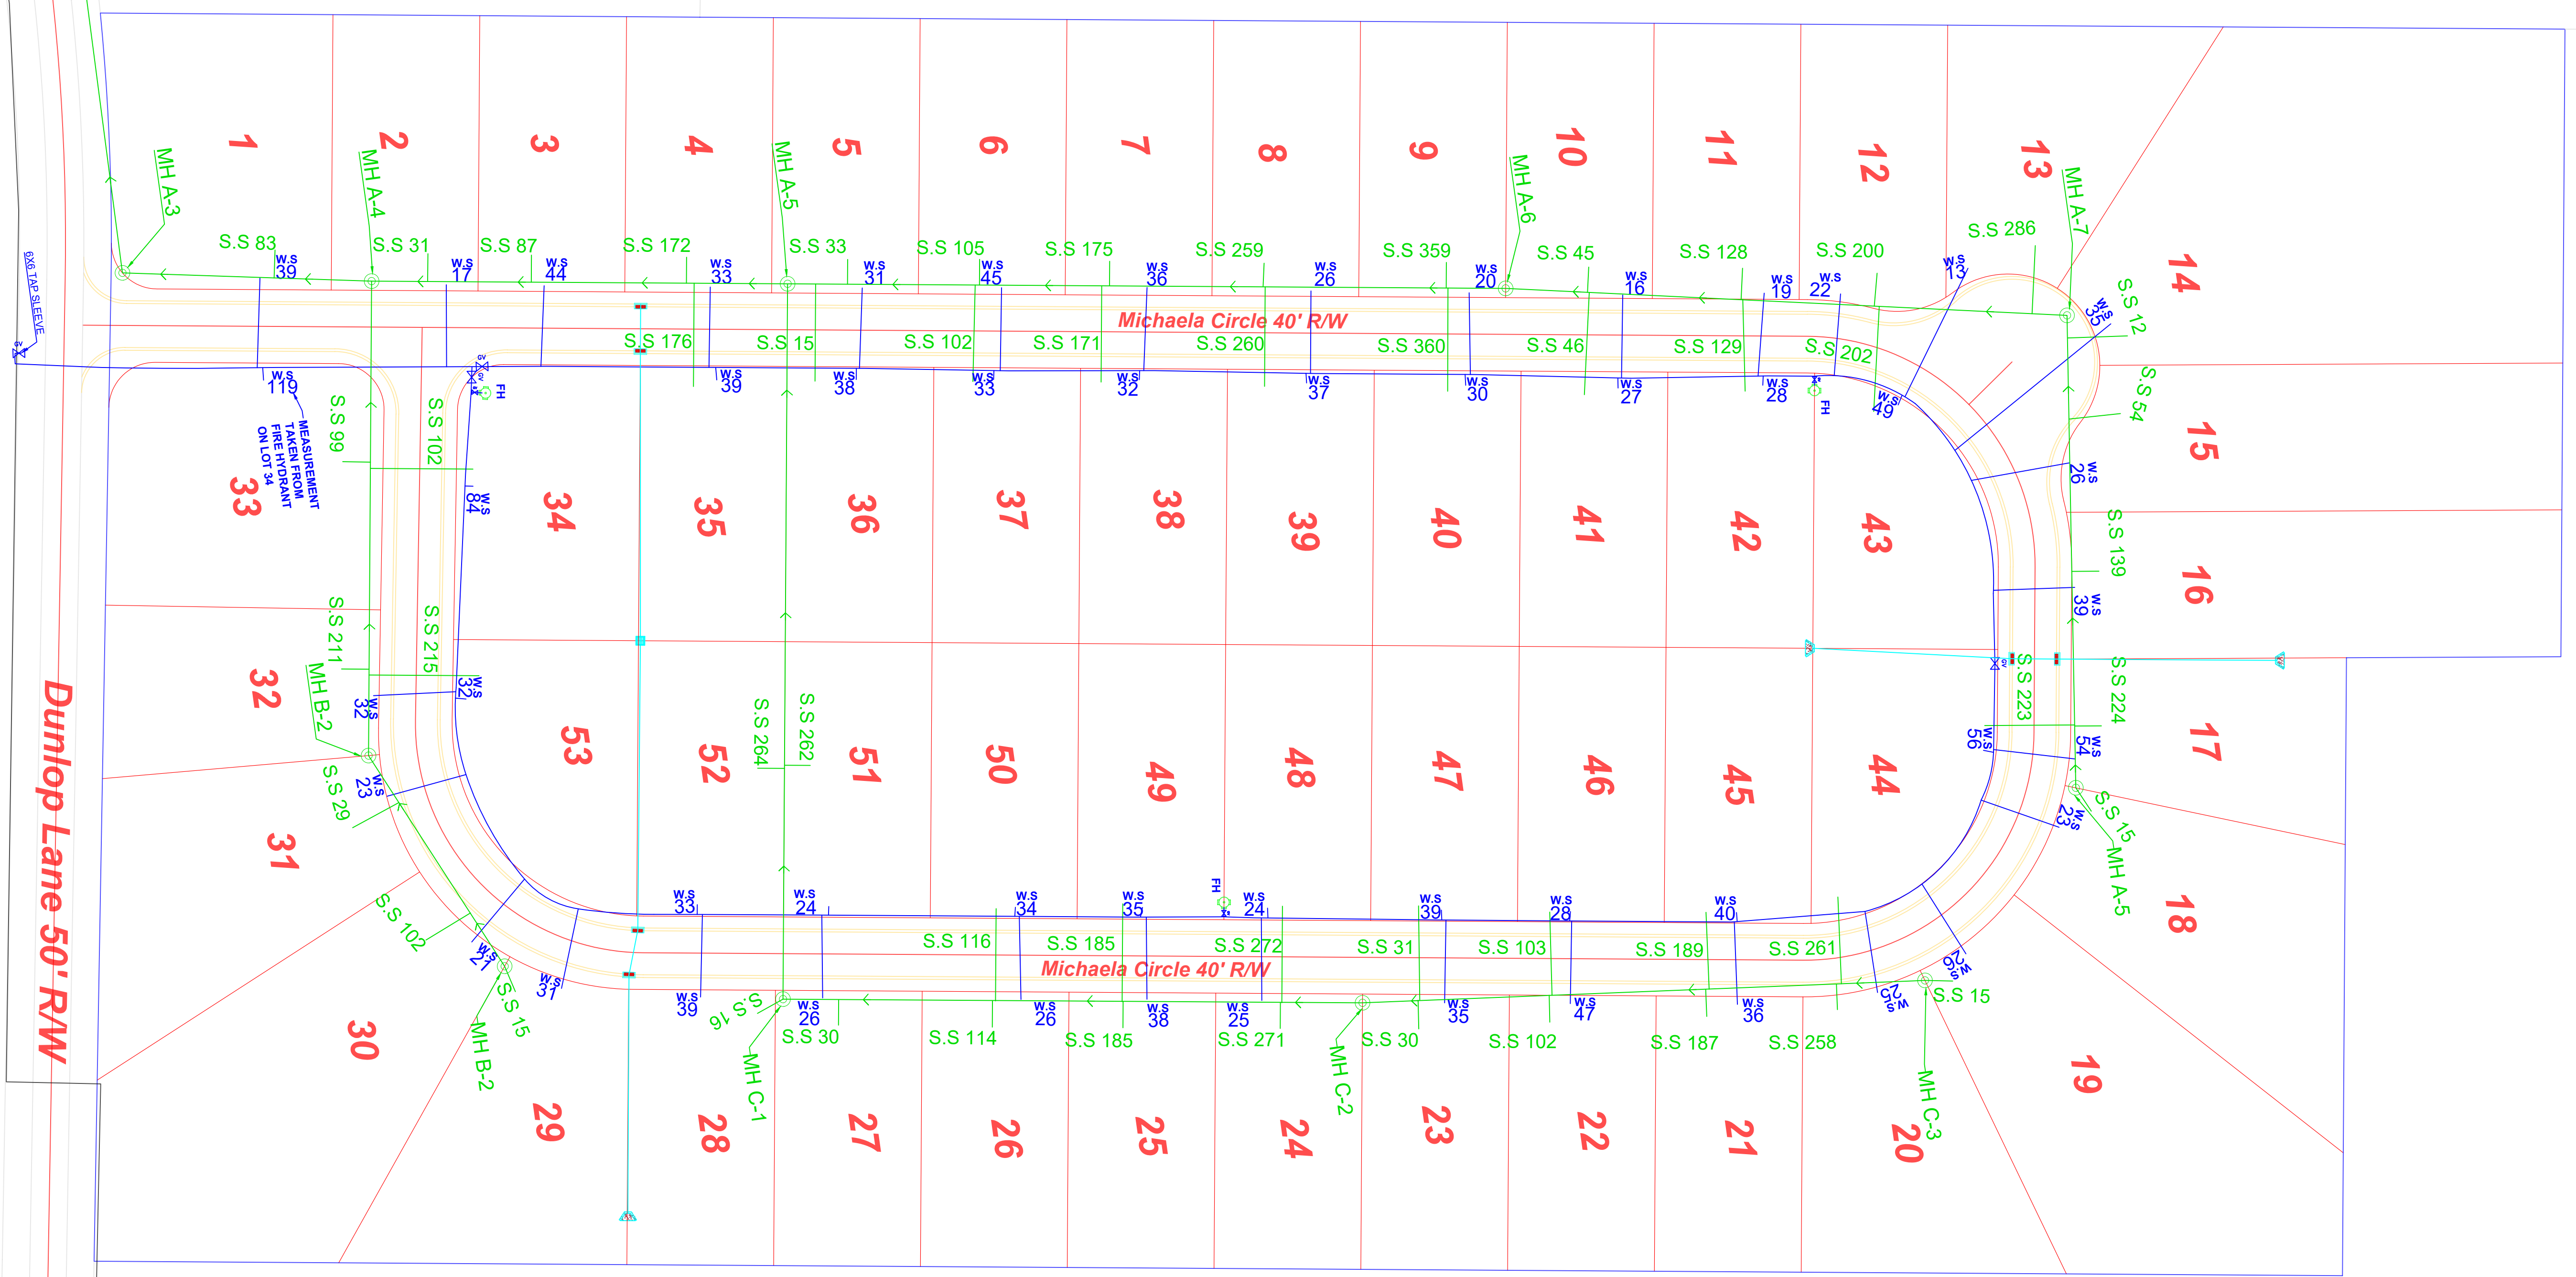

NOTES:

1. ALL SEWER SERVICE MEASUREMENTS TAKEN FROM THE NEAREST DOWNSTREAM MANHOLE.
2. ALL WATER SERVICE MEASUREMENTS ARE TAKEN FROM THE NEAREST LOT CORNER.

UTILITY AS-BUILTS

THE GROVE @ BEACHAVEN  
CLARKSVILLE, TENNESSEE



SCALE:	1"=50'
DATE:	APRIL 2016
DESIGNED BY:	
FIELD INFO:	
DRAWN BY:	
CHECKED BY:	
QUALITY CHECK:	
APPROVED BY:	
REVISED:	
DWG:	
PROJECT NO.:	
SHEET NO.:	AD-1