
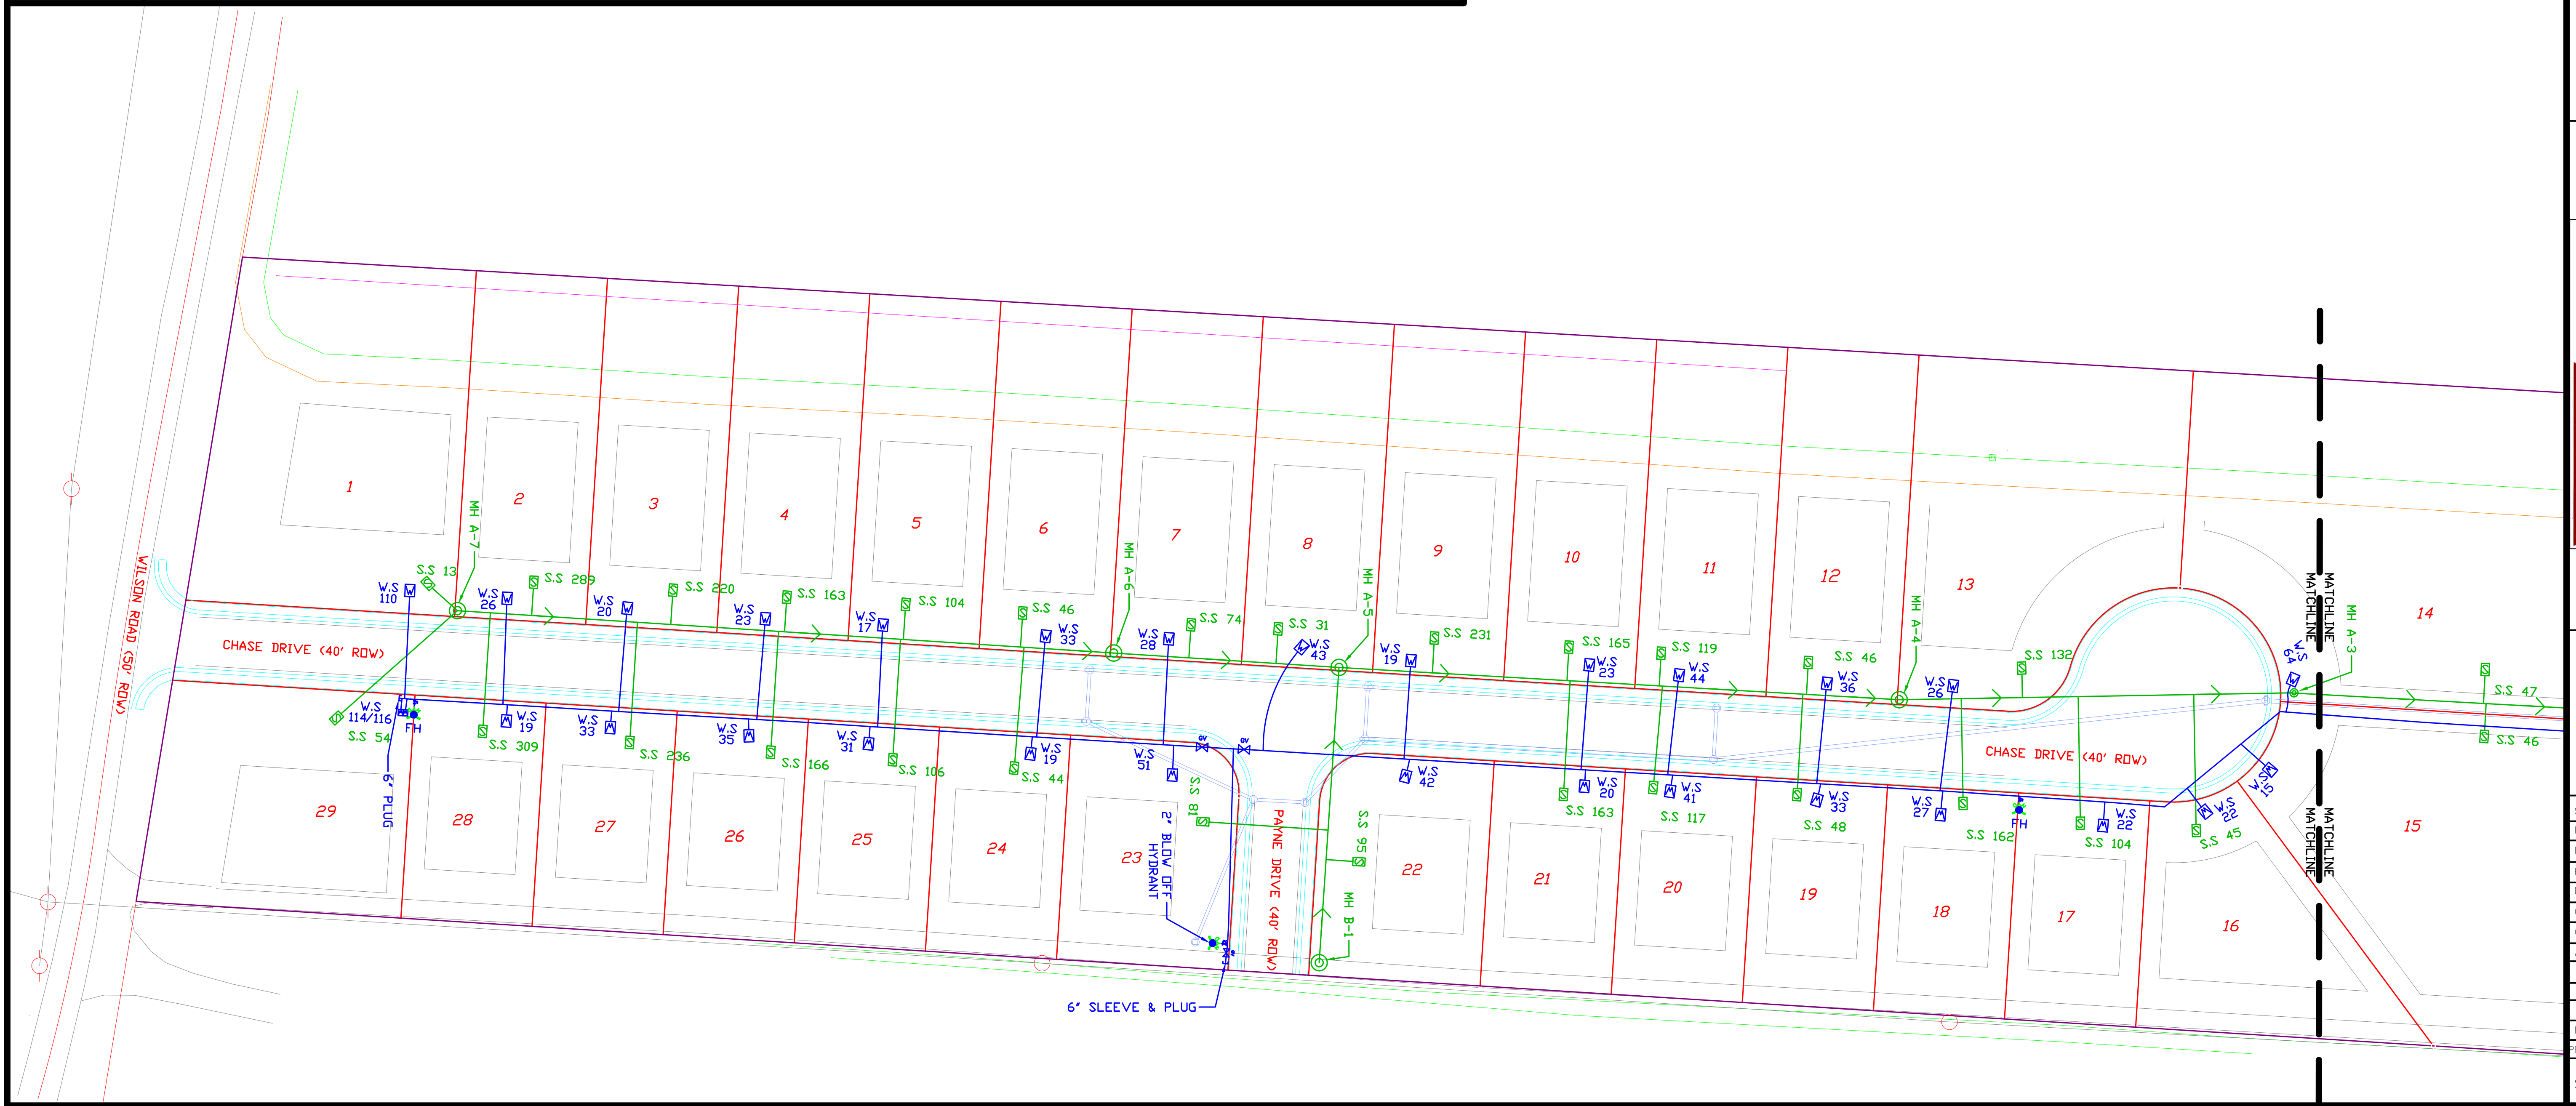


NOTES:

1. ALL SEWER SERVICE MEASUREMENTS TAKEN FROM THE NEAREST DOWNSTREAM MANHOLE.
2. ALL WATER SERVICE MEASUREMENTS ARE TAKEN FROM THE LOT CORNER NEAREST TO THE MEASUREMENT TEXT.
3. LOT #1 HAS A 1" WATER SERVICE, REMAINDER HAVE STANDARD 3/4" WATER SERVICES.

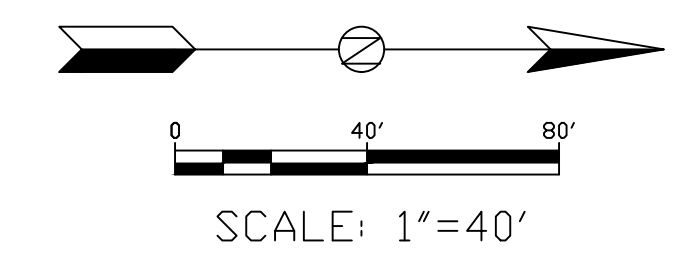

SCALE:	SCALE: 1"=40'
DATE:	4-26-2017
DESIGNED BY:	
FIELD INFO:	
DRAWN BY:	
CHECKED BY:	
QUALITY CHECK:	
APPROVED BY:	
REVISED:	
DWG:	
PROJECT NO.:	
SHEET NO.:	AB-1

AS-BUILTS
 ALLEN CHASE
 CLARKSVILLE, TENNESSEE