
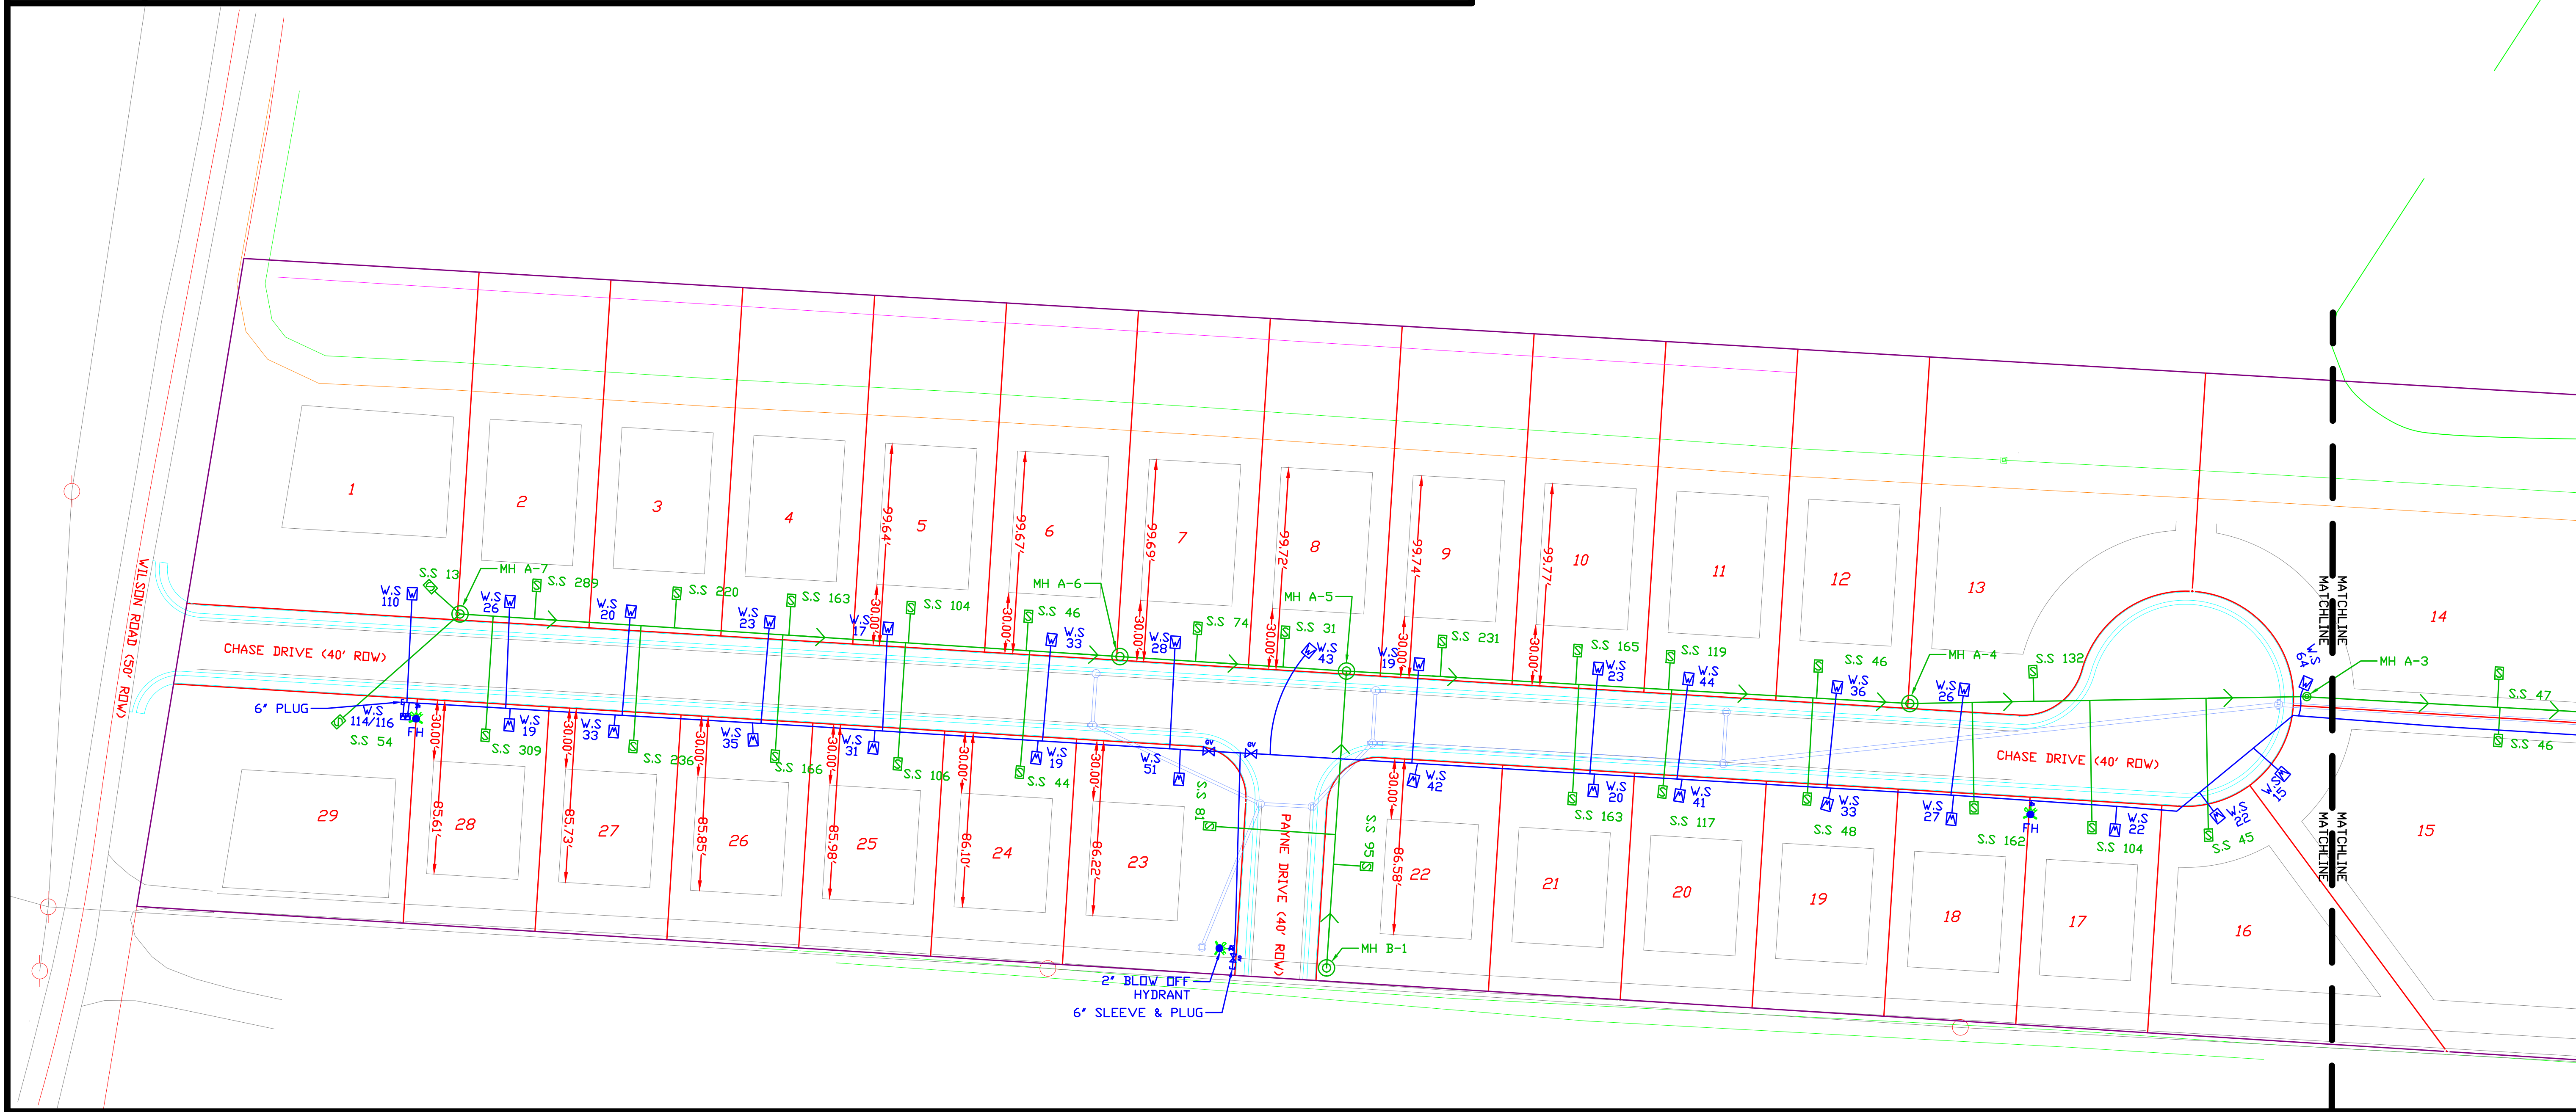


**NOTES:**

1. ALL SEWER SERVICE MEASUREMENTS TAKEN FROM THE NEAREST DOWNSTREAM MANHOLE.
2. ALL WATER SERVICE MEASUREMENTS ARE TAKEN FROM THE LOT CORNER NEAREST TO THE MEASUREMENT TEXT.
3. LOT #1 HAS A 1" WATER SERVICE, REMAINDER HAVE STANDARD 3/4" WATER SERVICES.

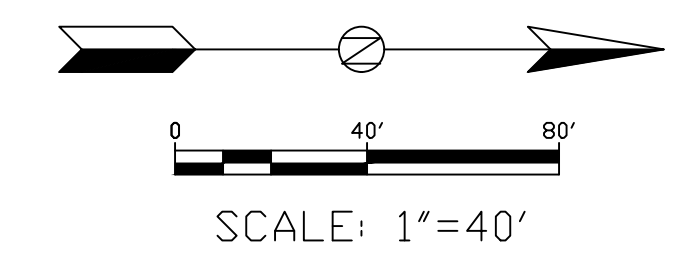

SCALE: SCALE: 1"=40'
DATE: 4-26-2017
DESIGNED BY:
FIELD INFO:
DRAWN BY:
CHECKED BY:
QUALITY CHECK:
APPROVED BY:
REVISED:
DWG:
PROJECT NO.:
SHEET NO.: AB-1

AS-BUILTS  
 ALLEN CHASE  
 CLARKSVILLE, TENNESSEE