
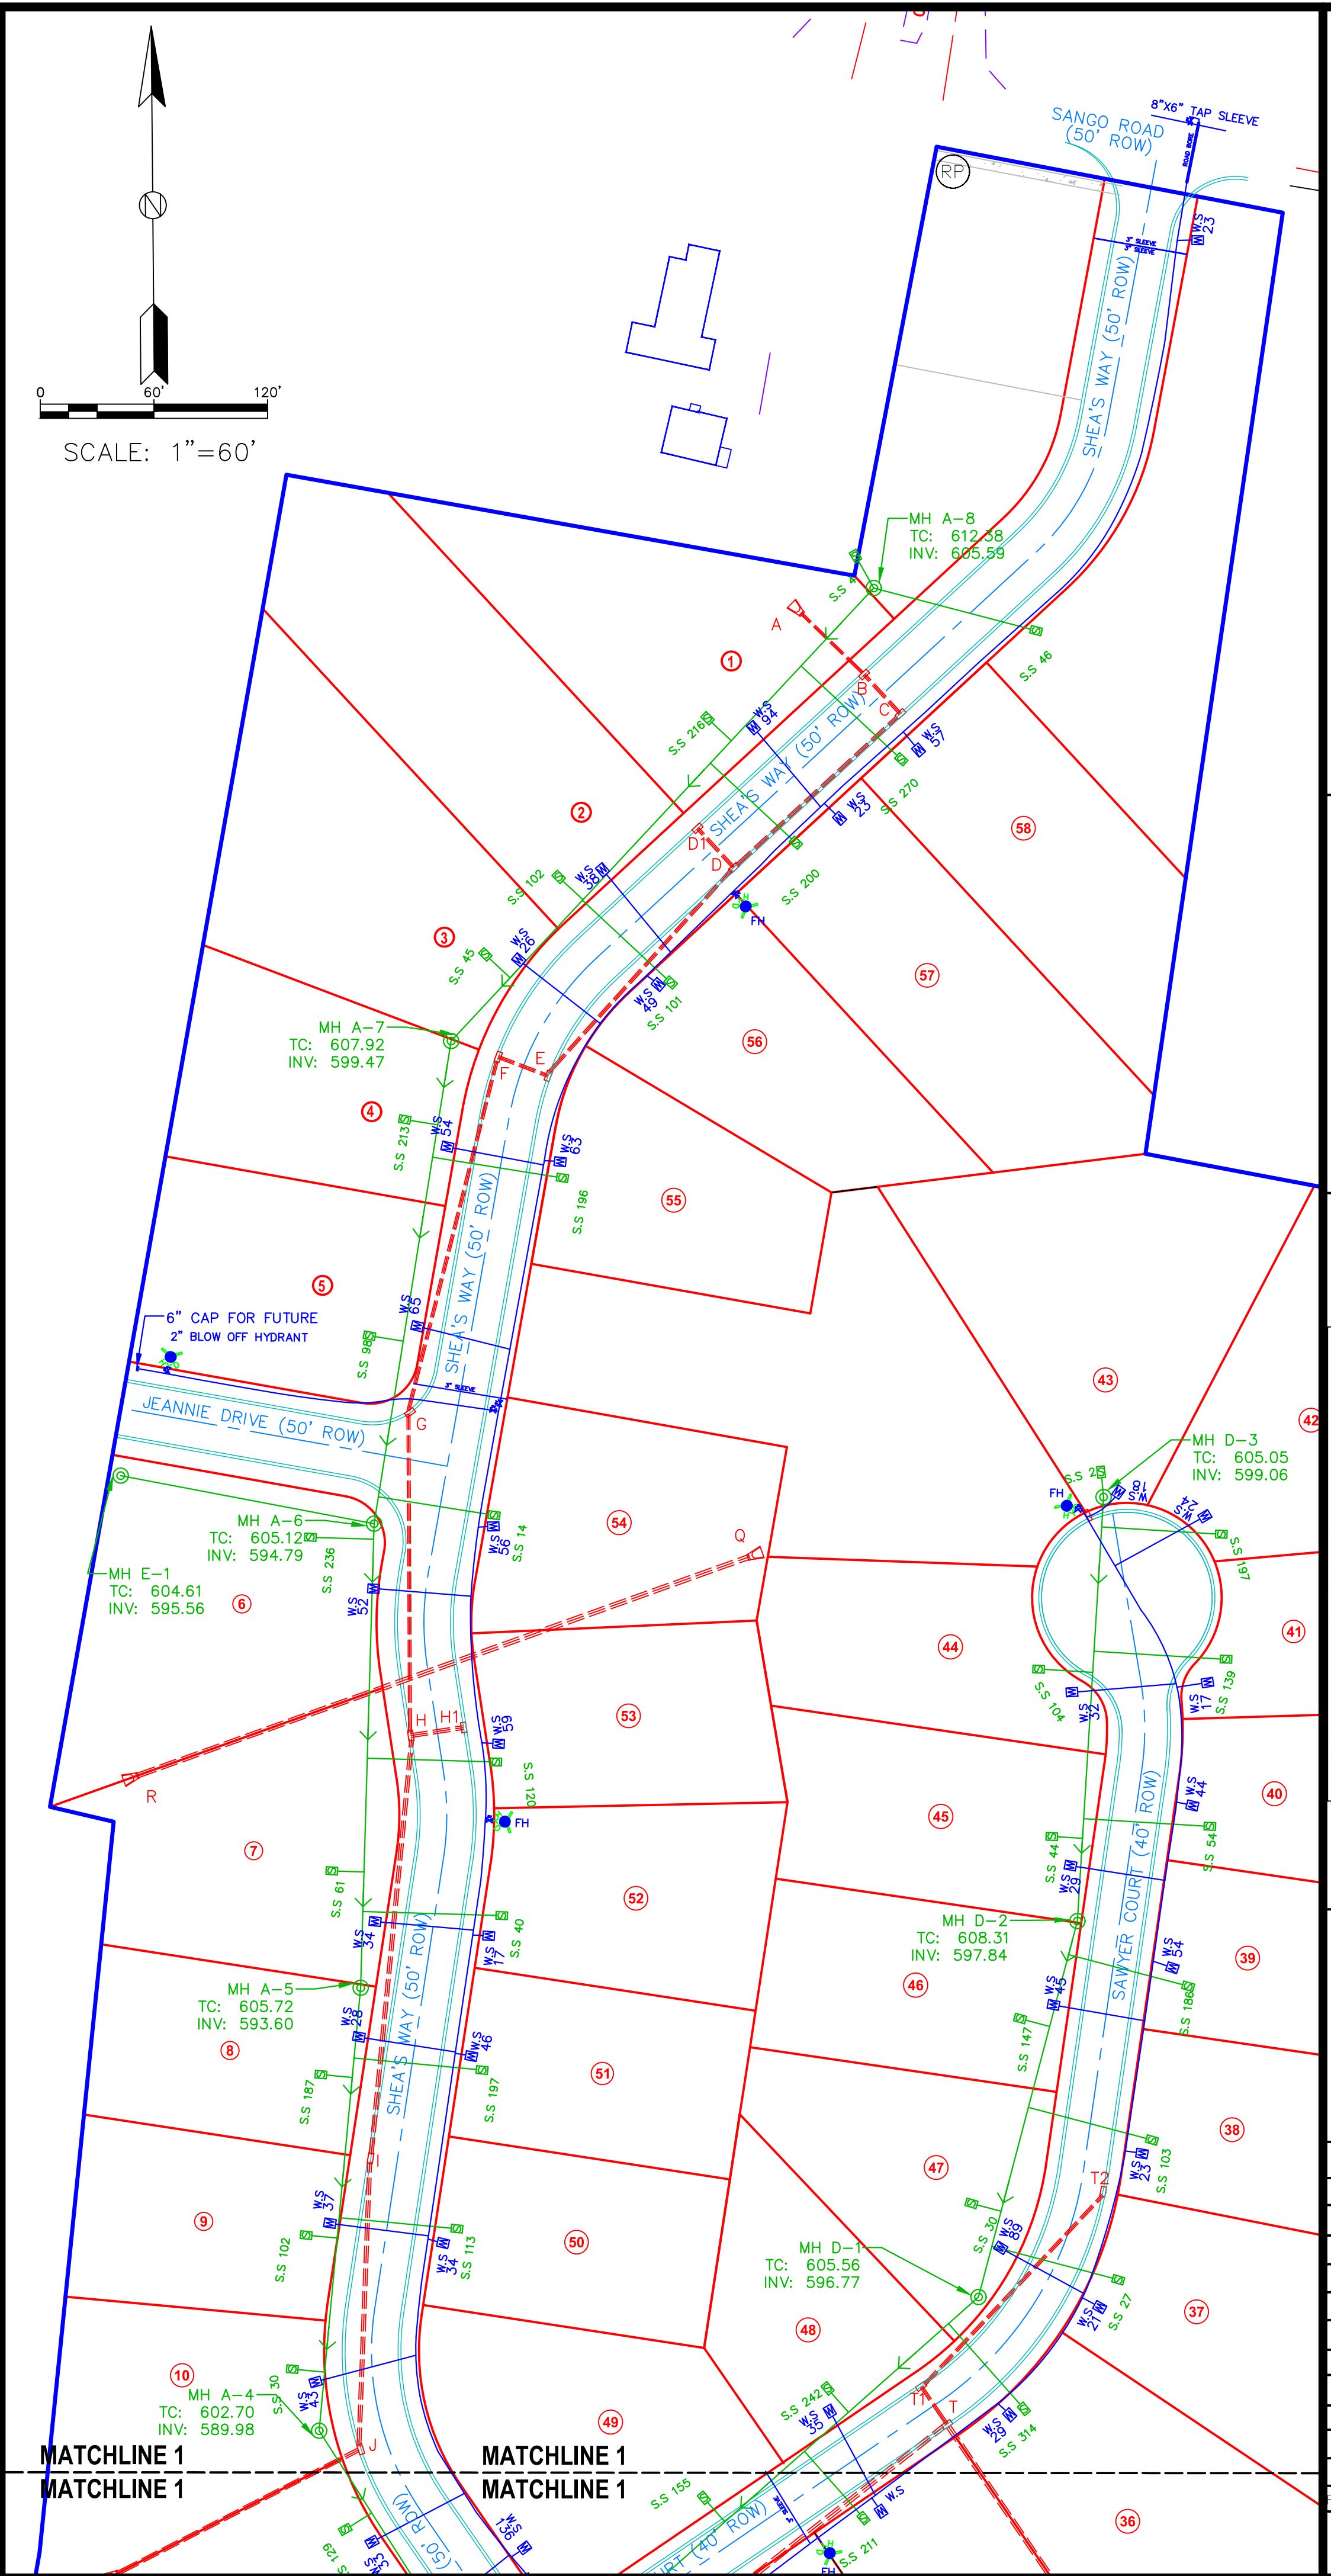
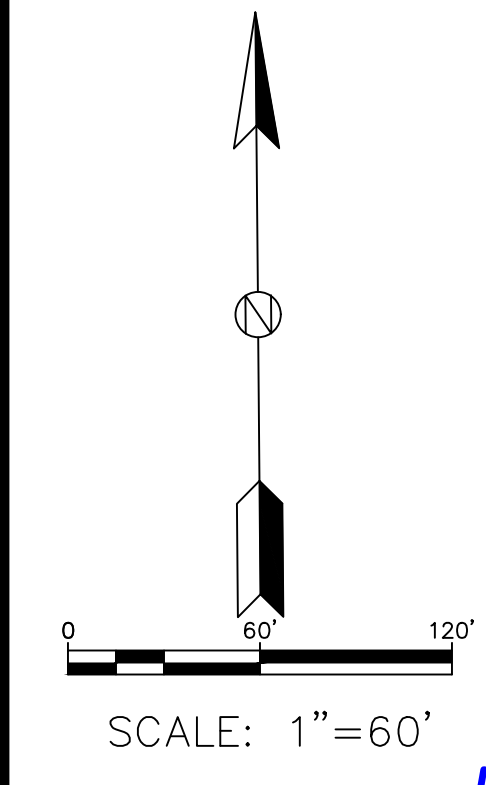


NOTES:

1. ALL SEWER SERVICE MEASUREMENTS TAKEN FROM THE NEAREST DOWNSTREAM MANHOLE.
2. ALL WATER SERVICE MEASUREMENTS ARE TAKEN FROM THE LOT CORNER NEAREST TO THE MEASUREMENT TEXT.

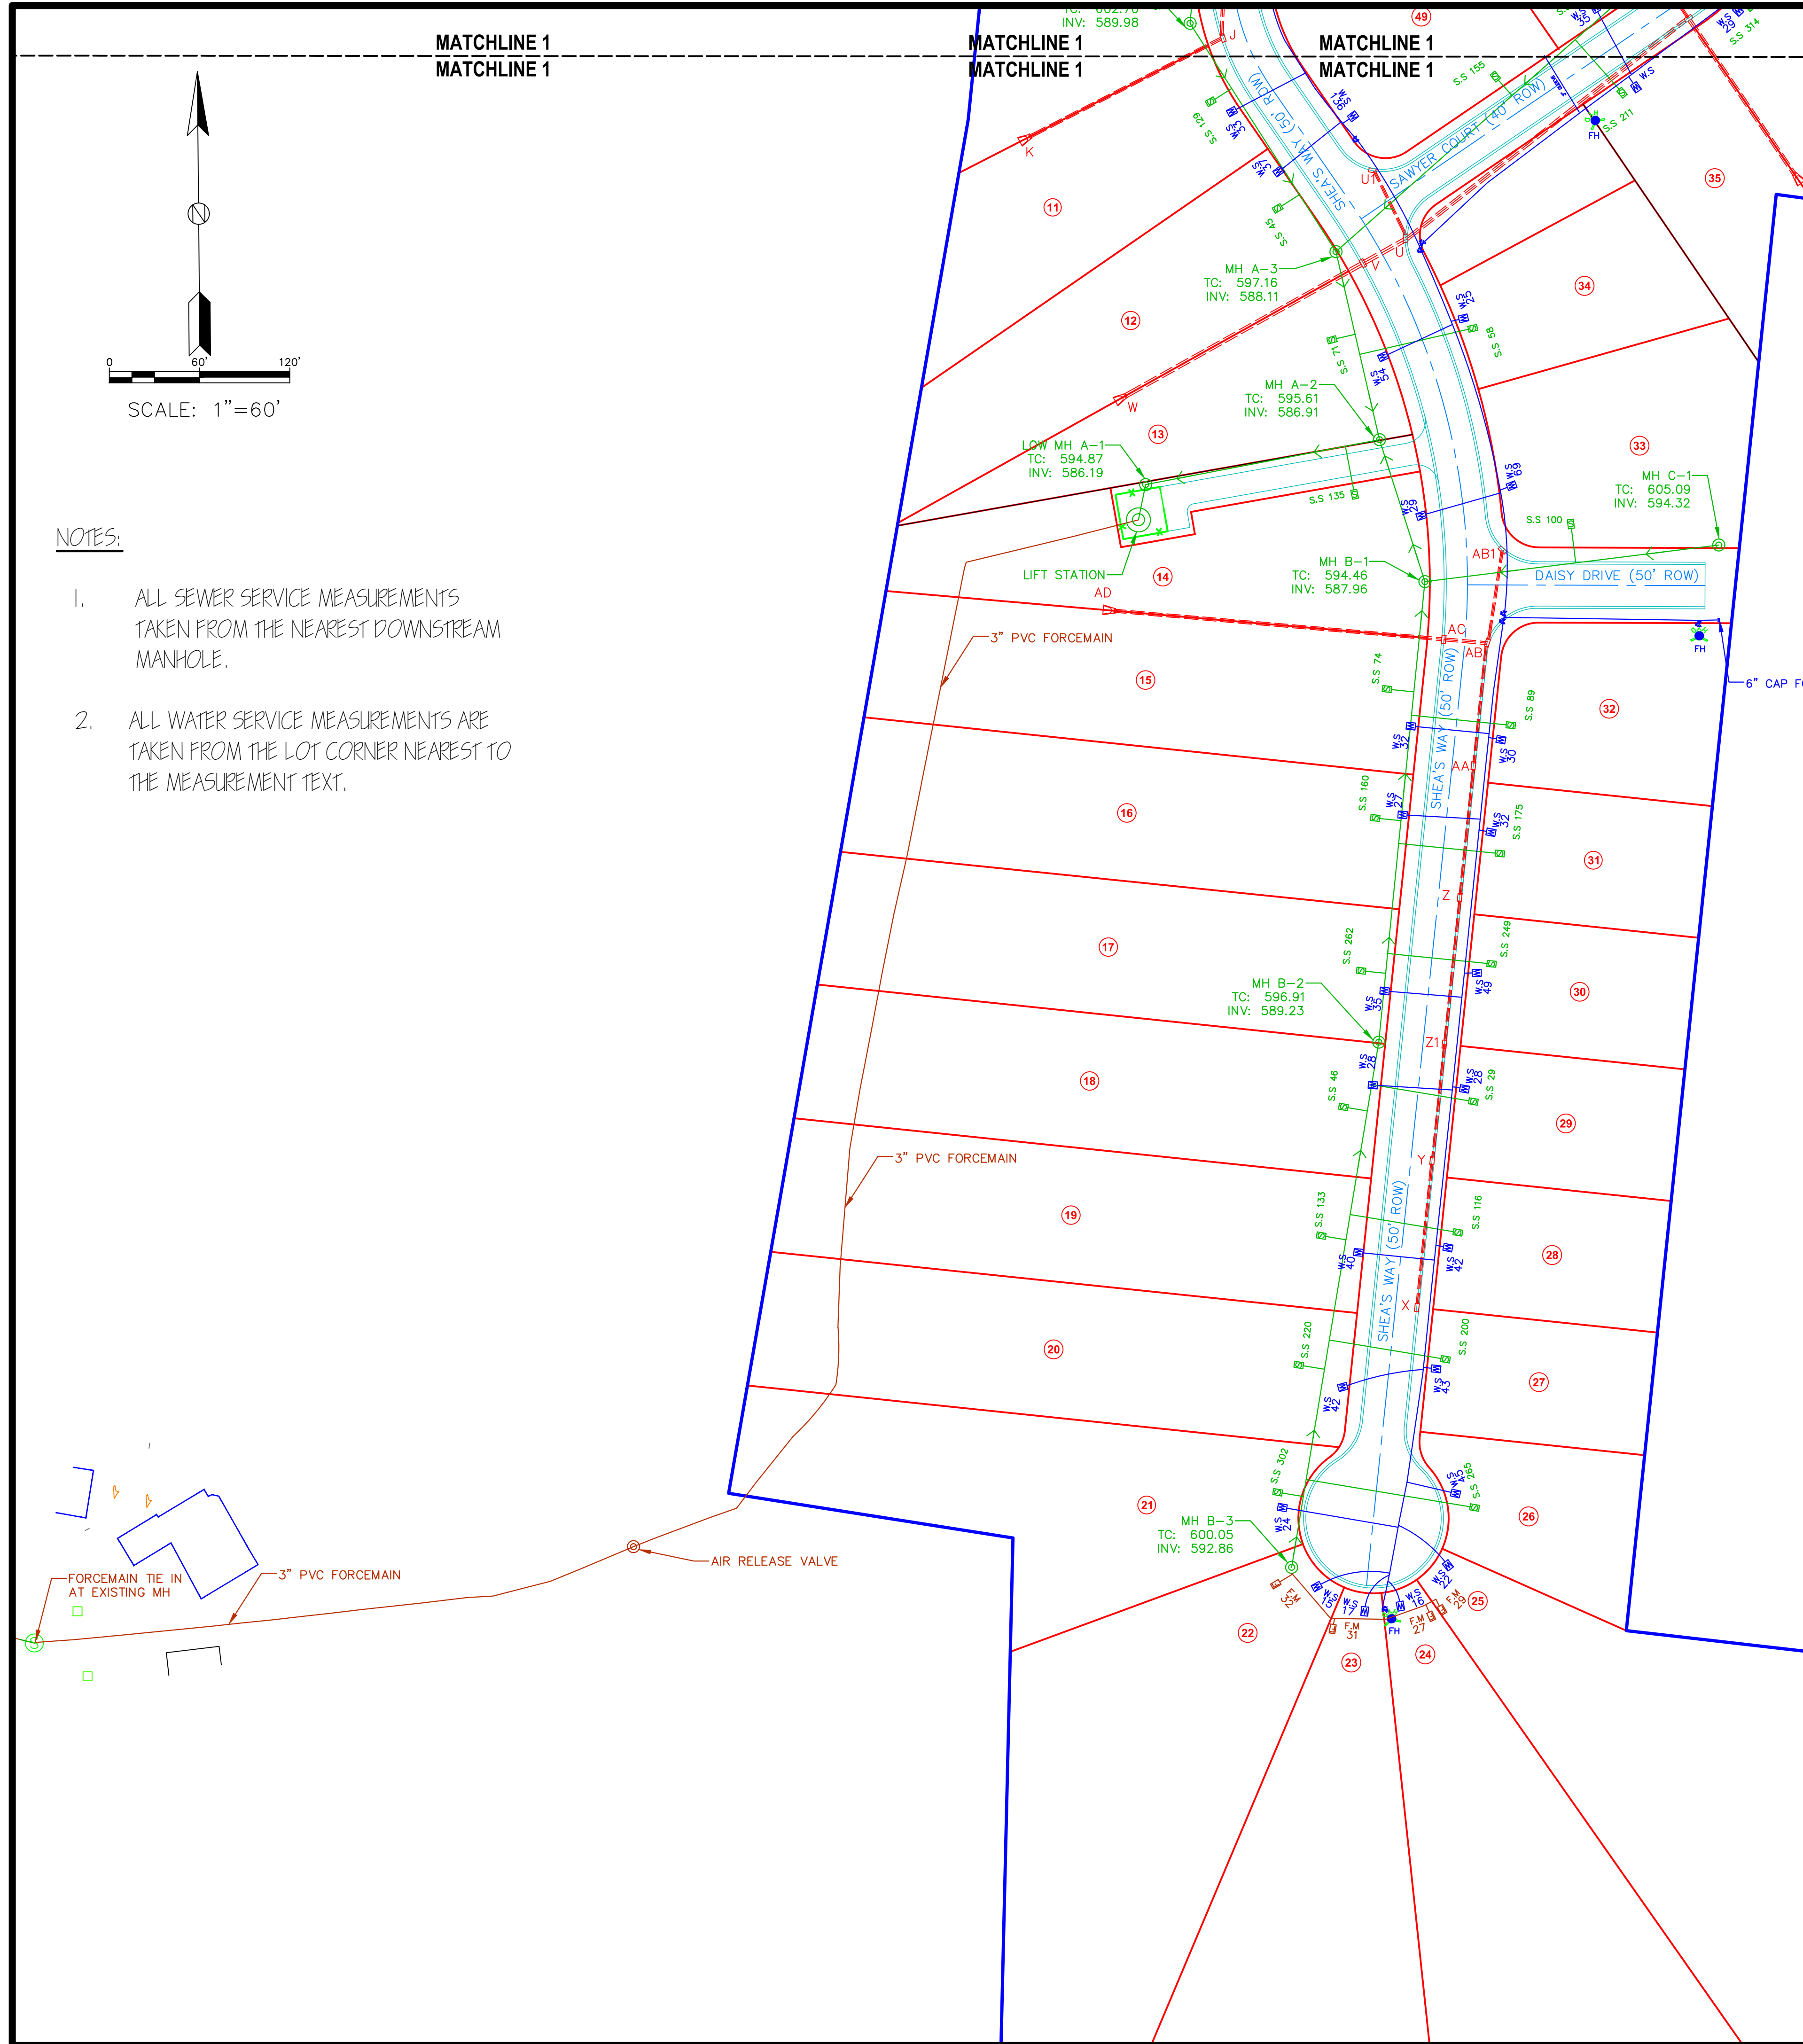

AS-BUILTS

WHITEWOOD FARM
CLARKSVILLE, TENNESSEE

SCALE: SCALE: 1"=60'
DATE: 12-07-2017
DESIGNED BY:
FIELD INFO:
DRAWN BY:
CHECKED BY:
QUALITY CHECK:
APPROVED BY:
REVISED:
DWG:
PROJECT NO.:
SHEET NO.: AB-1