




2/16/2016 7:15 AM
\\SERVER\SHARE\PUBLIC\THOMAS\OAKLANDS PH4 AS-BUILTS (JEWELL)\OAKLANDS PH4 AS-BUILTS (WORKING) 1072014.TS.DWG

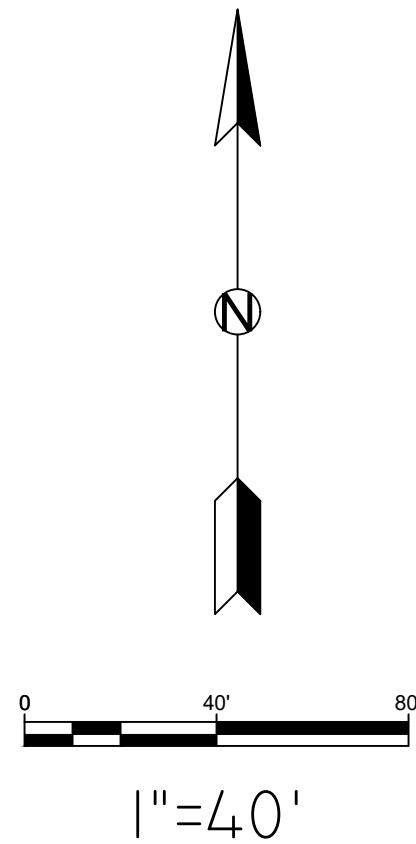

AS-BUILTS
OAKLANDS PH4
CLARKSVILLE, TENNESSEE

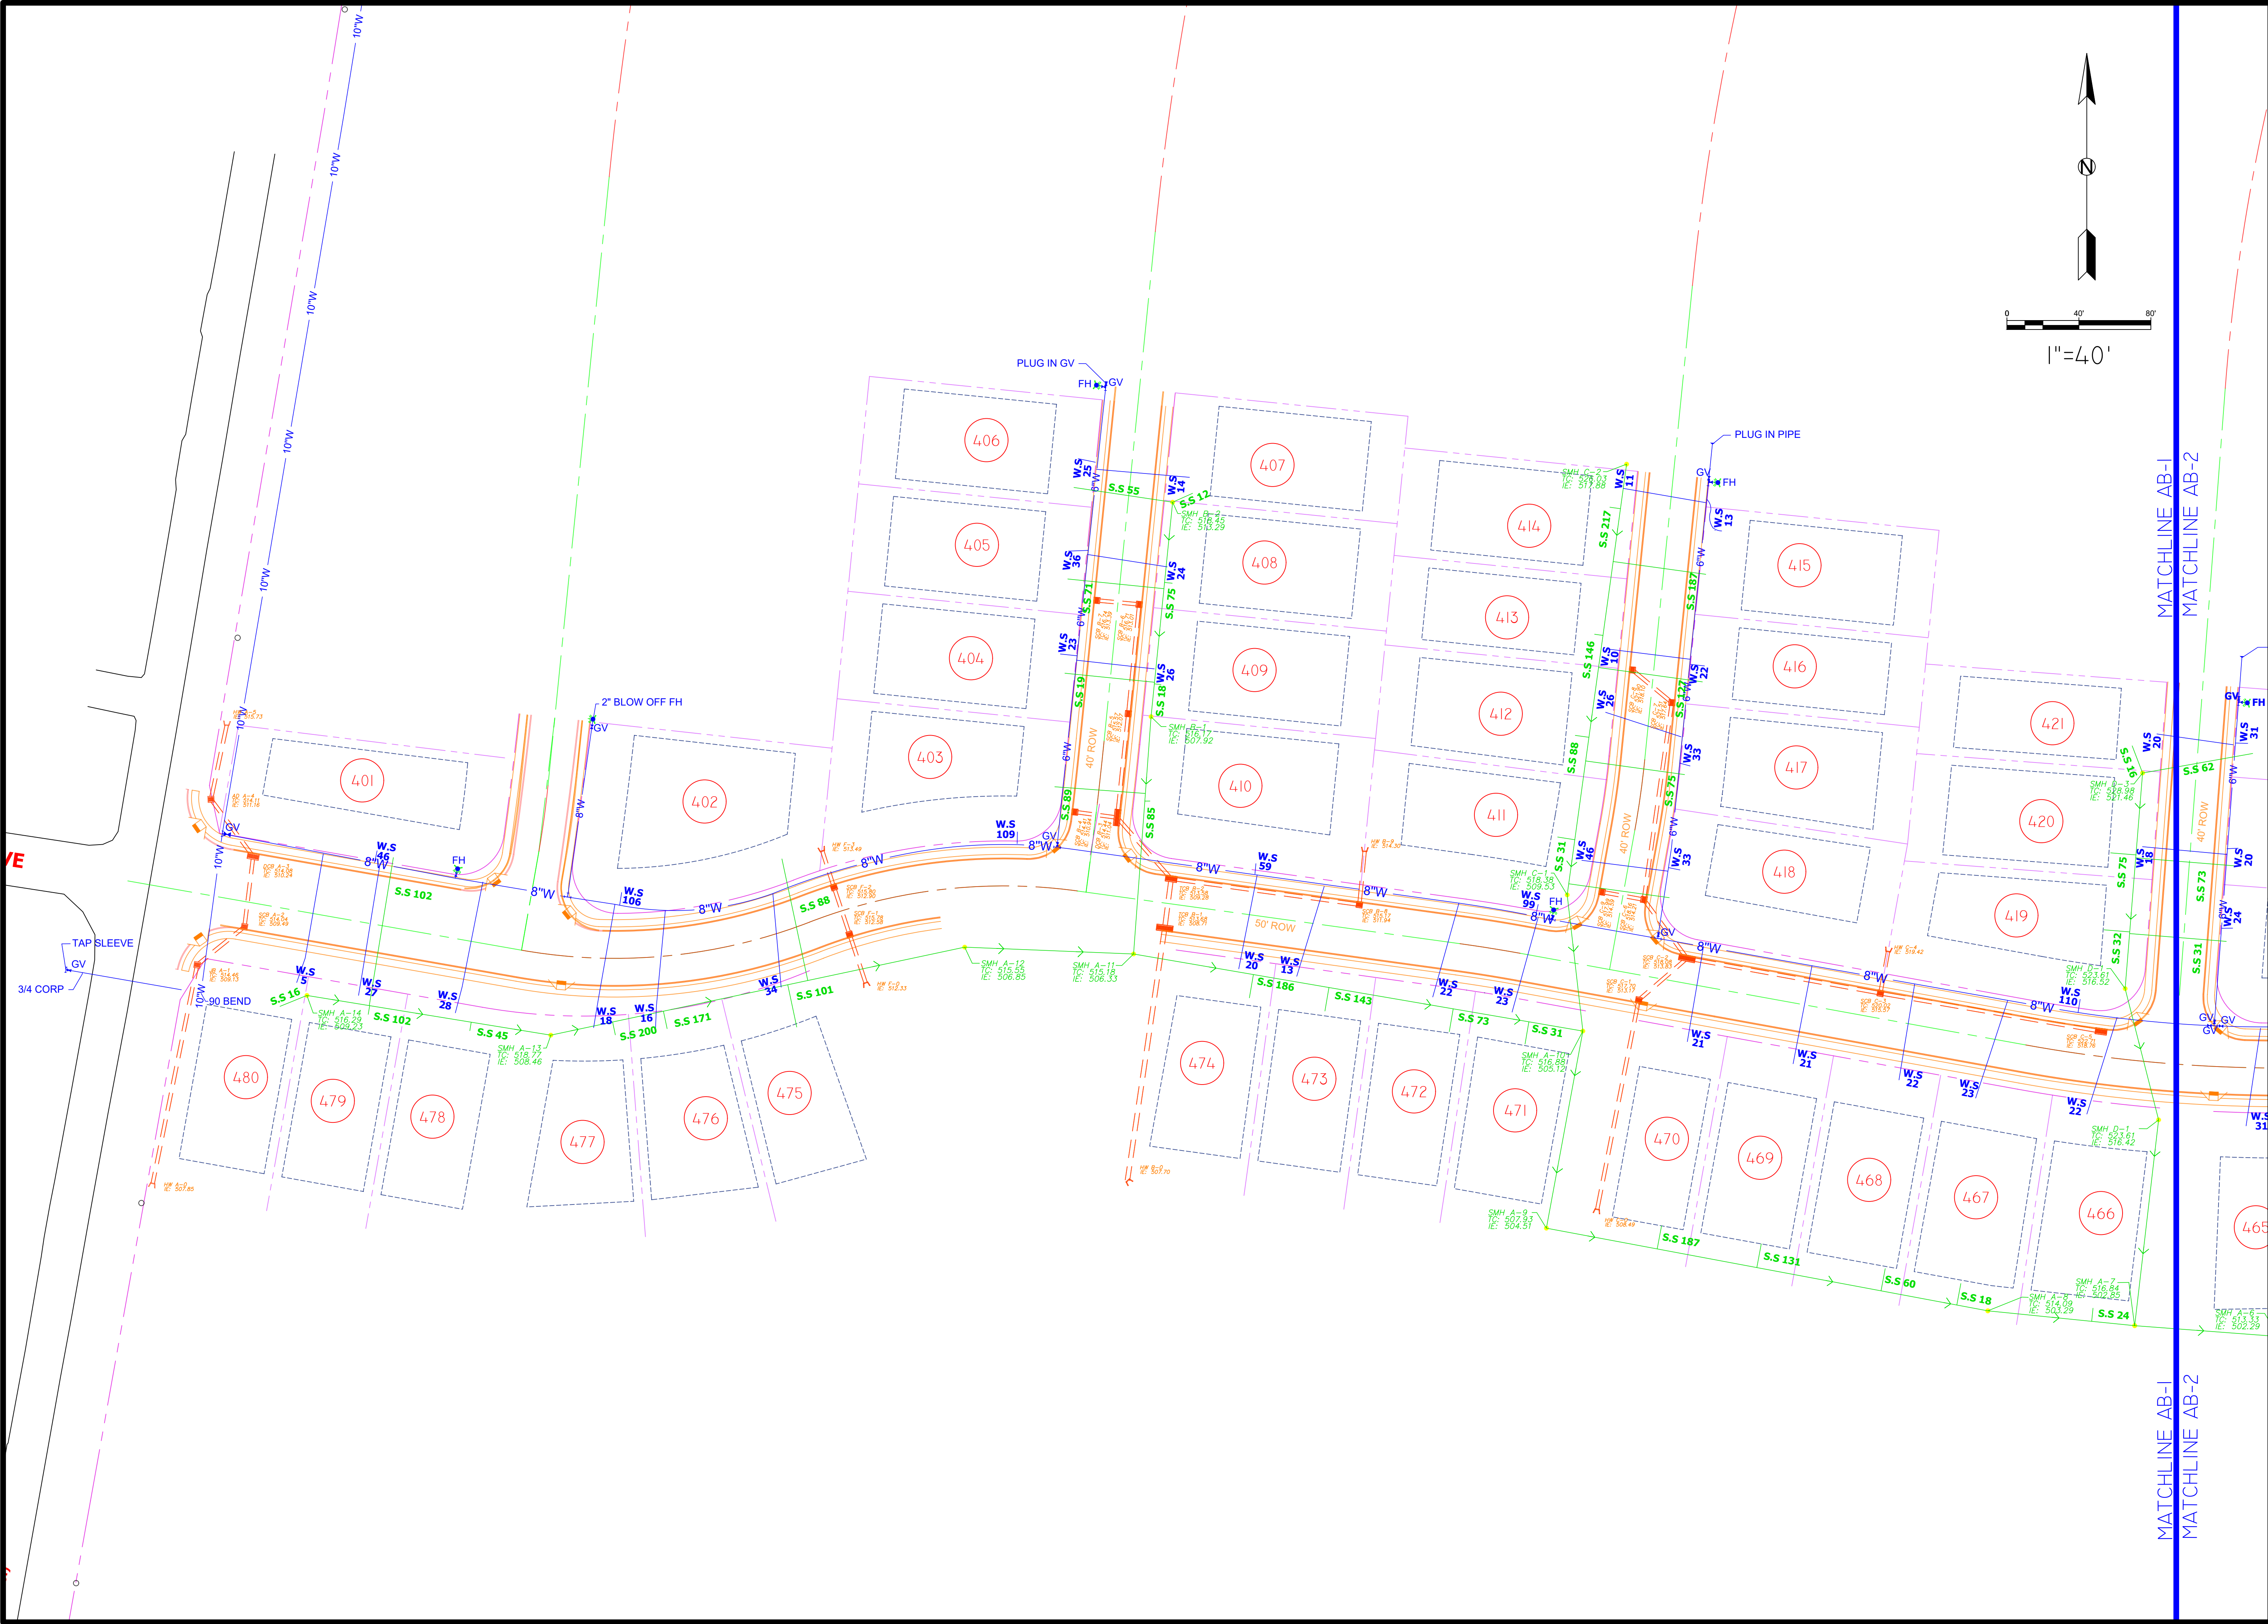

SCALE:	1" = 40'
DATE:	02-09-2016
DESIGNED BY:	
FIELD INFO:	
DRAWN BY:	
CHECKED BY:	
QUALITY CHECK:	
APPROVED BY:	
REVISED:	
DWG:	OAKLANDS PH4
PROJECT NO.:	
SHEET NO.:	AB-1

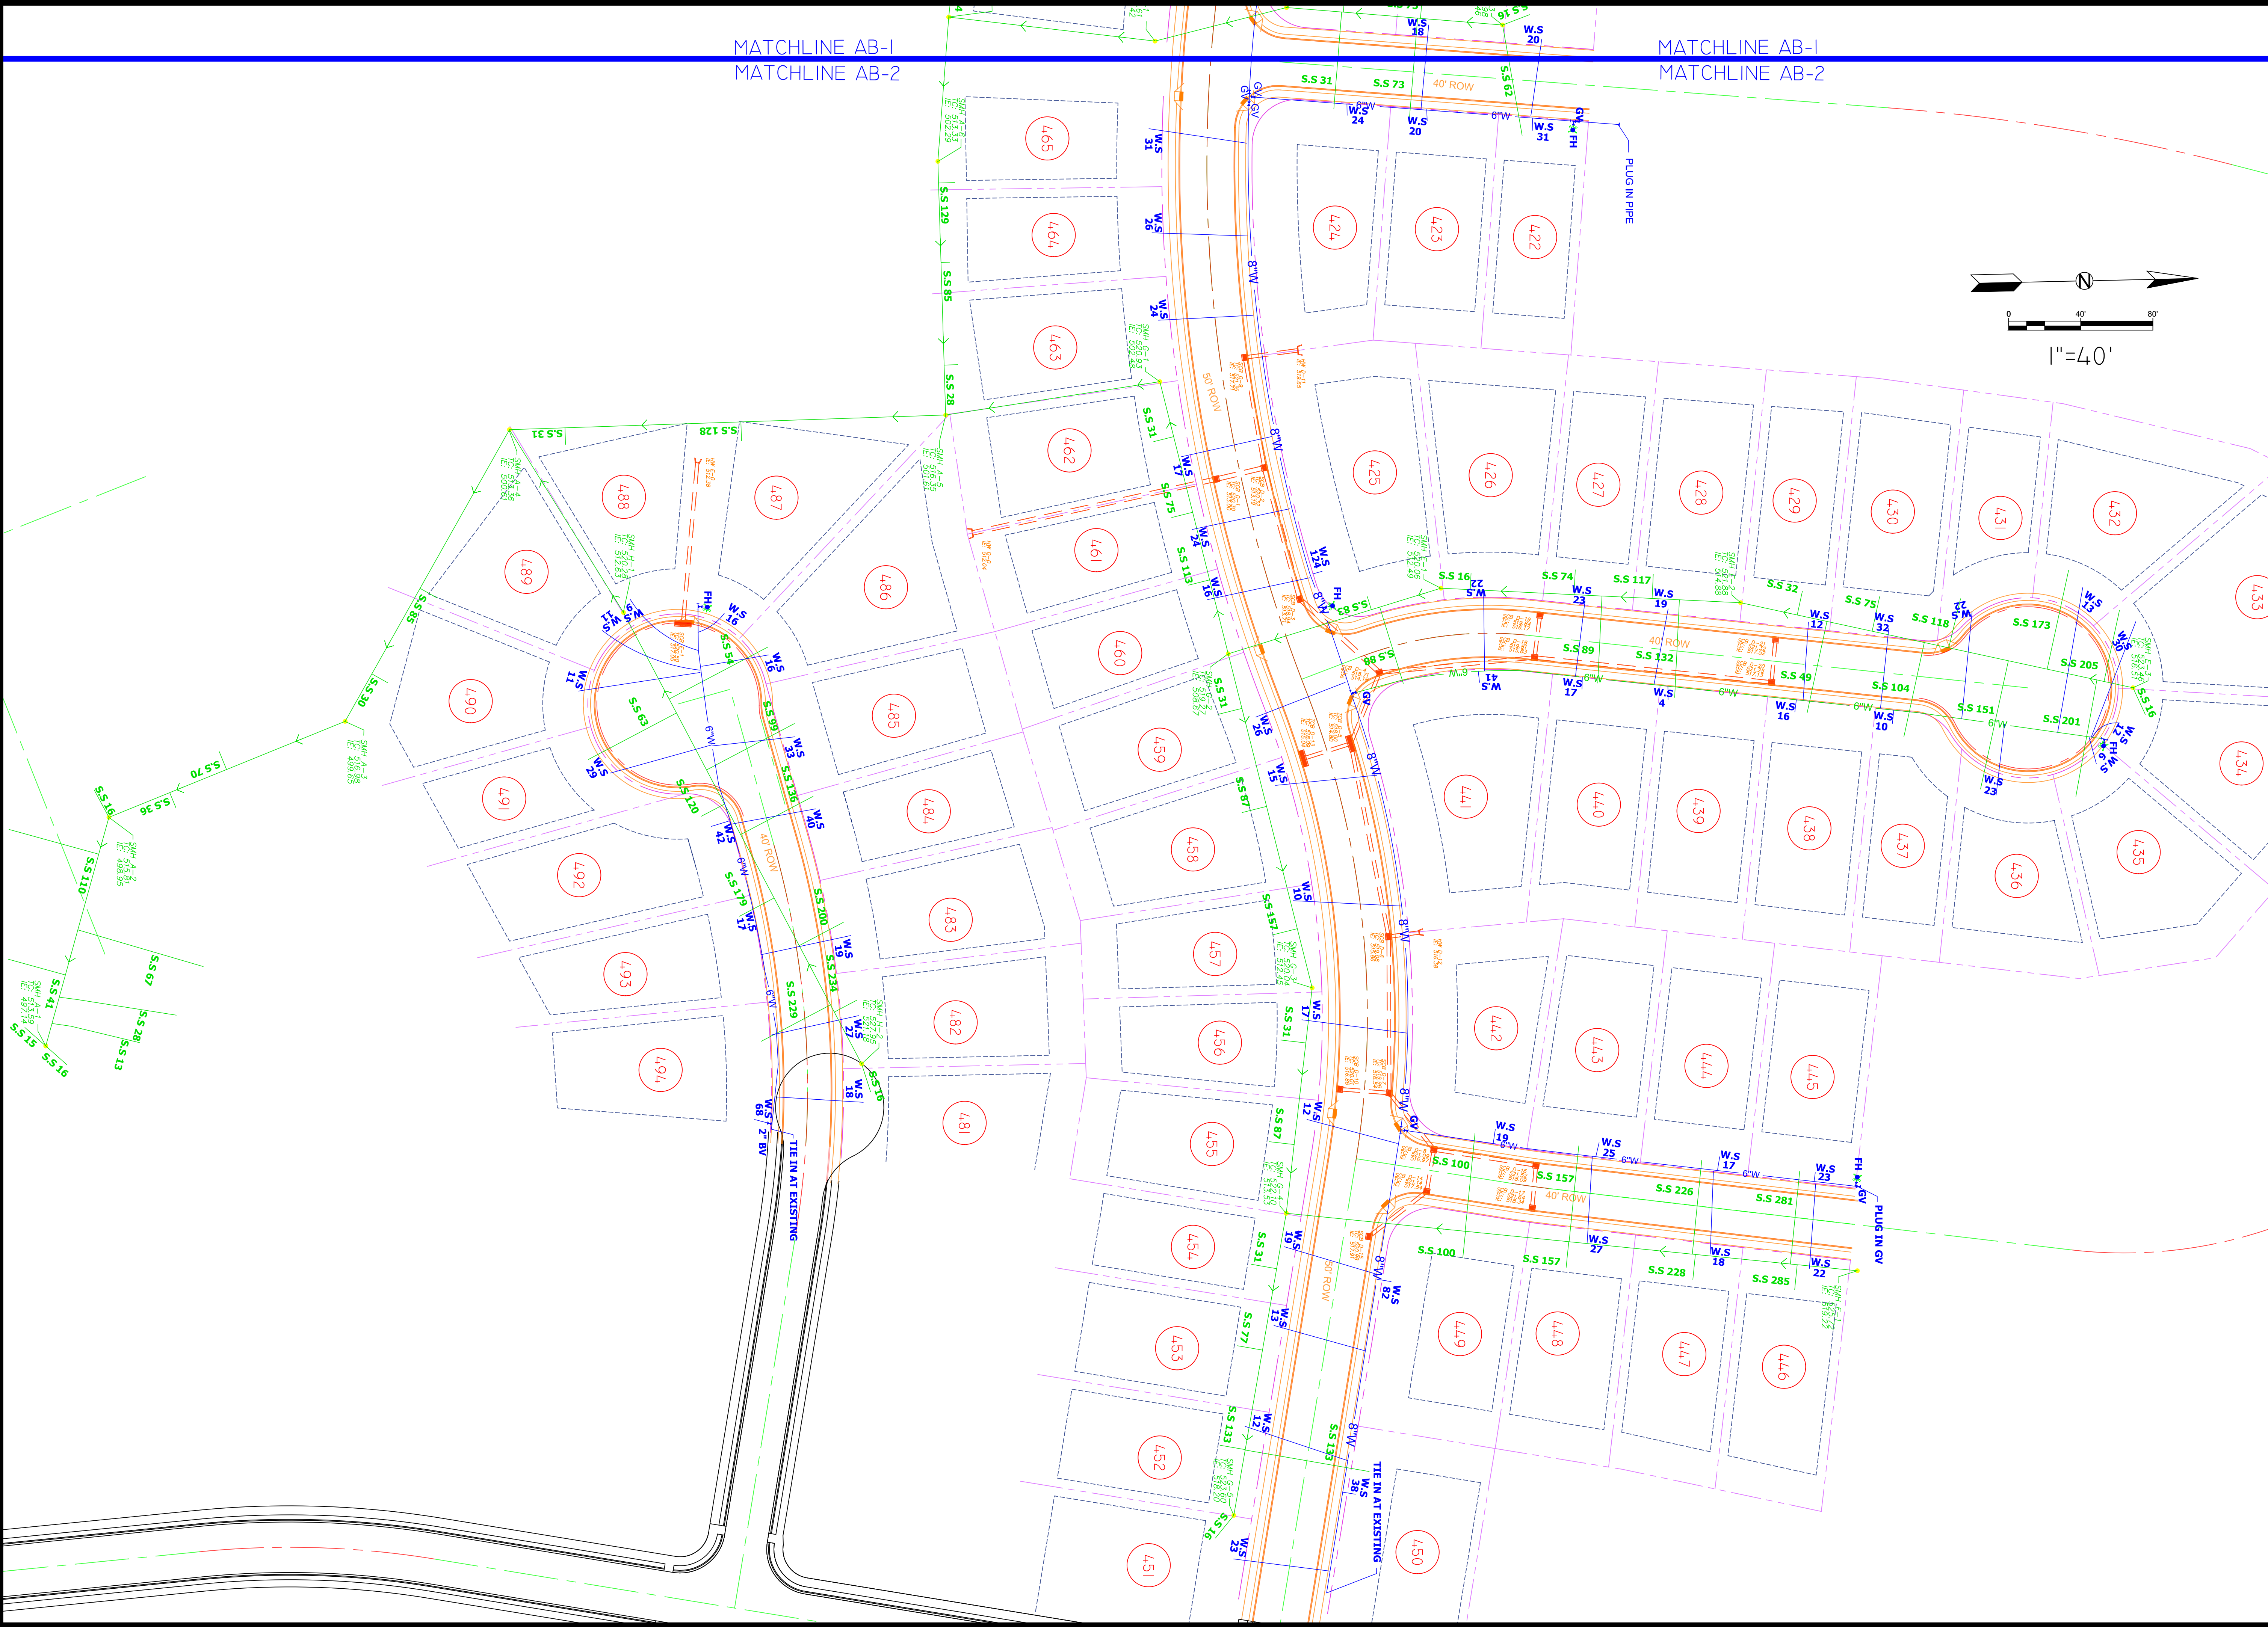

AS-BUILTS	
OAKLANDS PH4	
CLARKSVILLE, TENNESSEE	
	
SCALE:	1" = 40'
DATE:	02-09-2016
DESIGNED BY:	
FIELD INFO:	
DRAWN BY:	
CHECKED BY:	
QUALITY CHECK:	
APPROVED BY:	
REVISED:	
DWG:	OAKLANDS PH4
PROJECT NO.:	
SHEET NO: AB-2	