




NOTES:

1. ALL SEWER SERVICE MEASUREMENTS TAKEN FROM THE NEAREST DOWNSTREAM MANHOLE.
2. ALL WATER SERVICE MEASUREMENTS ARE TAKEN FROM THE LOT CORNER NEAREST TO THE MEASUREMENT TEXT.

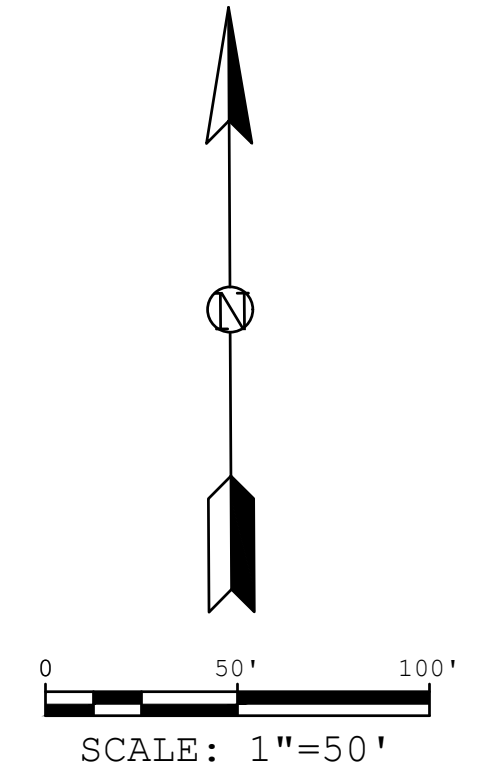

BYARD CONSTRUCTION, LLC
 3136 OLD SANGO ROAD
 CLARKSVILLE, TN 37043
 OFFICE: 931-358-4700

UTILITY
 AS-BUILTS
 BELLSHIRE SEC E
 CLARKSVILLE, TENNESSEE

SCALE:	1"=50'
DATE:	10/18/2019
DESIGNED BY:	
FIELD INFO:	
DRAWN BY:	
CHECKED BY:	
QUALITY CHECK:	
APPROVED BY:	
REVISED:	
DWG:	
PROJECT NO.:	
SHEET NO.:	AB-1