


**NOTES:**

- 1. ALL SEWER SERVICE MEASUREMENTS TAKEN FROM THE NEAREST DOWNSTREAM MANHOLE.



BYARD CONSTRUCTION, LLC  
 3136 OLD SANGO ROAD  
 CLARKSVILLE, TN 37043  
 OFFICE: 931-358-4700

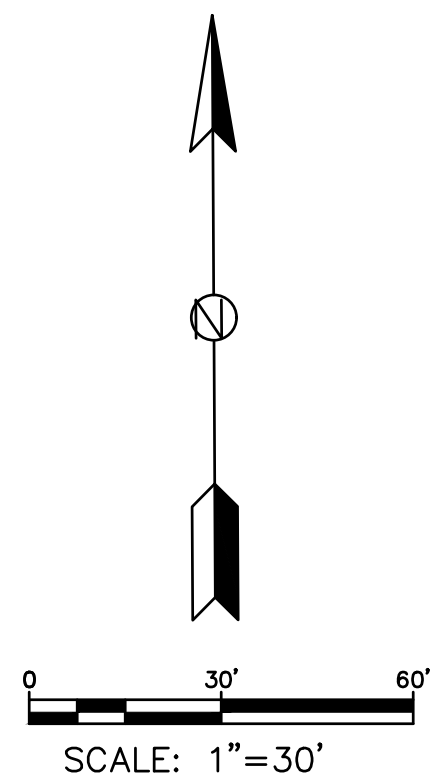

UTILITY  
 AS-BUILTS  
 NORTH PARK SEC 2  
 CLARKSVILLE, TENNESSEE

SCALE:	1"=30'
DATE:	1/23/2020
DESIGNED BY:	
FIELD INFO:	
DRAWN BY:	
CHECKED BY:	
QUALITY CHECK:	
APPROVED BY:	
REVISED:	
DWG:	
PROJECT NO.:	
SHEET NO.:	AB-1