


NOTES

1. WATER SERVICE MEASUREMENTS ARE TAKEN FROM THE LOT CORNER NEAREST TO THE MEASUREMENT TEXT.
2. FORCEMAIN SERVICE MEASUREMENTS ARE TAKEN FROM THE LOT CORNER NEAREST TO THE MEASUREMENT TEXT.

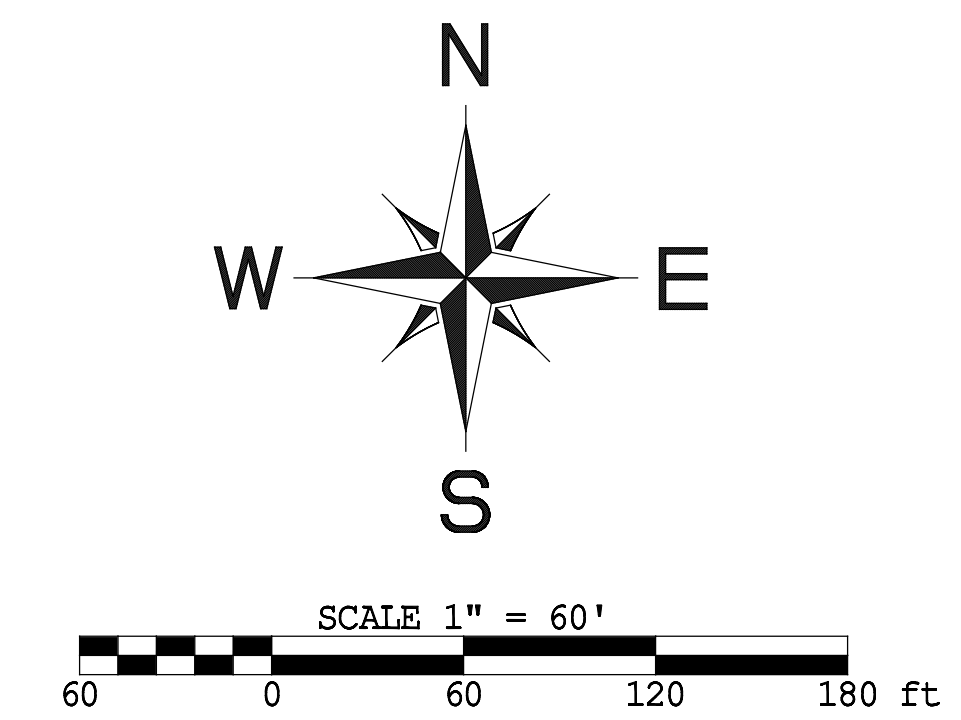

NO.	REVISIONS	DATE:

AS BUILTS
 SHADY BLUFF SECTION 2
 CLARKSVILLE, TN

BYARD CONSTRUCTION, LLC
 3136 OLD SANGO ROAD
 CLARKSVILLE, TN
 OFFICE: (931) 358-4700