



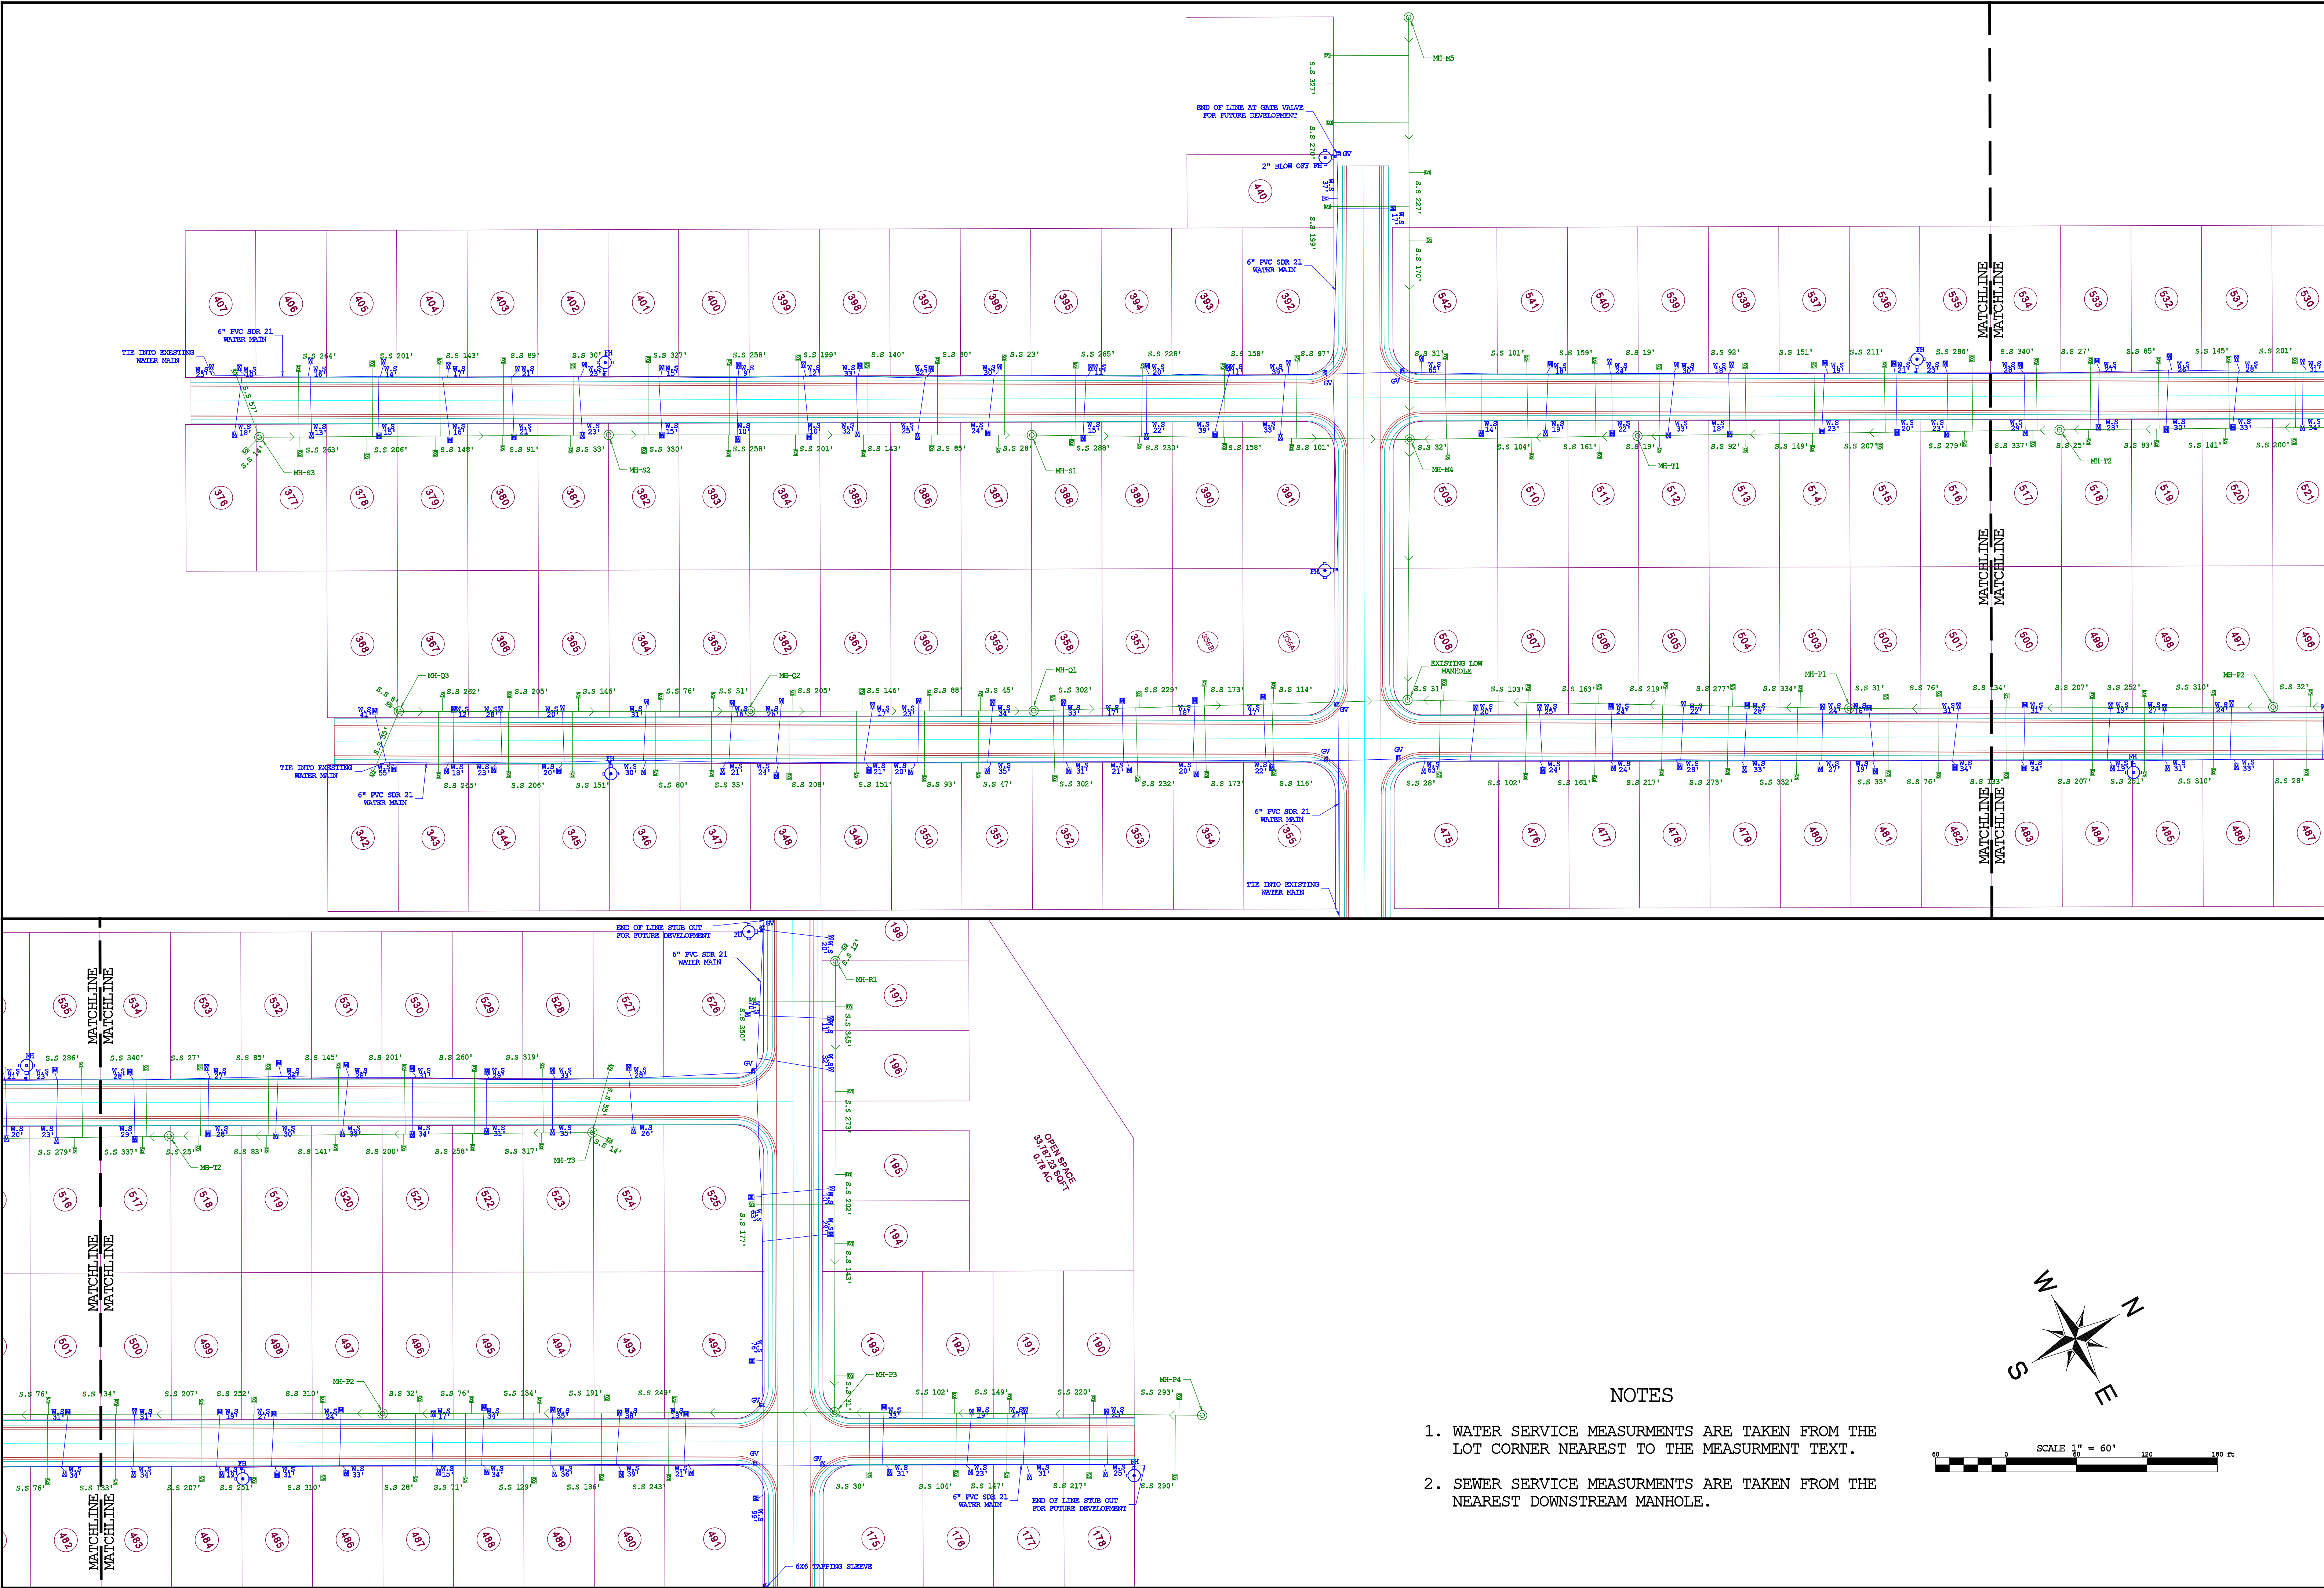

NOTES

1. WATER SERVICE MEASUREMENTS ARE TAKEN FROM THE LOT CORNER NEAREST TO THE MEASUREMENT TEXT.
2. SEWER SERVICE MEASUREMENTS ARE TAKEN FROM THE NEAREST DOWNSTREAM MANHOLE.

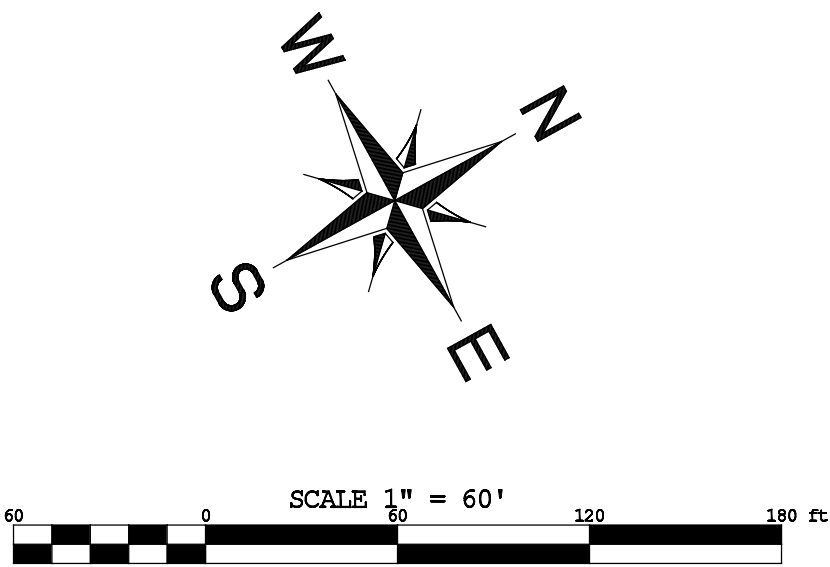

DATE:		
REVISIONS		
NO		
BYARD CONSTRUCTION, LLC 3136 OLD SANGO ROAD CLARKSVILLE, TN OFFICE: (931) 358-4700		
SHEET		
1 OF 1		