
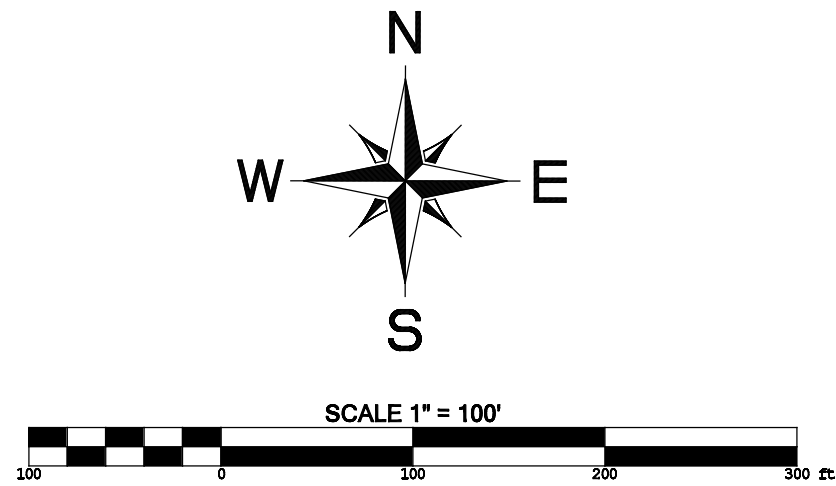


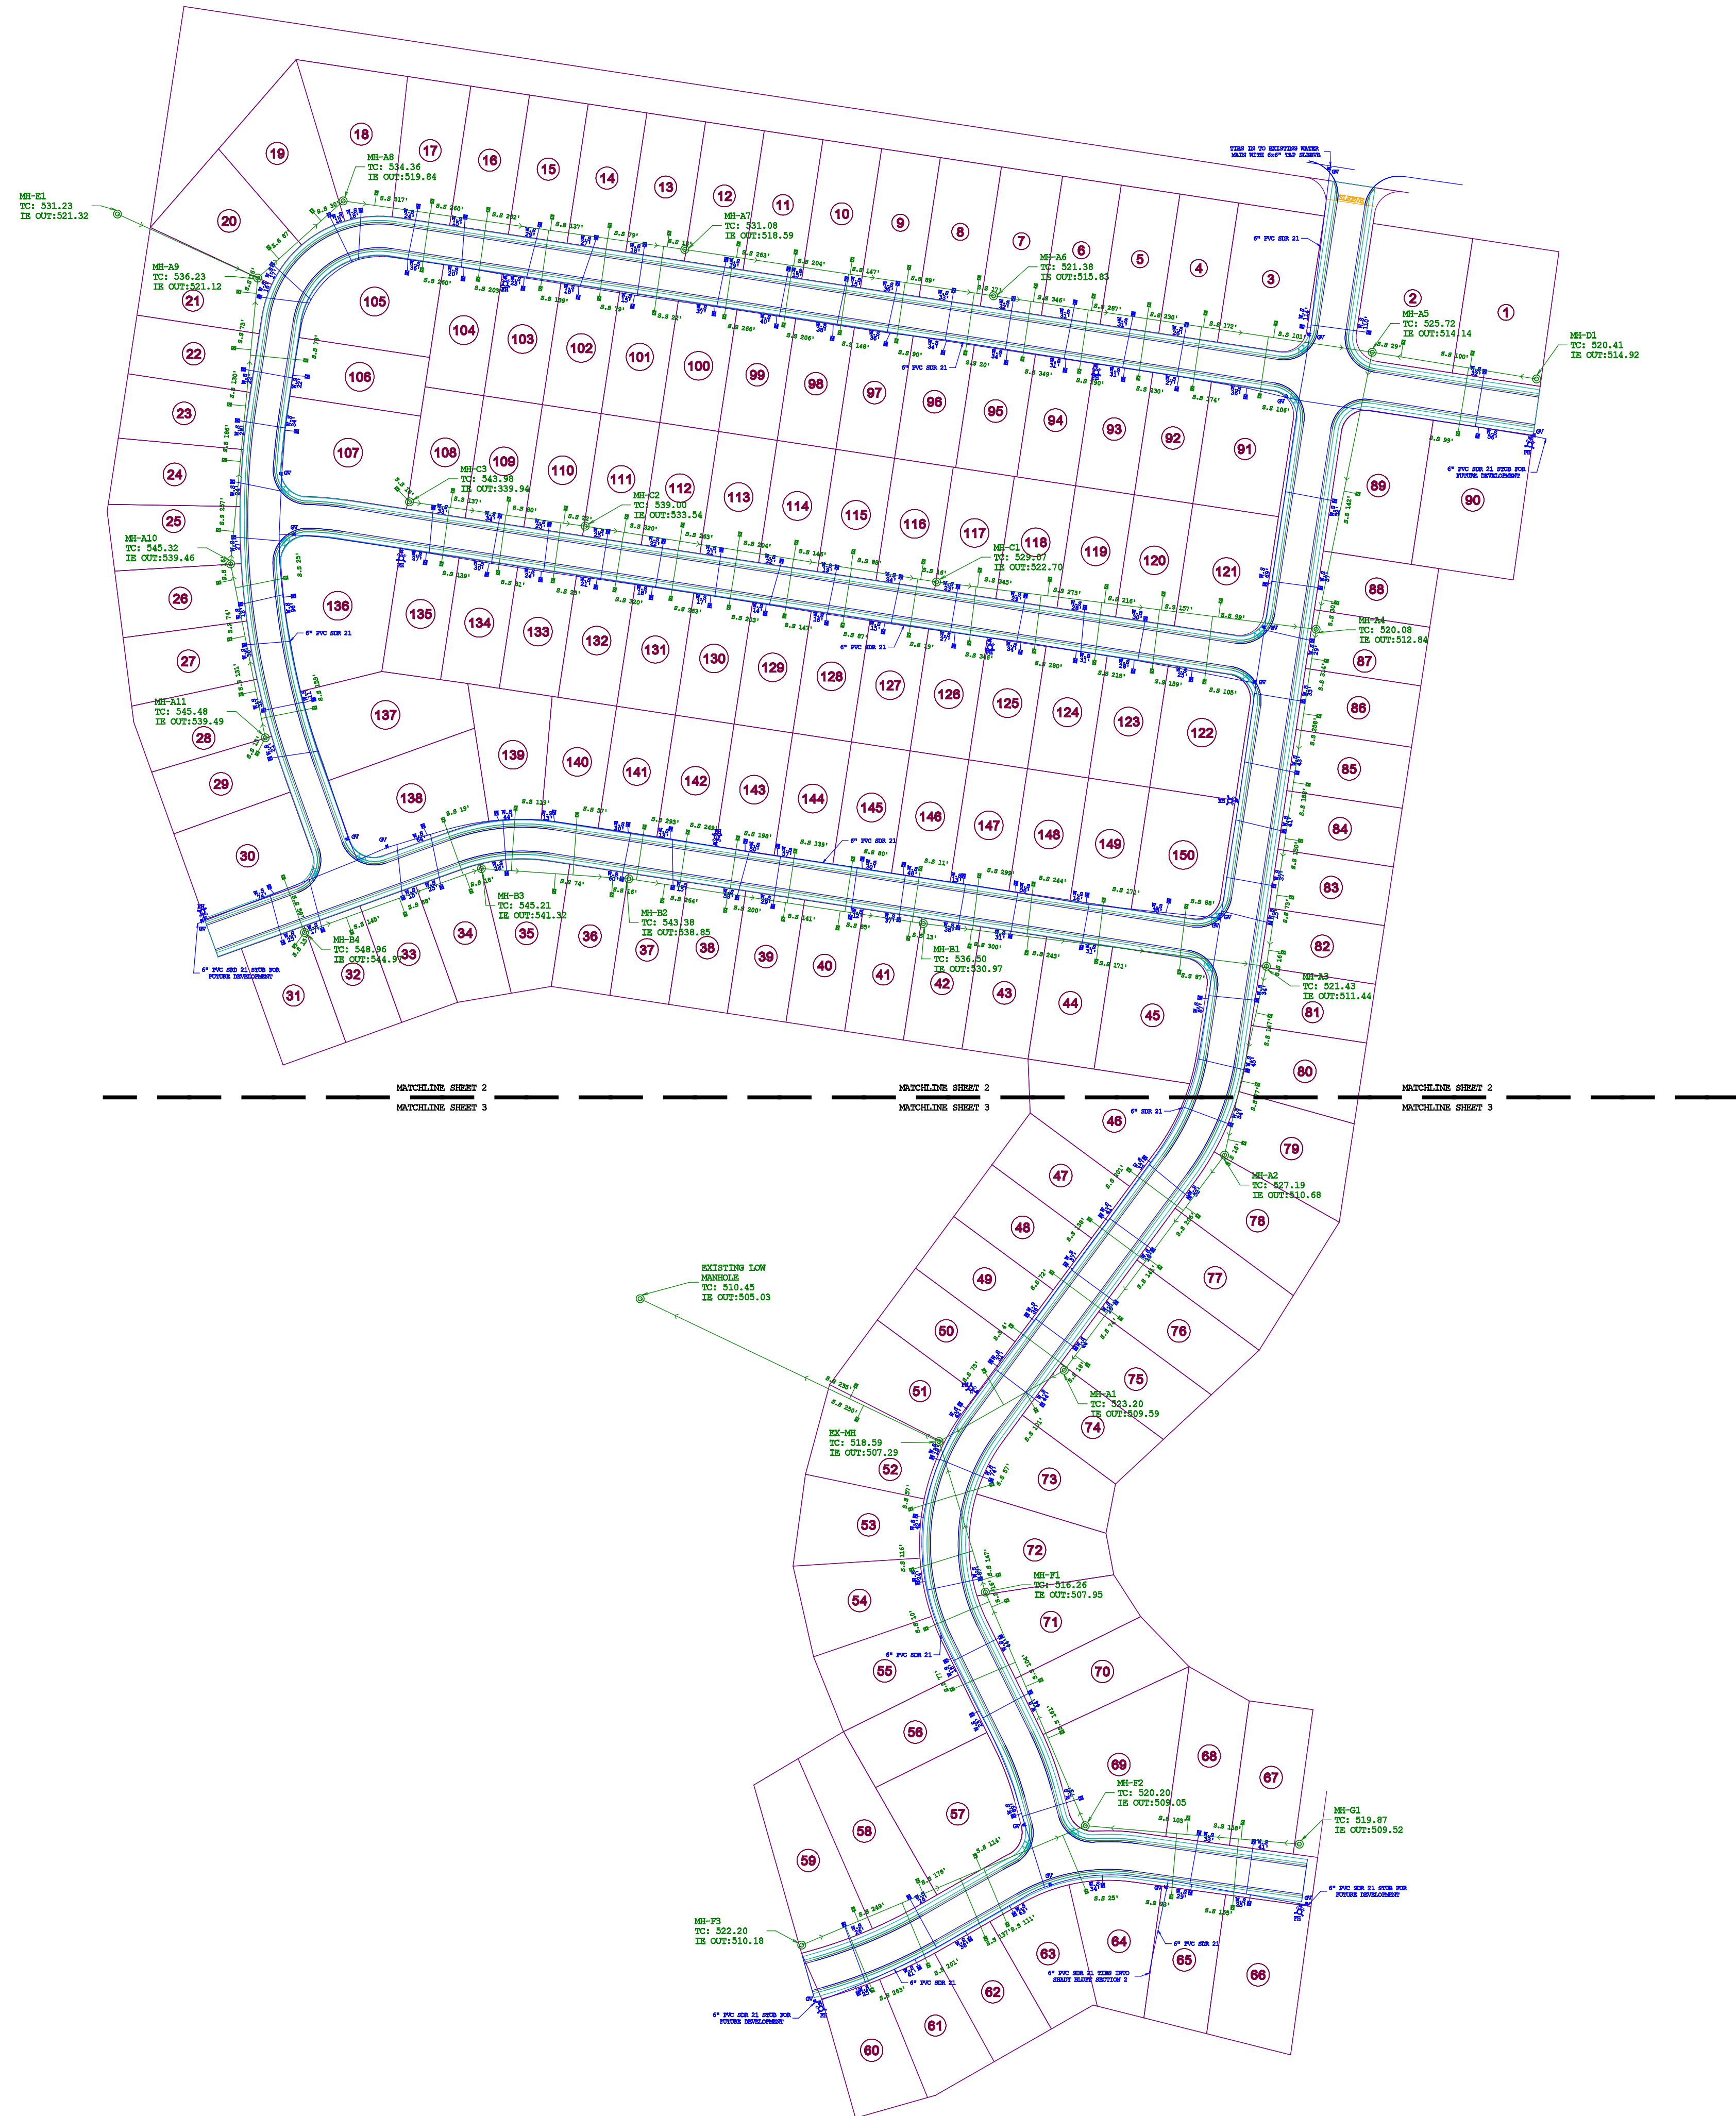

- NOTES:
1. WATER SERVICE MEASUREMENTS ARE TAKEN FROM THE LOT CORNER NEAREST TO THE MEASUREMENT TEXT.
 2. SEWER SERVICE MEASUREMENTS ARE TAKEN FROM THE NEAREST DOWNSTREAM MANHOLE.


DATE:

REVISIONS

NO.

BYARD CONSTRUCTION, LLC
3136 OLD SANGO ROAD
CLARKSVILLE, TN
OFFICE: (931) 358-4700

SHEET
1 OF 3

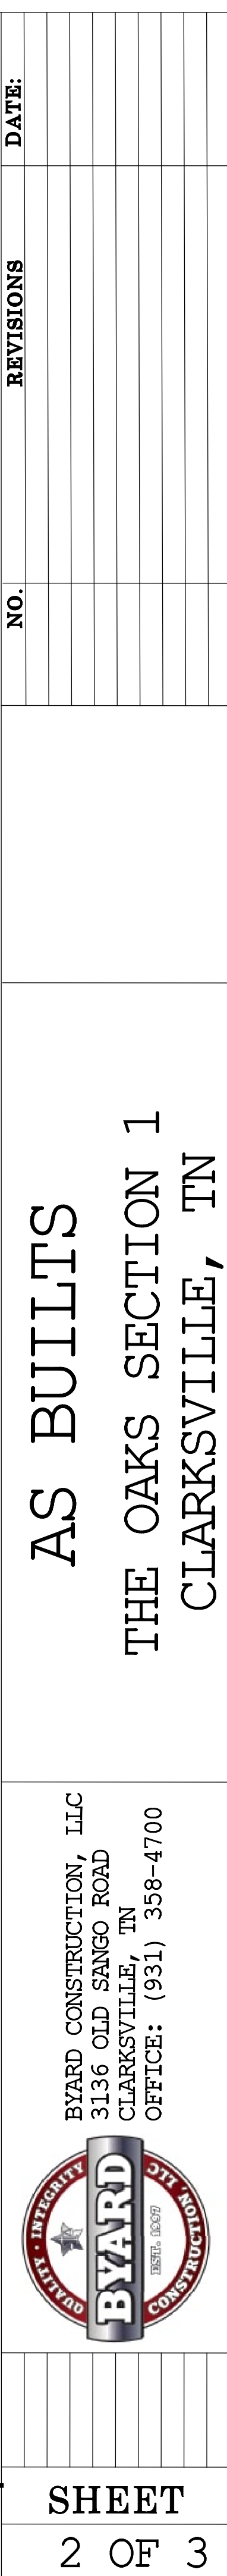

MATCHLINE SHEET 2
MATCHLINE SHEET 3

MATCHLINE SHEET 2
MATCHLINE SHEET 3

MATCHLINE SHEET 2
MATCHLINE SHEET 3

EXISTING LOW
MANHOLE
TC: 510.45
IE OUT:505.03

MH-F3
TC: 522.20
IE OUT:510.18

EX-MH
TC: 518.59
IE OUT:507.29


MH-A1
TC: 523.20
IE OUT:509.59

MH-A2
TC: 527.19
IE OUT:510.68

MH-F1
TC: 516.26
IE OUT:507.95

MH-F2
TC: 520.20
IE OUT:509.05

MH-G1
TC: 519.87
IE OUT:509.52

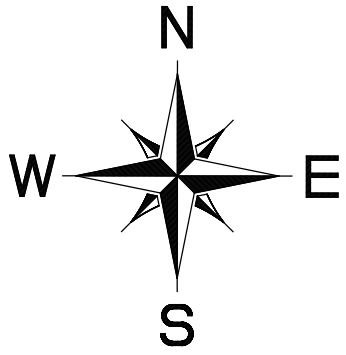

SCALE 1" = 50'

AS BUILTS
THE OAKS SECTION 1
CLARKSVILLE, TN

BYARD CONSTRUCTION, LLC
3136 OLD SANGO ROAD
CLARKSVILLE, TN
OFFICE: (931) 358-4700



NOTES:

1. WATER SERVICE MEASUREMENTS ARE TAKEN FROM THE LOT CORNER NEAREST TO THE MEASUREMENT TEXT.
2. SEWER SERVICE MEASUREMENTS ARE TAKEN FROM THE NEAREST DOWNSTREAM MANHOLE.