

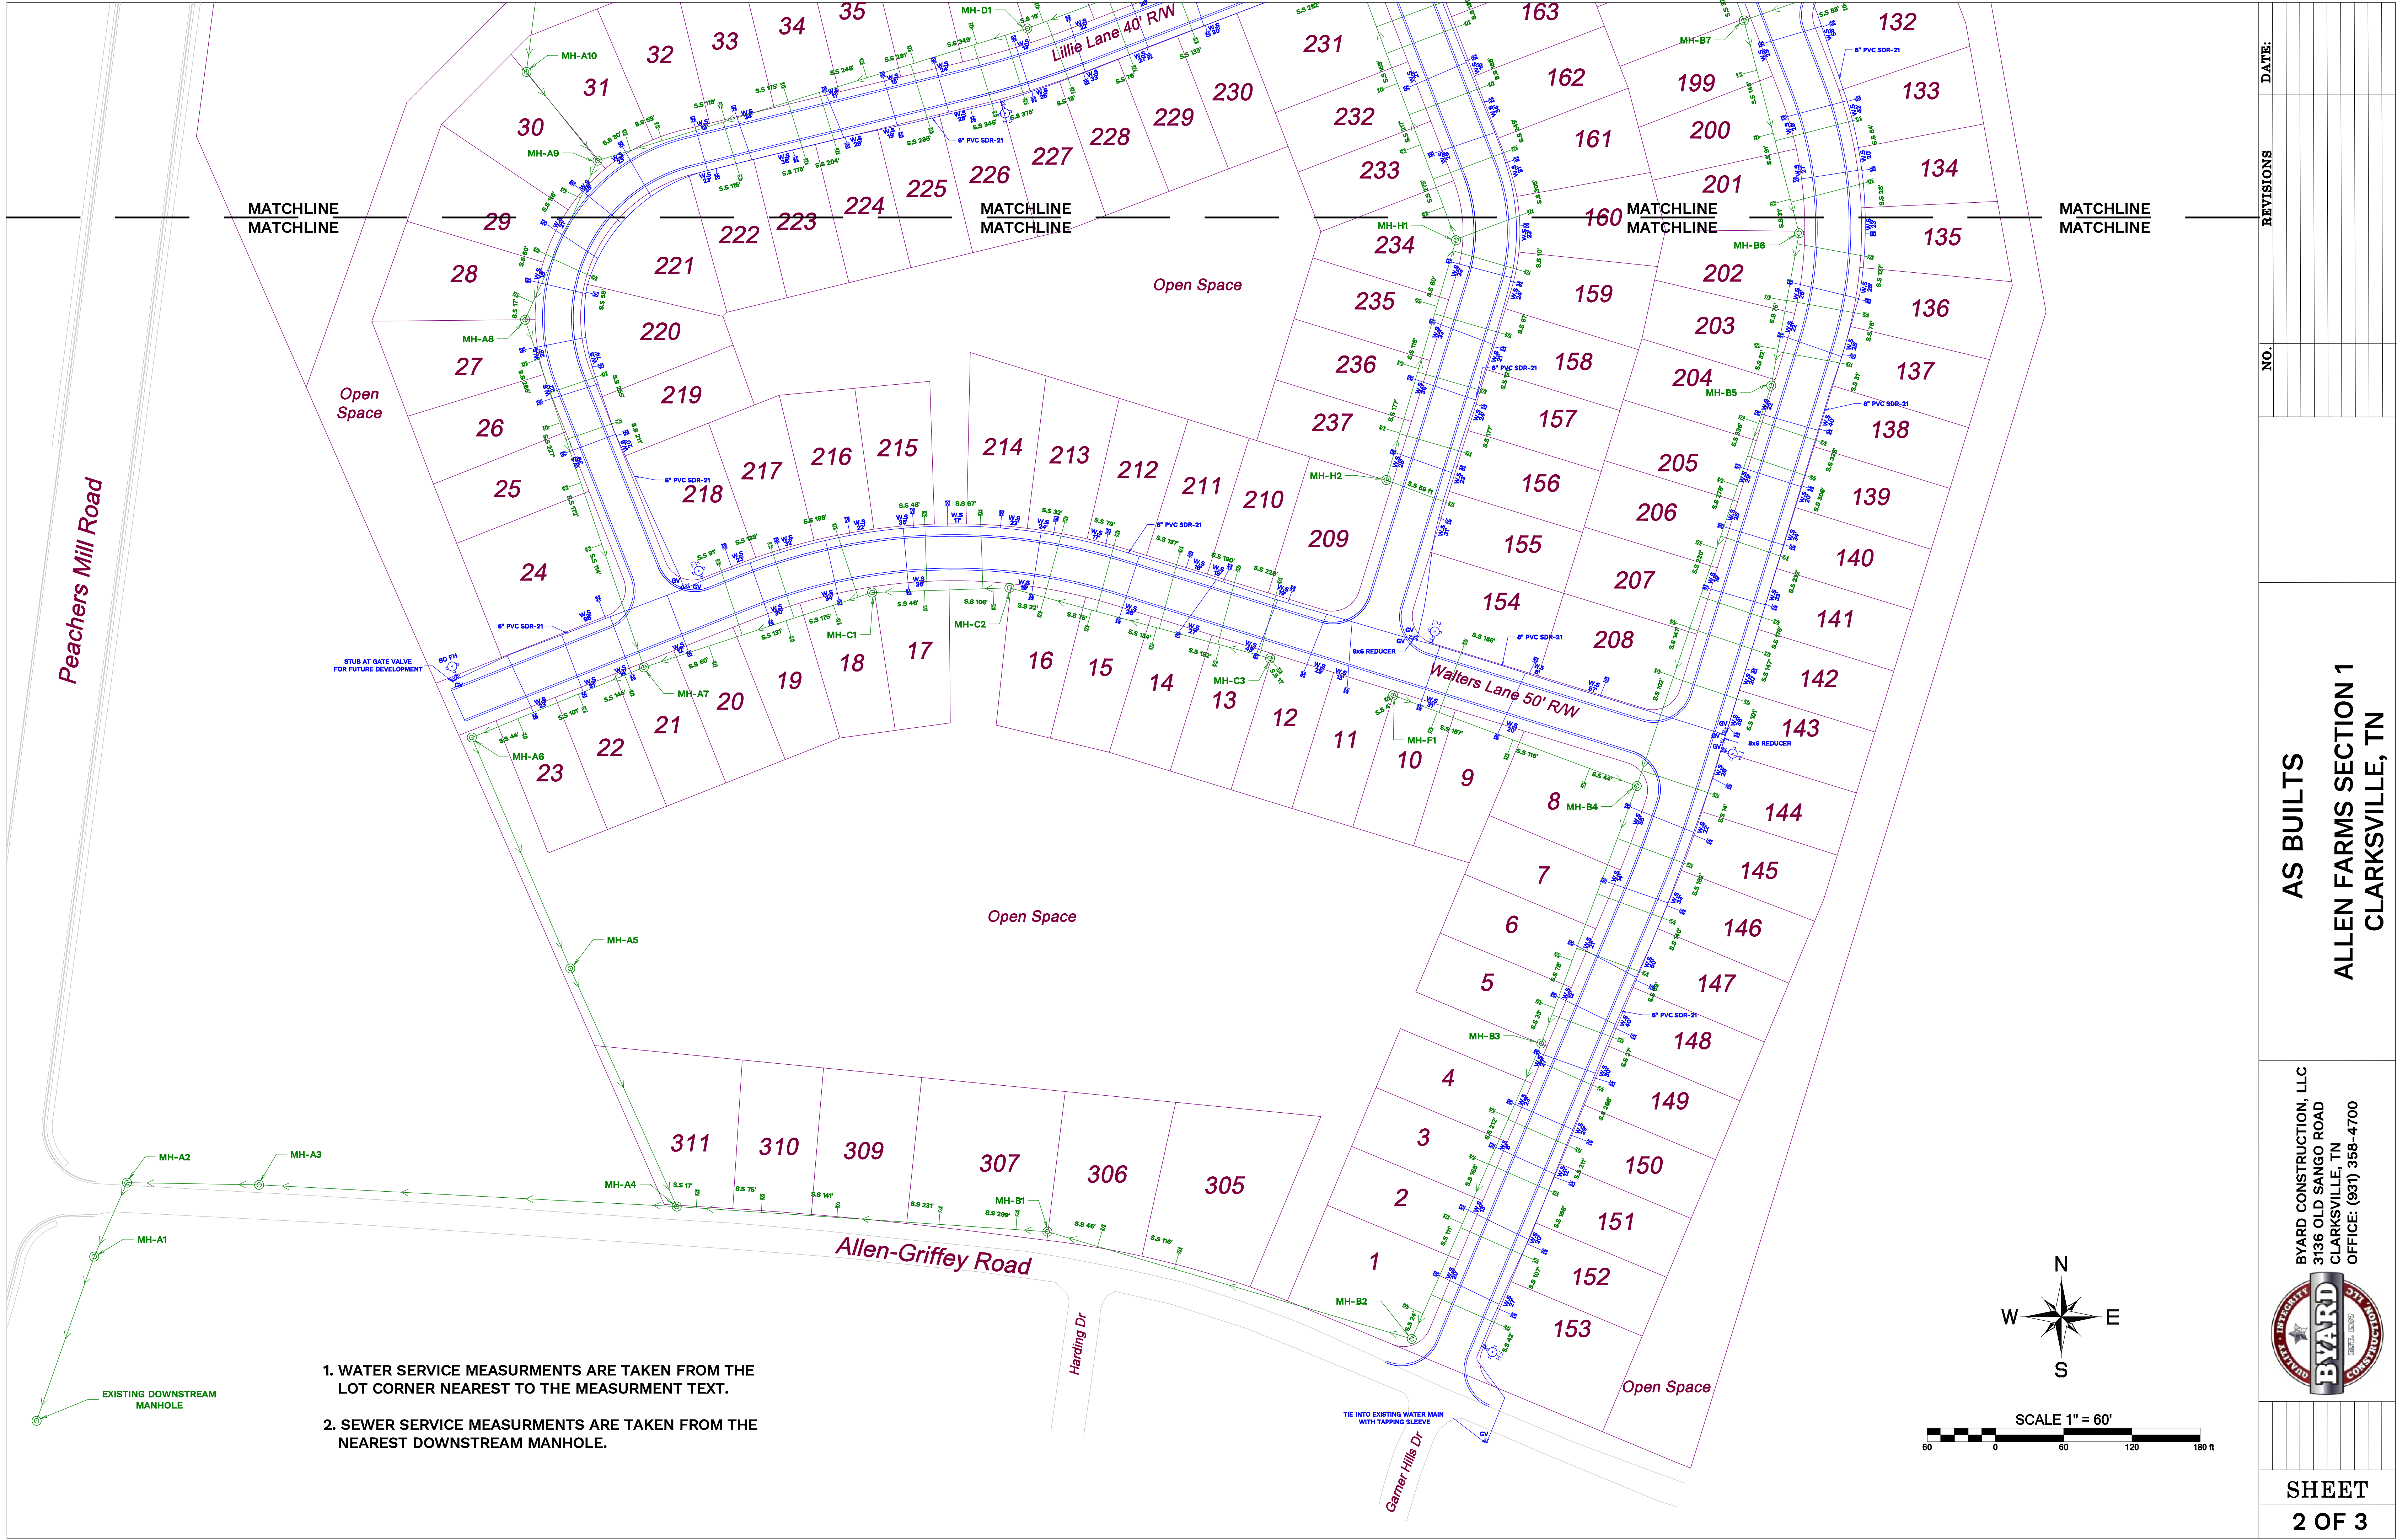


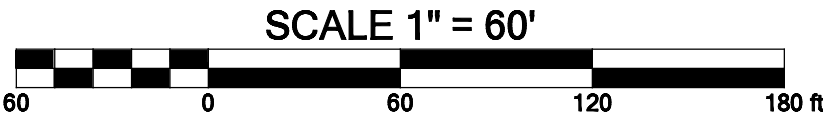

1. WATER SERVICE MEASURMENTS ARE TAKEN FROM THE LOT CORNER NEAREST TO THE MEASURMENT TEXT.
2. SEWER SERVICE MEASURMENTS ARE TAKEN FROM THE NEAREST DOWNSTREAM MANHOLE.

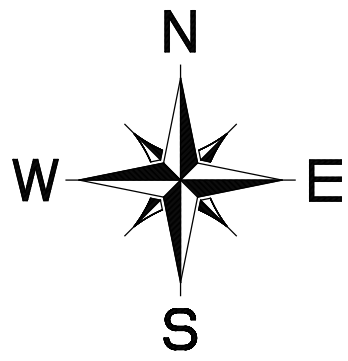

DATE:

REVISIONS

NO.

AS BUILTS

ALLEN FARMS SECTION 1

CLARKSVILLE, TN

BYARD CONSTRUCTION, LLC

3136 OLD SANGO ROAD



CLARKSVILLE, TN

OFFICE: (931) 358-4700

SHEET

2 OF 3

1. WATER SERVICE MEASUREMENTS ARE TAKEN FROM THE LOT CORNER NEAREST TO THE MEASUREMENT TEXT.
2. SEWER SERVICE MEASUREMENTS ARE TAKEN FROM THE NEAREST DOWNSTREAM MANHOLE.

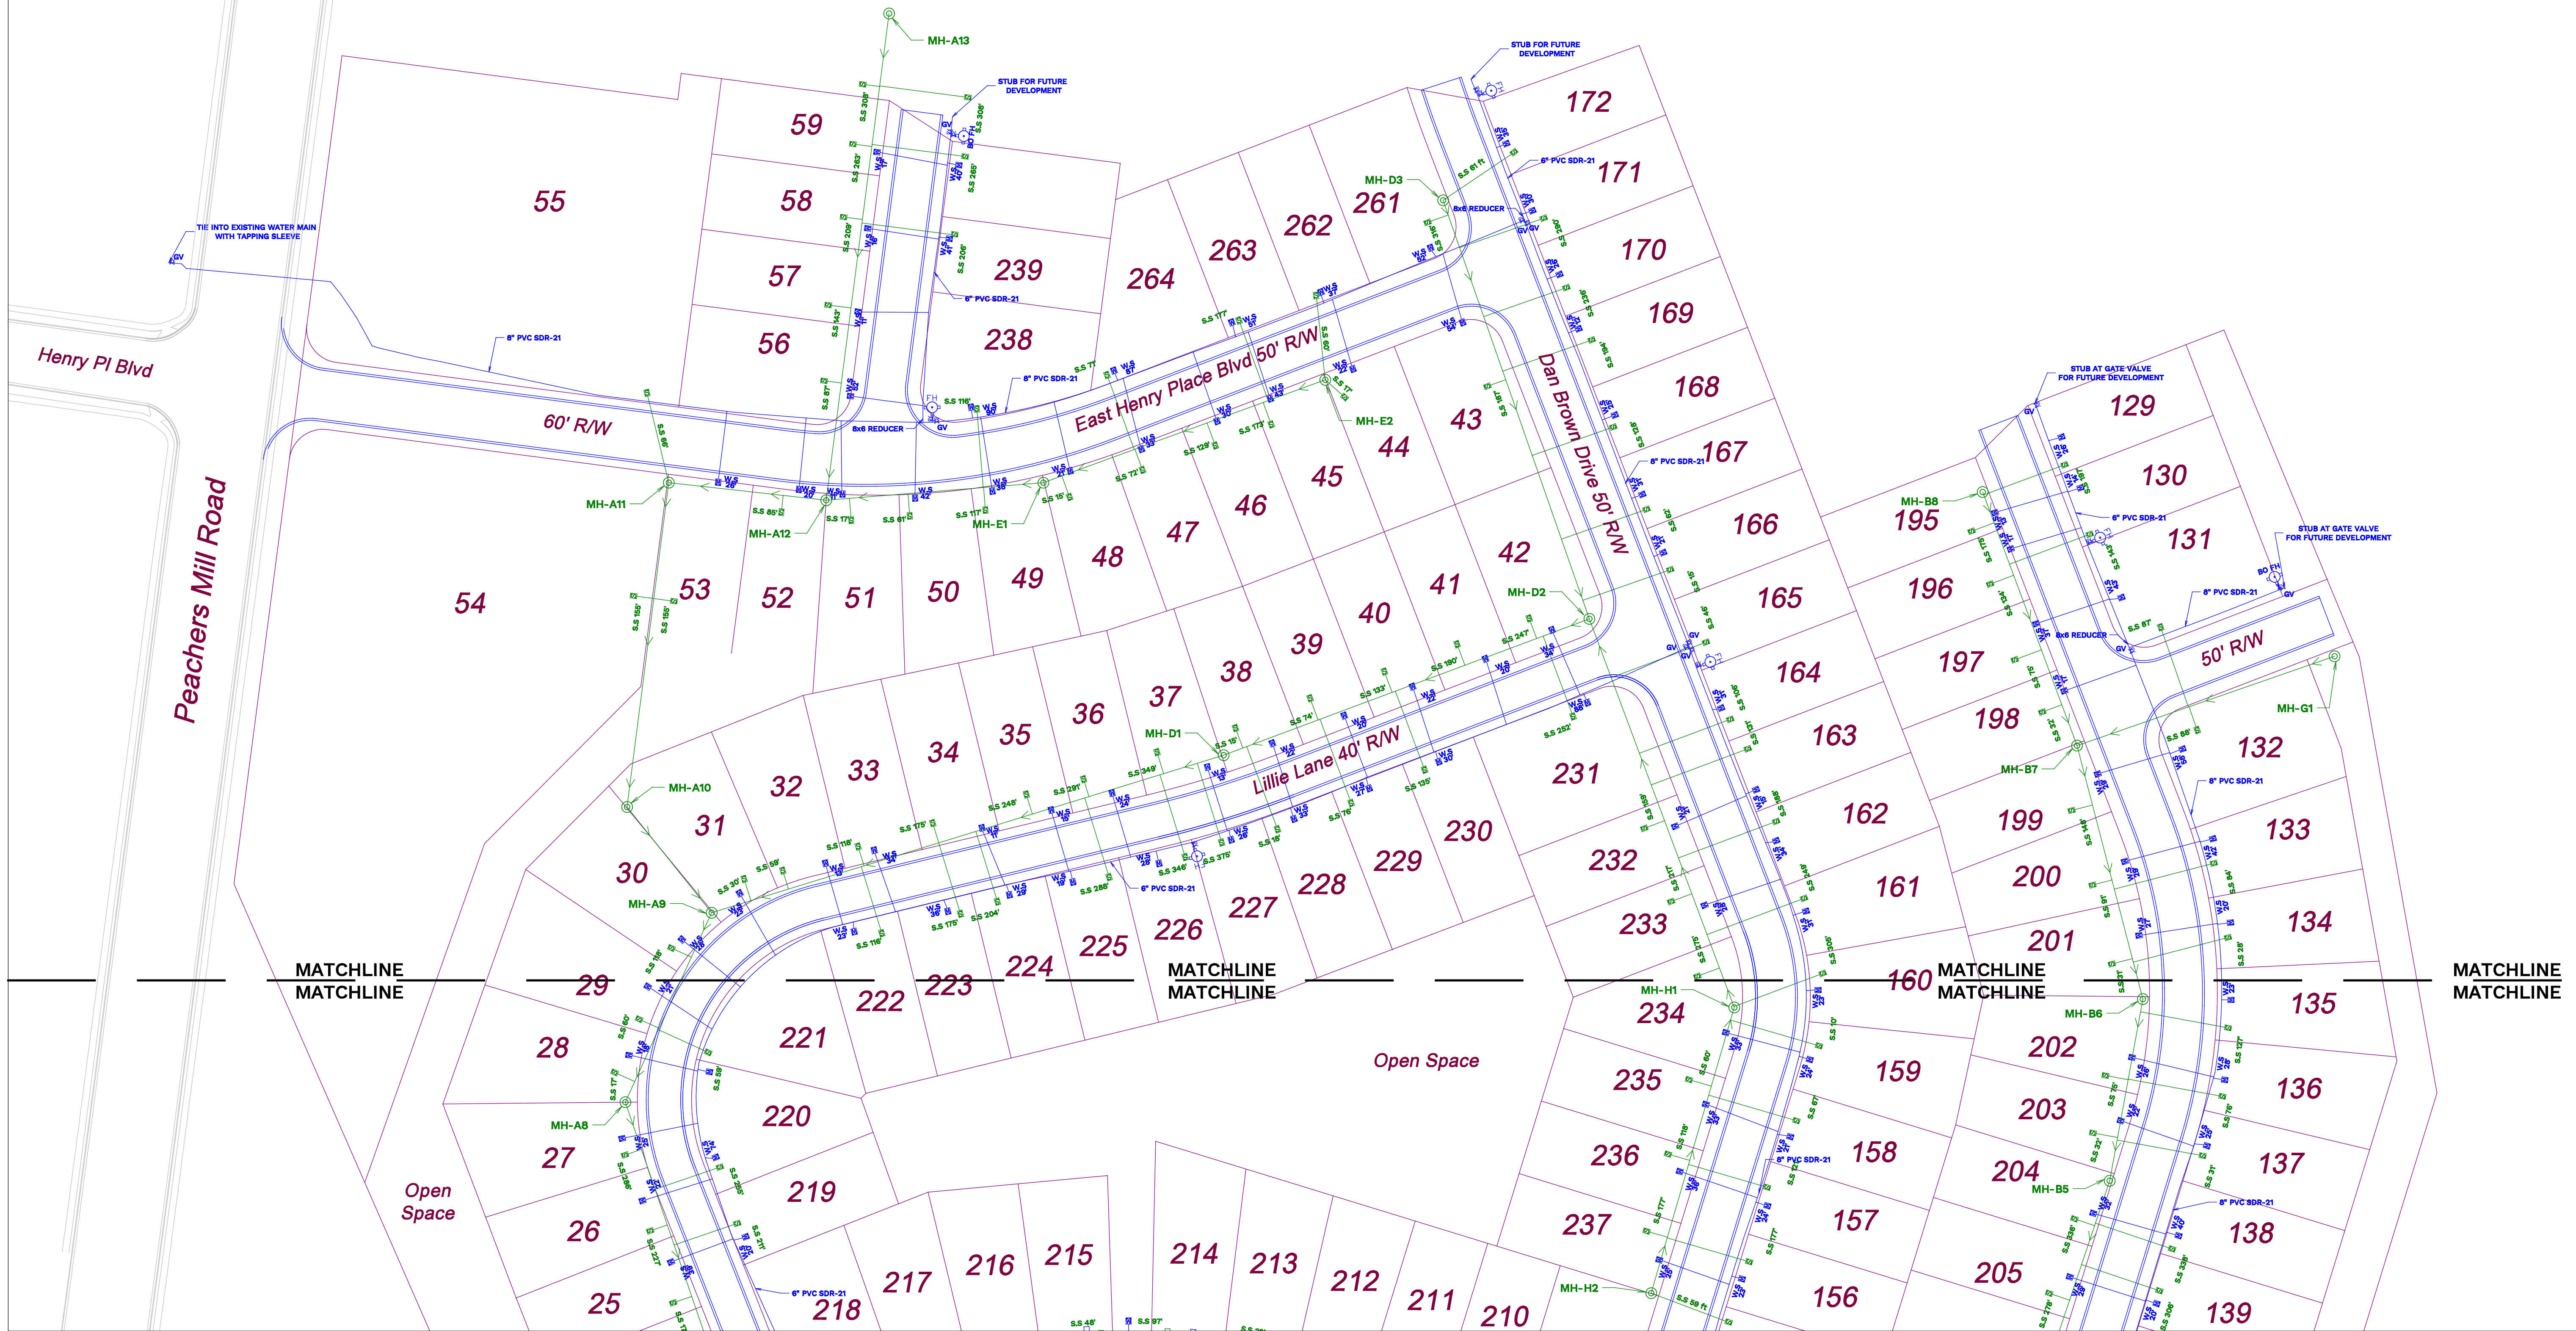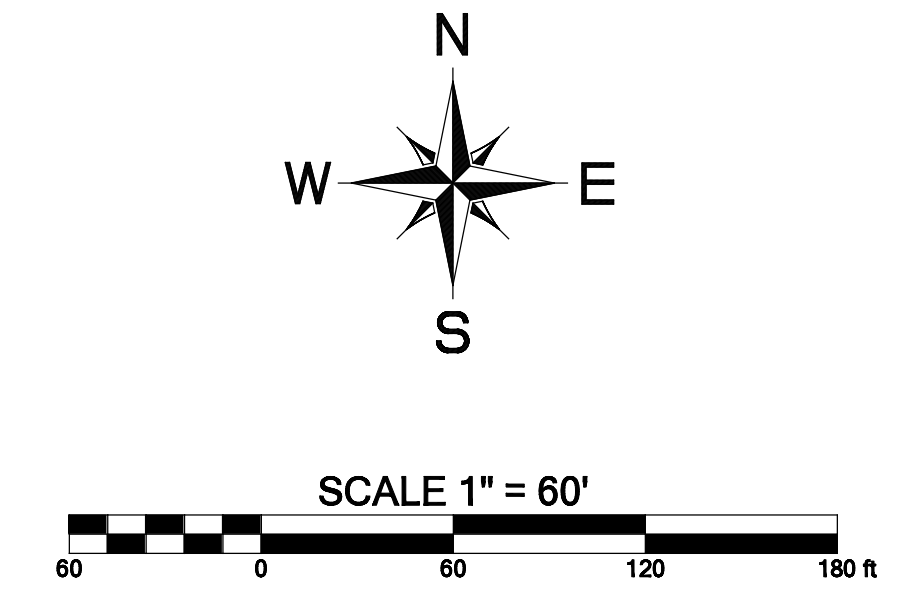

AS BUILTS

ALLEN FARMS SECTION 1

CLARKSVILLE, TN

CLARKSVILLE, TN
3136 OLD SANGO ROAD
OFFICE: (931) 358-4700



SHEET
3 OF 3

[illegible]