
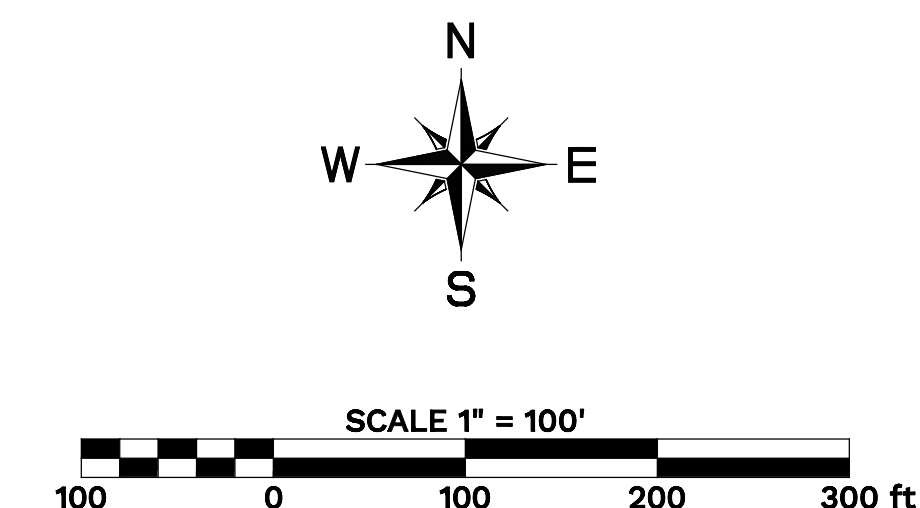


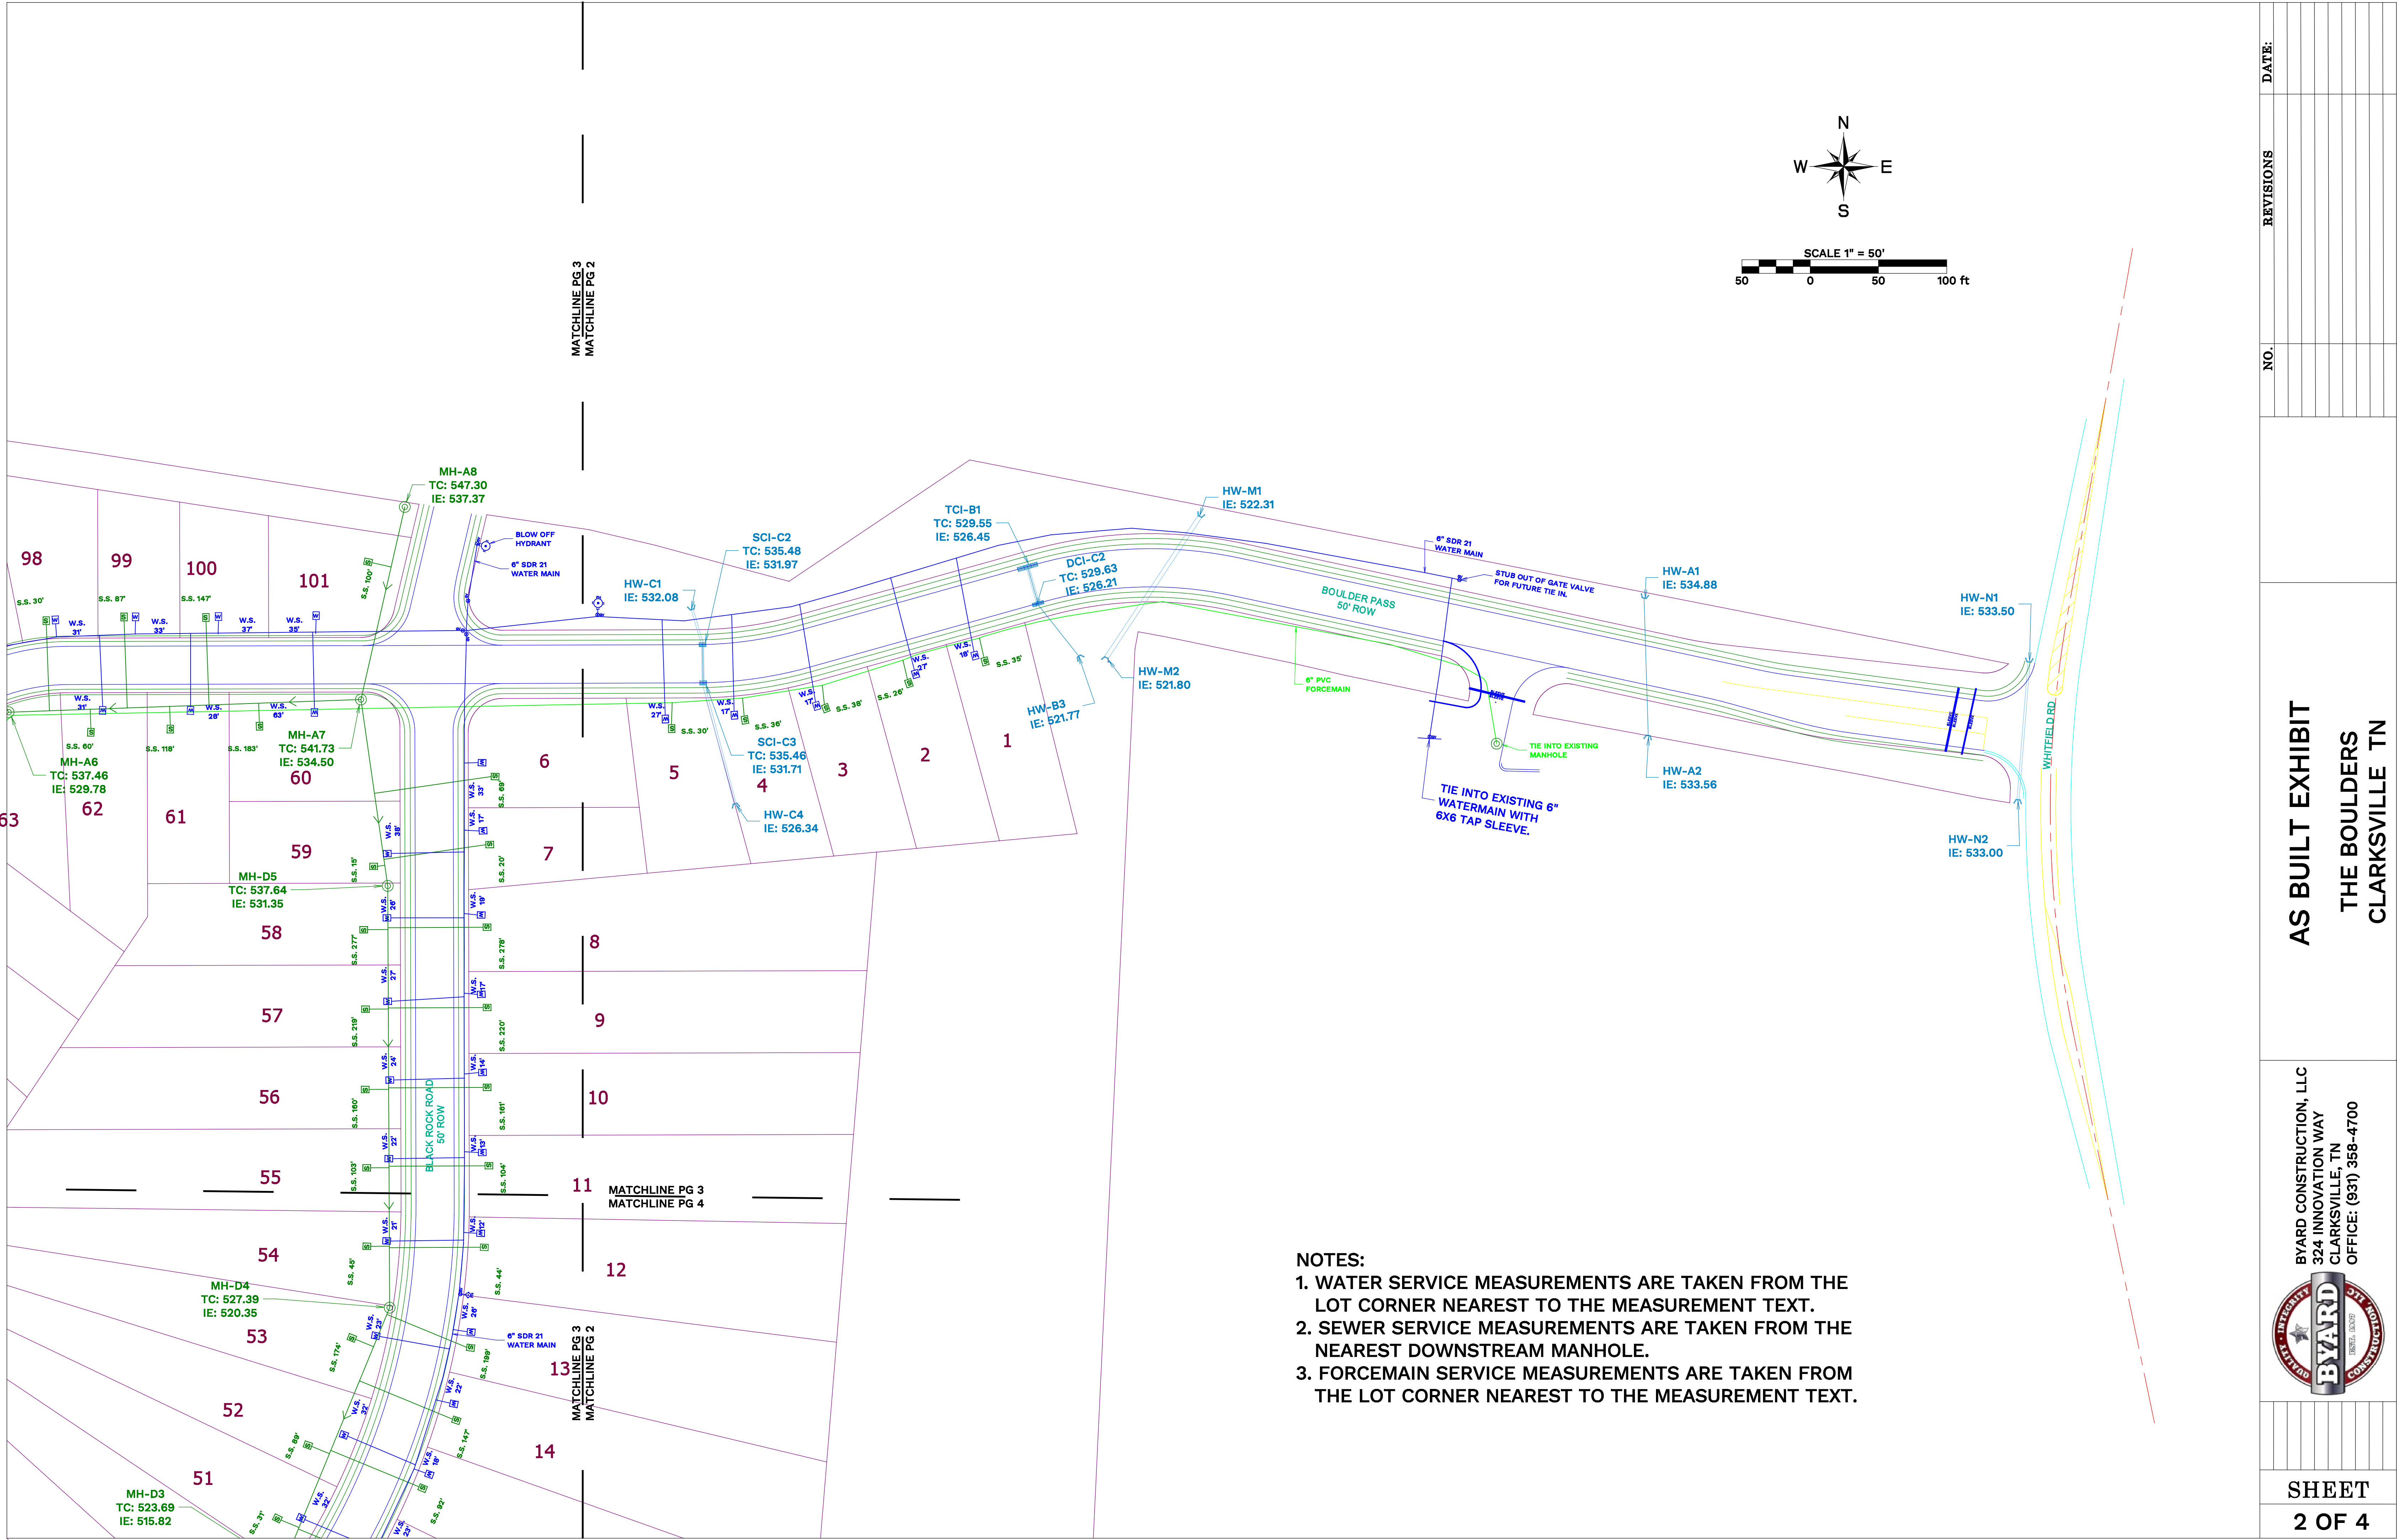


- NOTES:**
- 1. WATER SERVICE MEASUREMENTS ARE TAKEN FROM THE LOT CORNER NEAREST TO THE MEASUREMENT TEXT.**
 - 2. SEWER SERVICE MEASUREMENTS ARE TAKEN FROM THE NEAREST DOWNSTREAM MANHOLE.**
 - 3. FORCEMAIN SERVICE MEASUREMENTS ARE TAKEN FROM THE LOT CORNER NEAREST TO THE MEASUREMENT TEXT.**

[illegible]

[illegible][illegible]

-
- A north arrow pointing upwards, labeled with N, S, E, and W. Below it is a graphic scale bar with alternating black and white segments, labeled "SCALE 1" = 50'". The bar has markings for 50, 0, 50, and 100 ft.

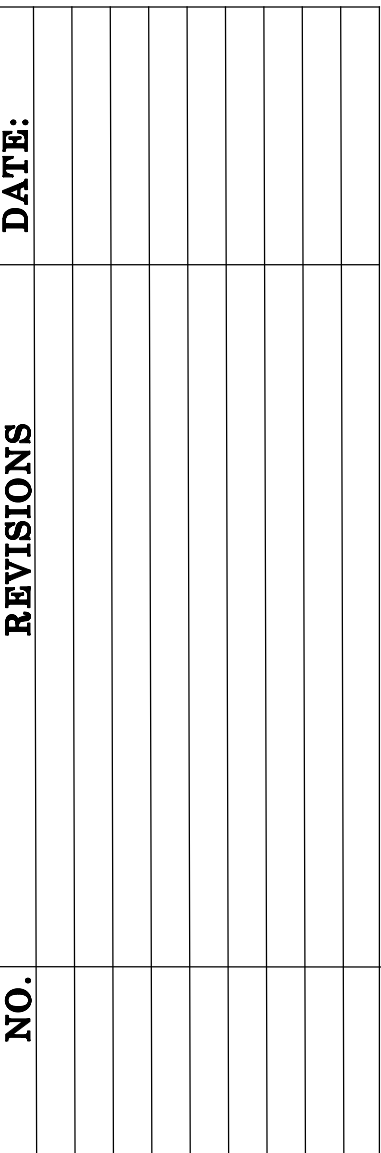

AS BUILT EXHIBIT
THE BOULDERS
CLARKSVILLE TN

BYARD CONSTRUCTION, LLC
324 INNOVATION WAY
CLARKSVILLE, TN
OFFICE: (931) 358-4700

