


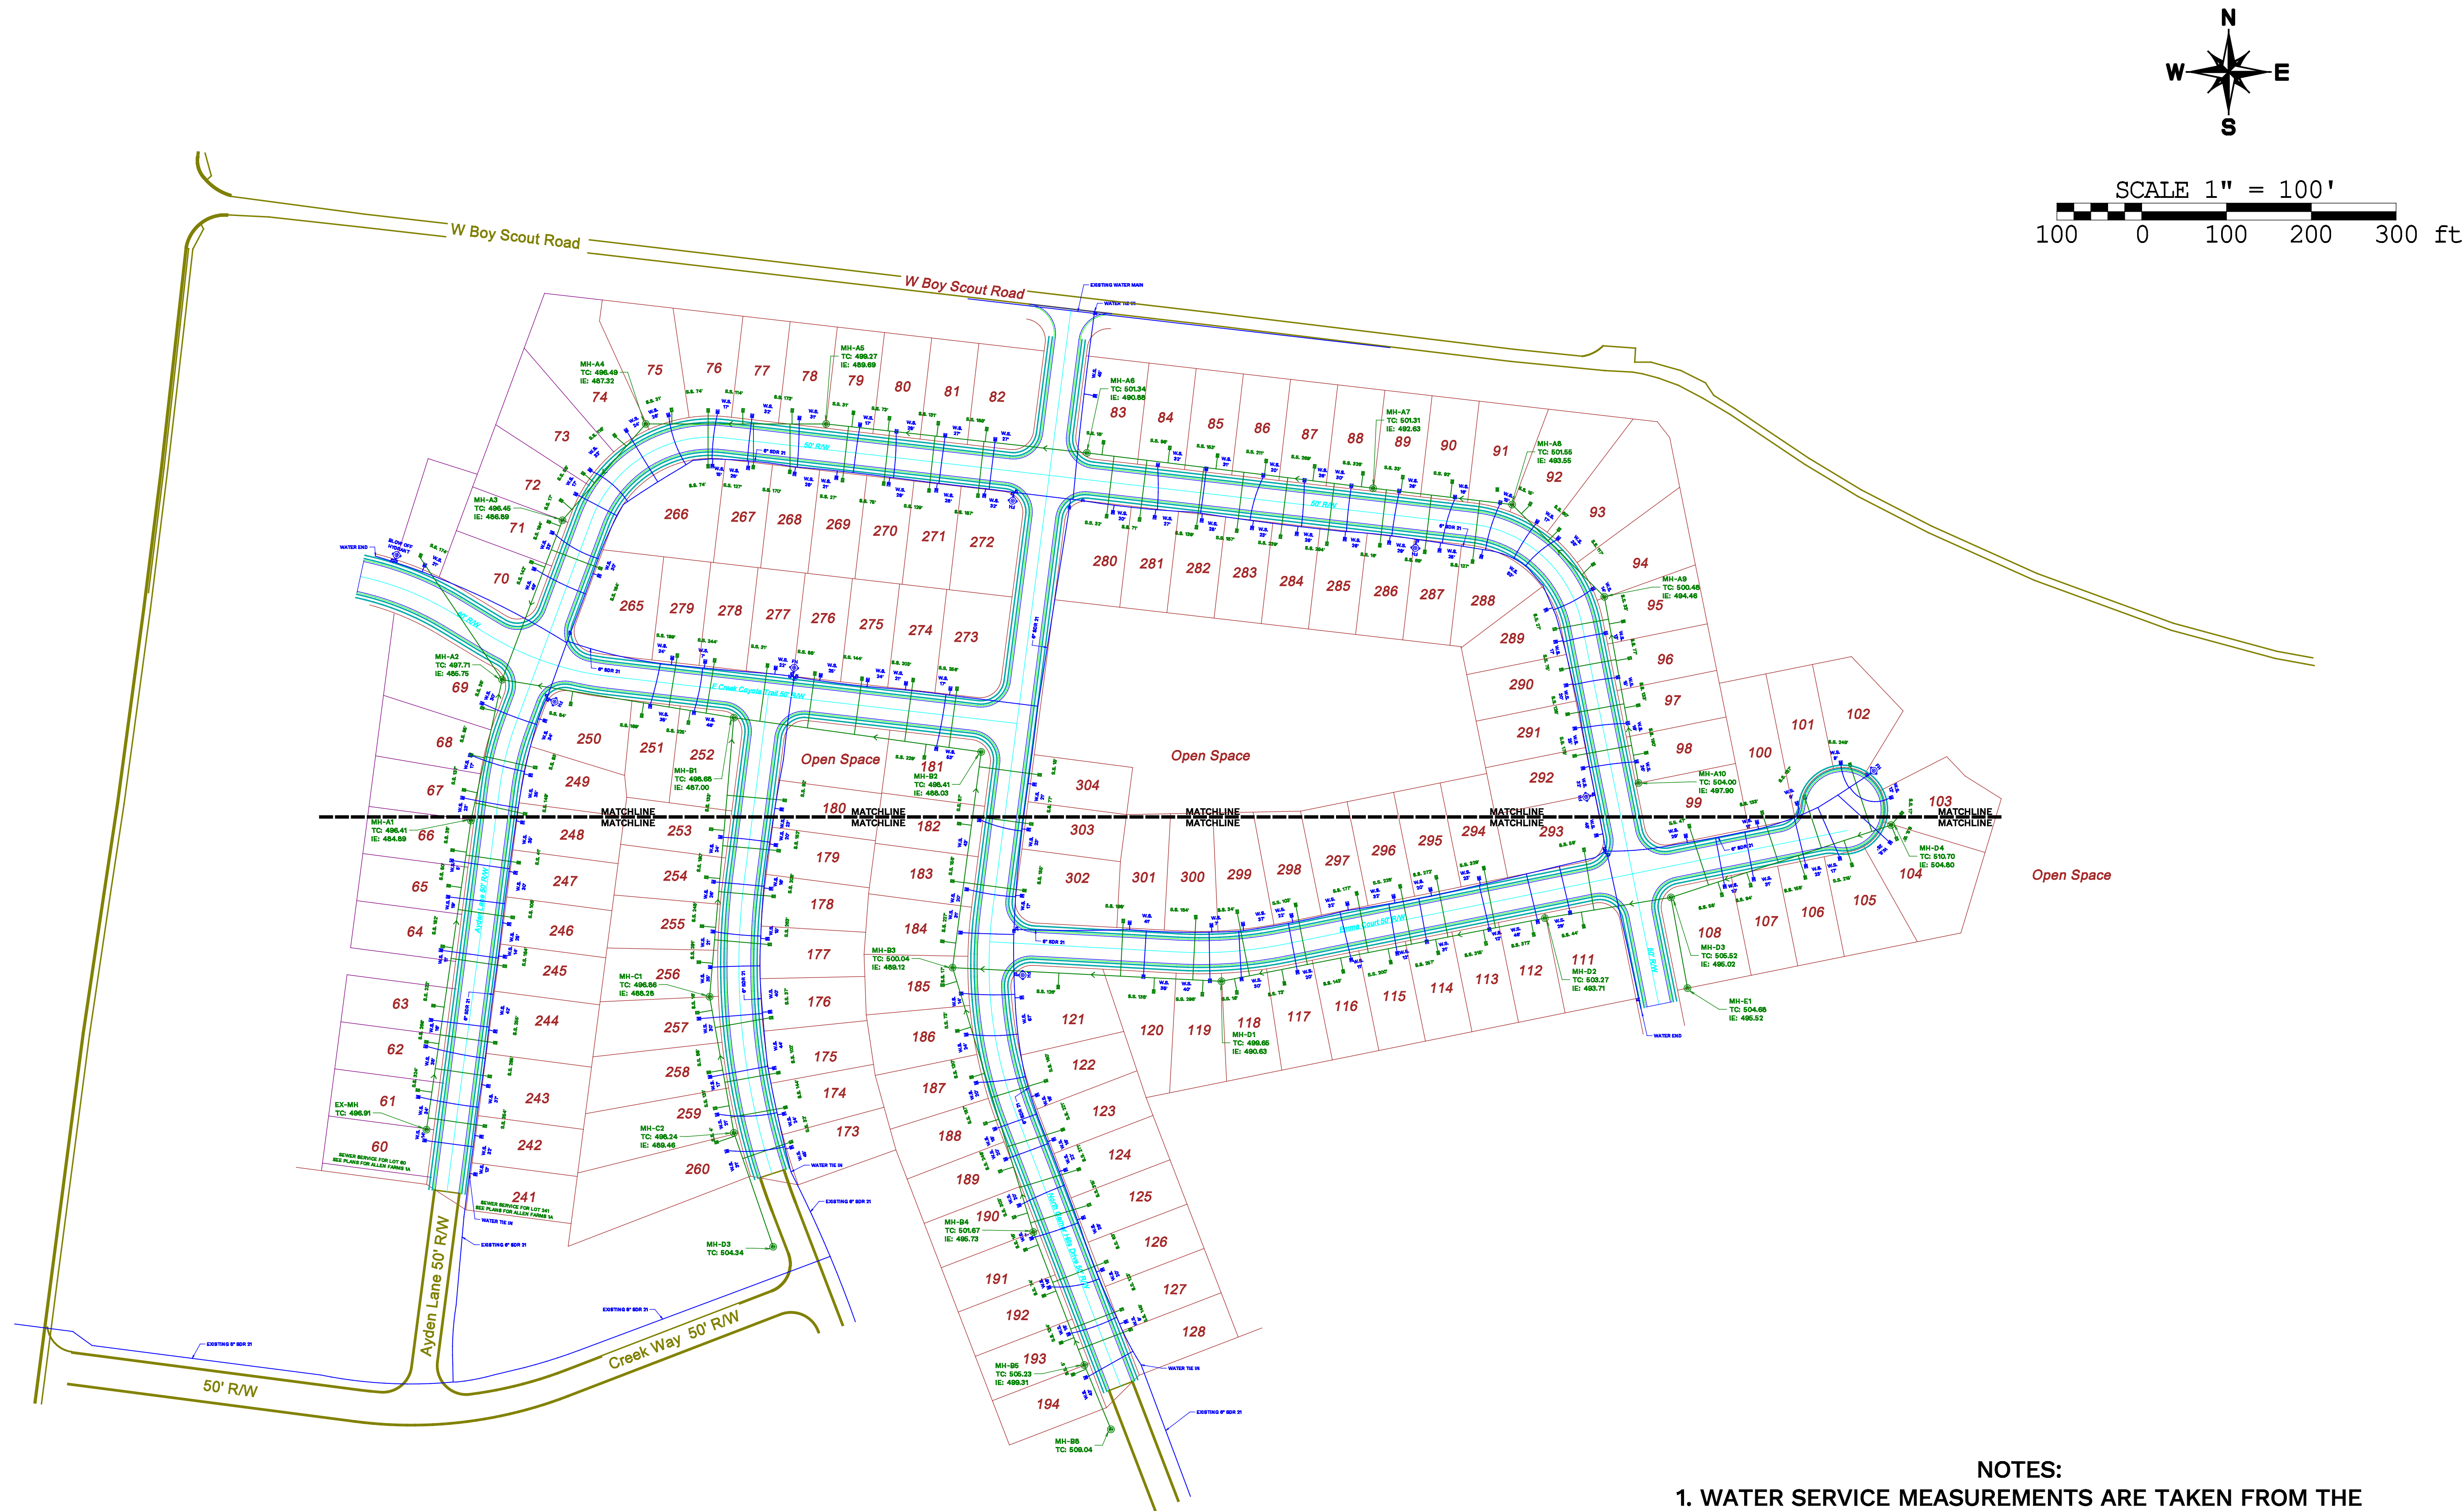

- NOTES:
1. WATER SERVICE MEASUREMENTS ARE TAKEN FROM THE LOT CORNER NEAREST TO THE MEASUREMENT TEXT.
  2. SEWER SERVICE MEASUREMENTS ARE TAKEN FROM THE NEAREST DOWNSTREAM MANHOLE.


**AS BUILT EXHIBIT**  
**ALLEN FARMS SECTION 1 PHASE 2**  
**CLARKSVILLE, TN**

BYARD CONSTRUCTION, LLC  
324 INNOVATION WAY  
CLARKSVILLE, TN  
(931) 358 - 4700






- NOTES:
- 1. WATER SERVICE MEASUREMENTS ARE TAKEN FROM THE LOT CORNER NEAREST TO THE MEASUREMENT TEXT.
  - 2. SEWER SERVICE MEASUREMENTS ARE TAKEN FROM THE NEAREST DOWNSTREAM MANHOLE.

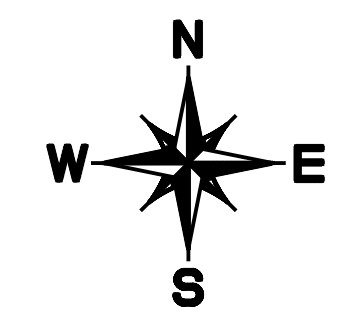

SCALE 1" = 60'

60 0 60 120 180 ft

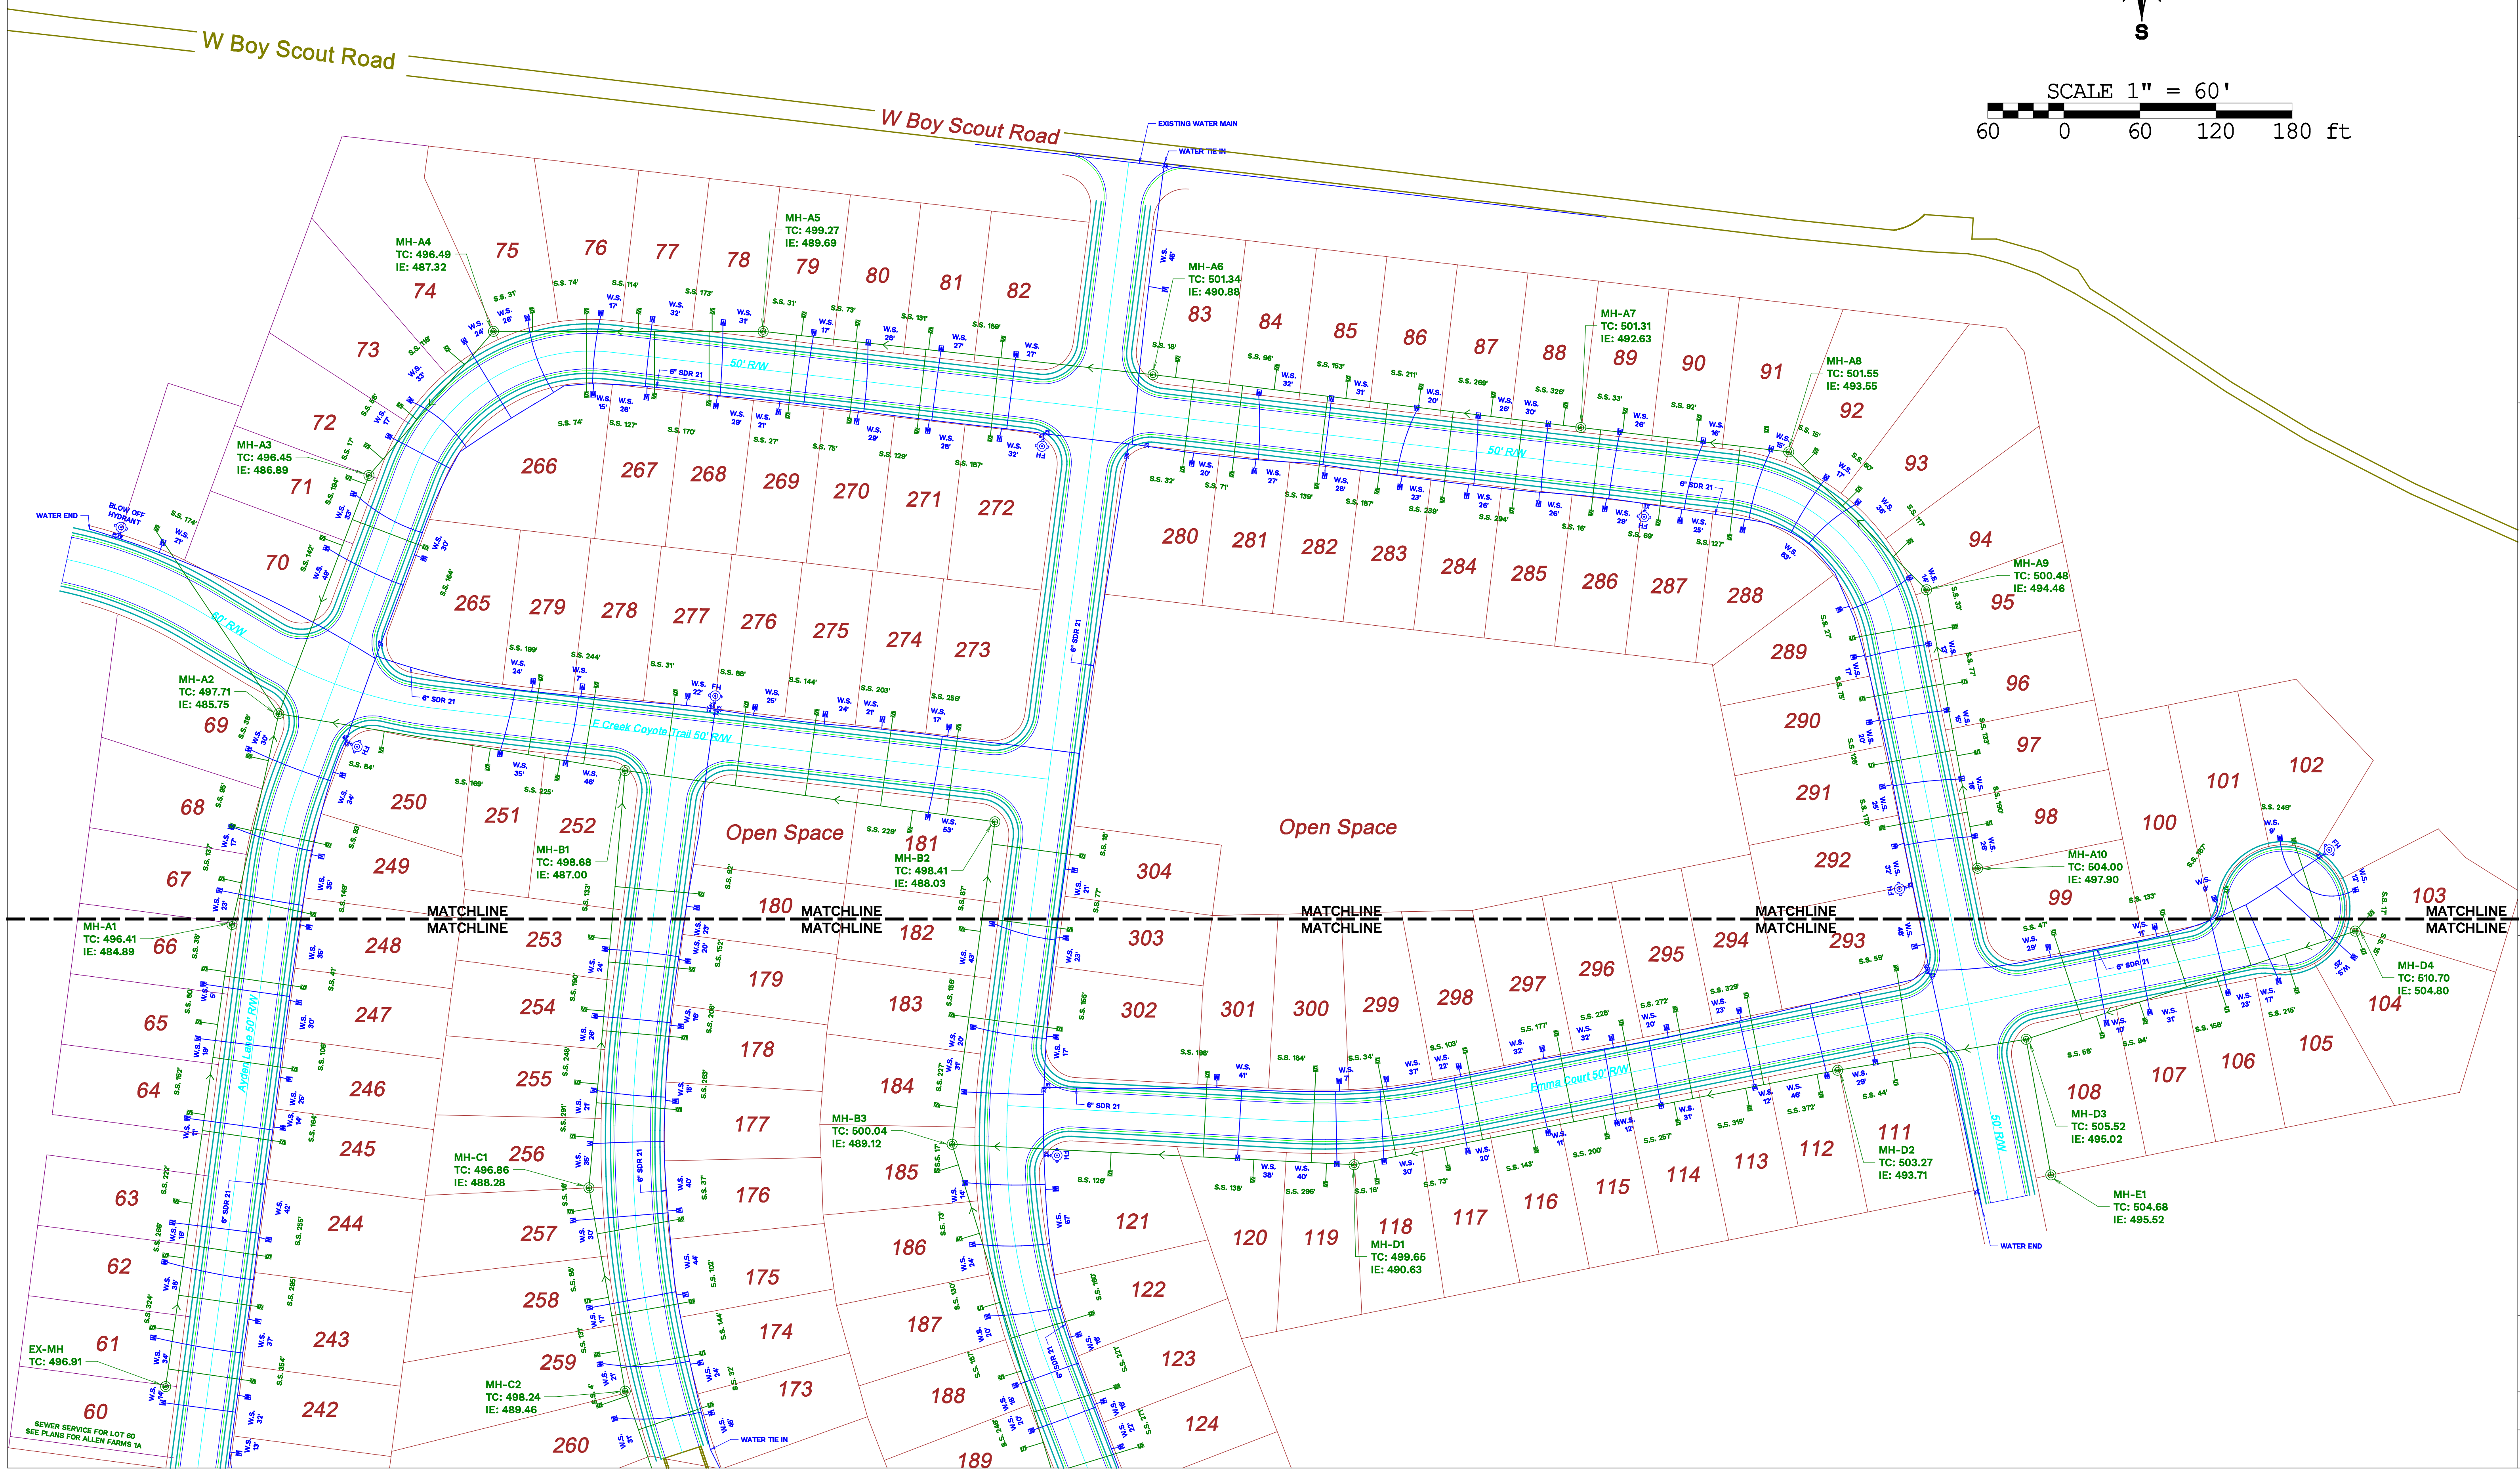

| NO. | REVISIONS |  | DATE: |
|-----|-----------|--|-------|
|     |           |  |       |
|     |           |  |       |
AS BUILT EXHIBIT

ALLEN FARMS SECTION 1 PHASE 2

CLARKSVILLE, TN

BYARD CONSTRUCTION, LLC

324 INNOVATION WAY

CLARKSVILLE, TN

(931) 358 - 4700





