

- NOTES:**
1. SEWER SERVICE MEASUREMENTS ARE TAKEN FROM THE NEAREST DOWNSTREAM MANHOLE.
  2. WATER SERVICE MEASUREMENTS ARE TAKEN FROM THE LOT CORNER CLOSEST TO THE TEXT.
  3. THE ORANGE LINE SHOWS THE BOUNDARY OF PHASE 1A.

NO.	REVISIONS	DATE:

**AS BUILT EXHIBIT  
LISEEBEE FIELDS  
CLARKSVILLE, TN**

BYARD CONSTRUCTION, LLC.  
324 INNOVATION WAY  
CLARKSVILLE, TN  
OFFICE: (931) 358 - 4700





MATCHLINE 1  
MATCHLINE 2



MATCHLINE 2  
MATCHLINE 1  
MATCHLINE 2

MATCHLINE 1  
MATCHLINE 2  
MATCHLINE 1  
MATCHLINE 2


MATCHLINE 1  
MATCHLINE 4

MATCHLINE 1  
MATCHLINE 4

MATCHLINE 1  
MATCHLINE 4

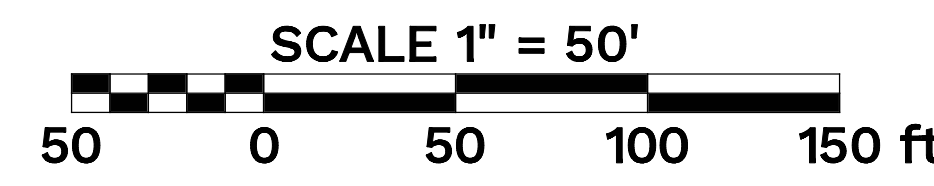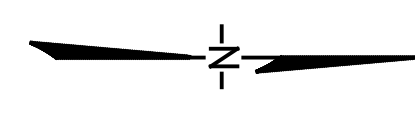

NOTES:  
 1. SEWER SERVICE MEASUREMENTS ARE TAKEN FROM THE NEAREST DOWNSTREAM MANHOLE.  
 2. WATER SERVICE MEASUREMENTS ARE TAKEN FROM THE LOT CORNER CLOSEST TO THE TEXT.  
 3. THE ORANGE LINE SHOWS THE BOUNDARY OF PHASE 1A.

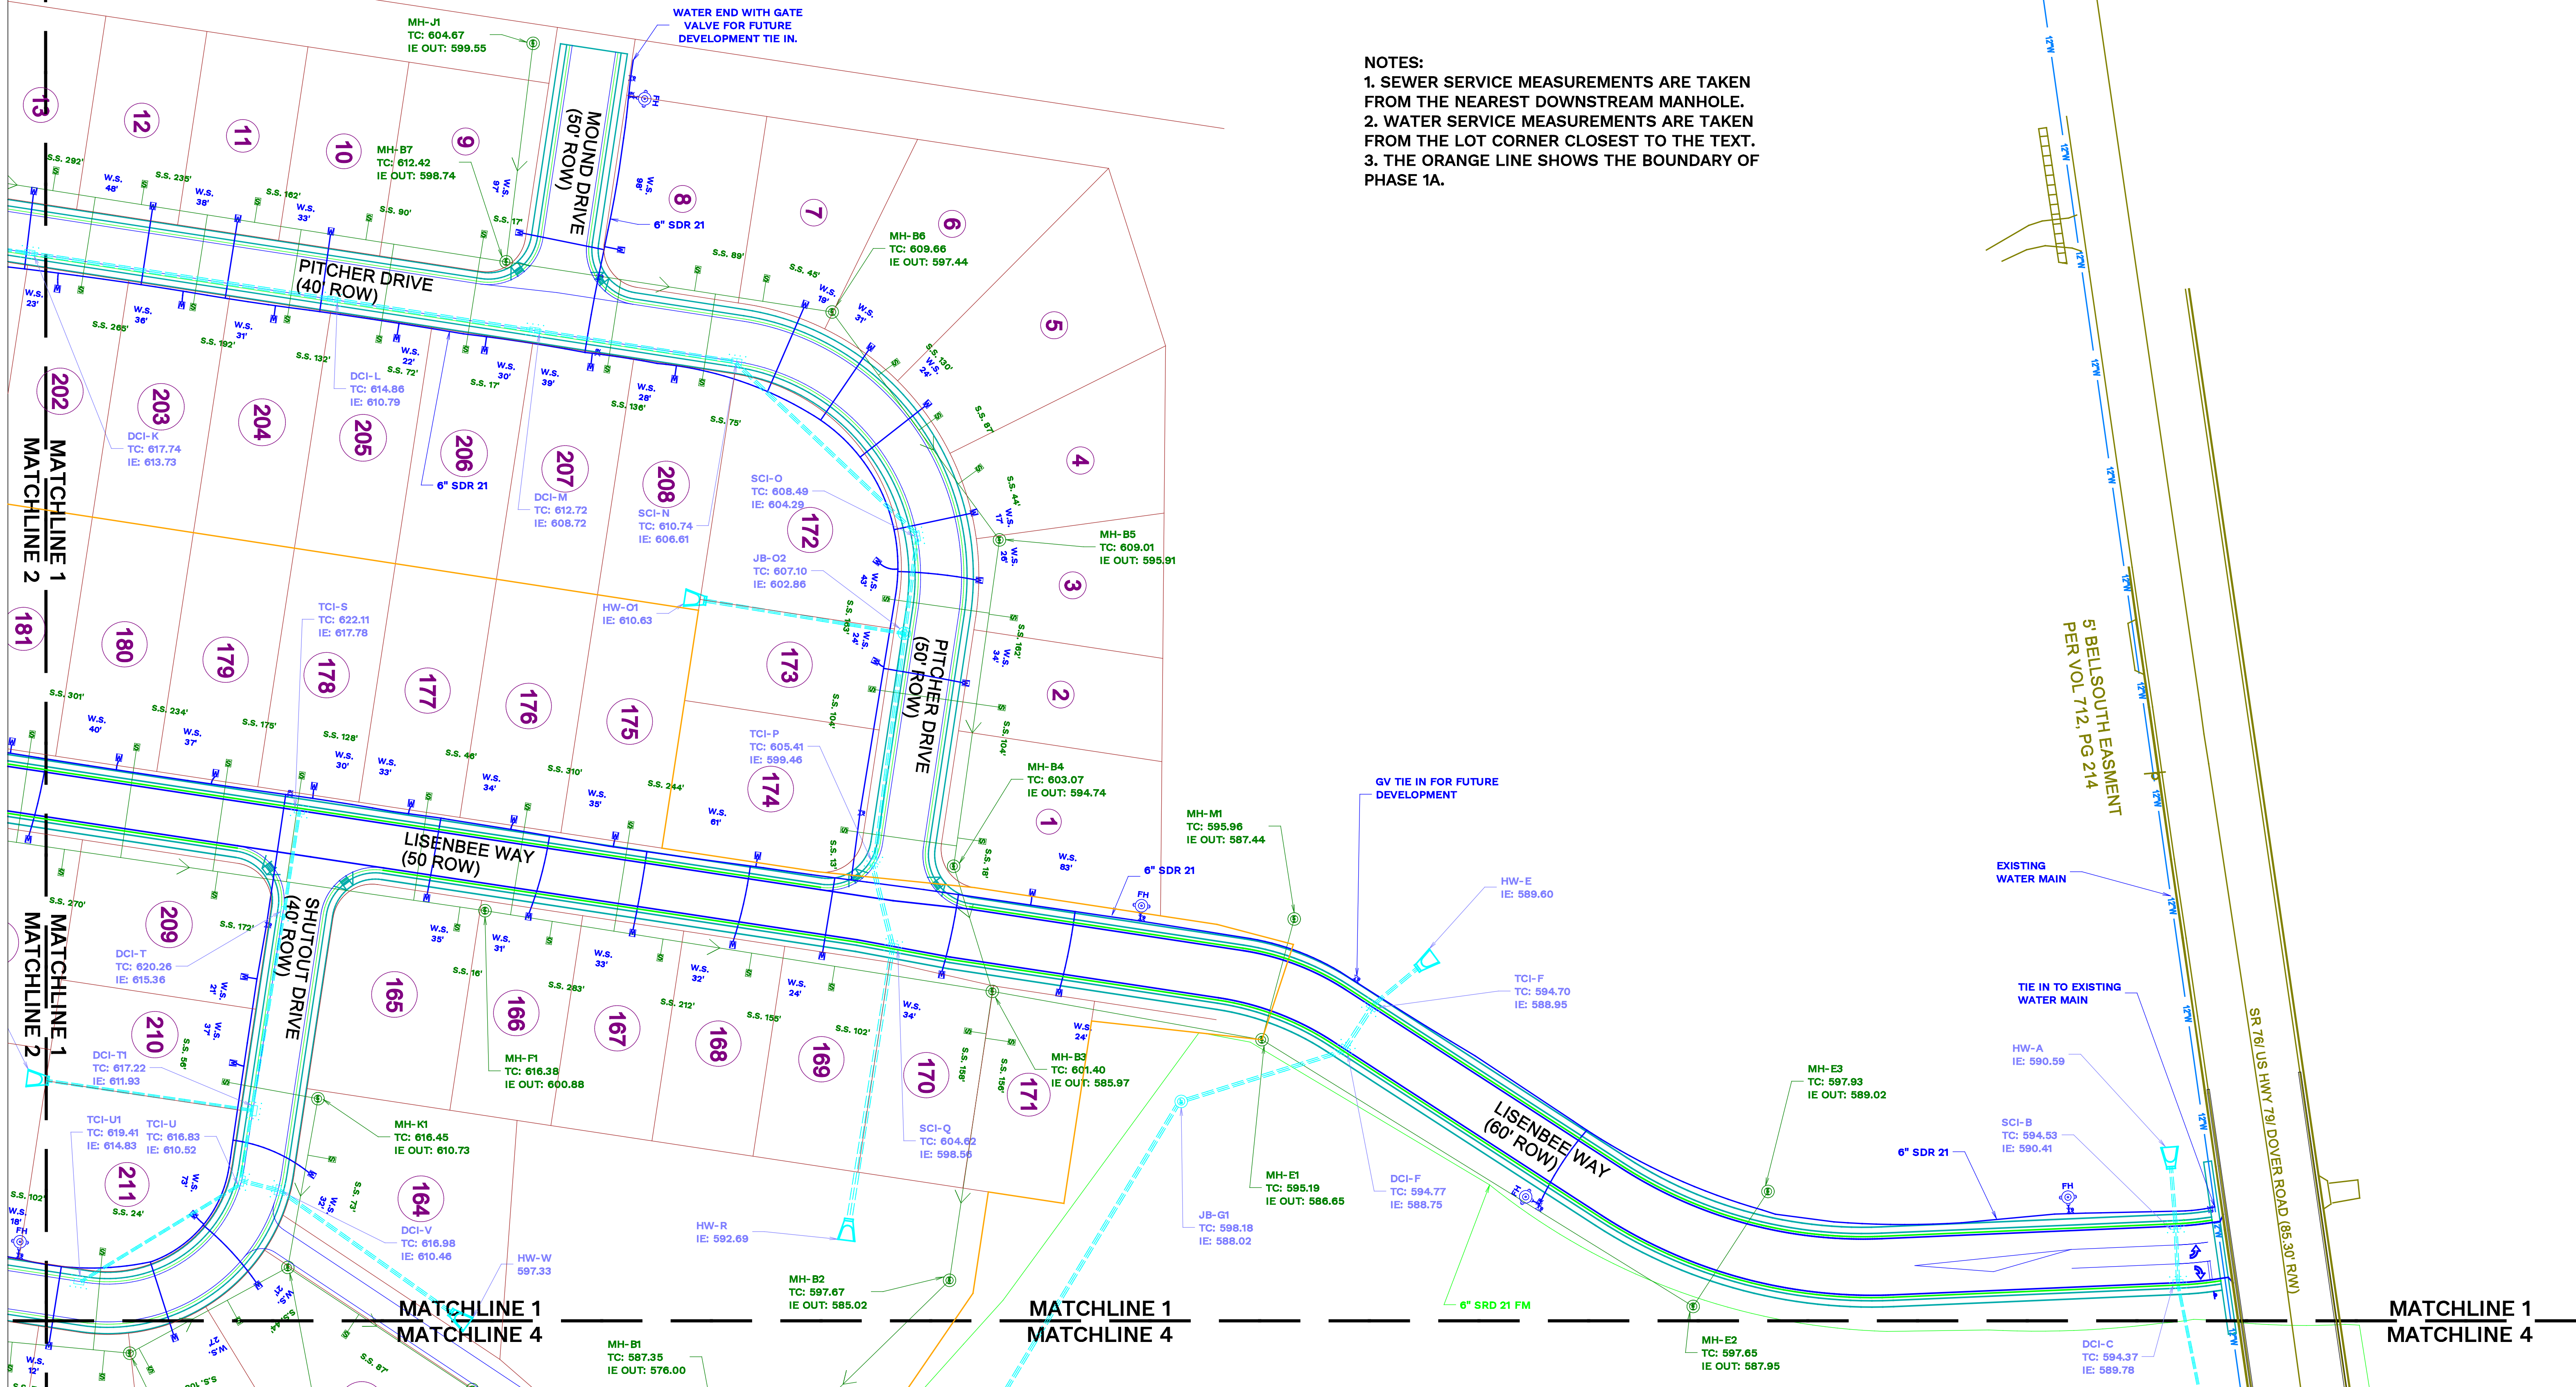

NO.	REVISIONS	DATE:

AS BUILT EXHIBIT  
 LISEBEE FIELDS  
 CLARKSVILLE, TN

BYARD CONSTRUCTION, LLC.  
 324 INNOVATION WAY  
 CLARKSVILLE, TN  
 OFFICE: (931) 358-4700








DATE	
REVISION	
NO.	

CLARKSON  
 SENSENILE  
 SV

OFFICE: (631) 351-8974  
 CLARKSVILLE, TN 37041  
 424 W. INNOVATION WAY  
 BAYBORN CONSTRUCTION

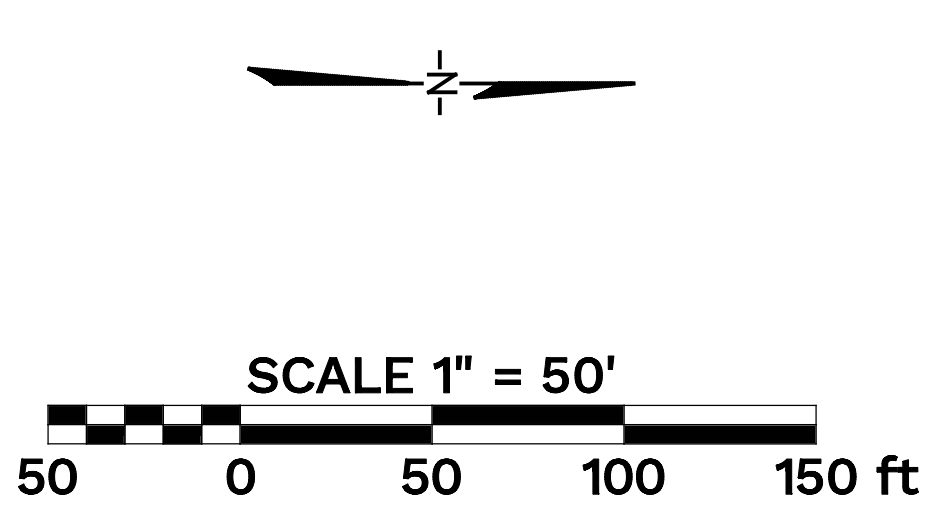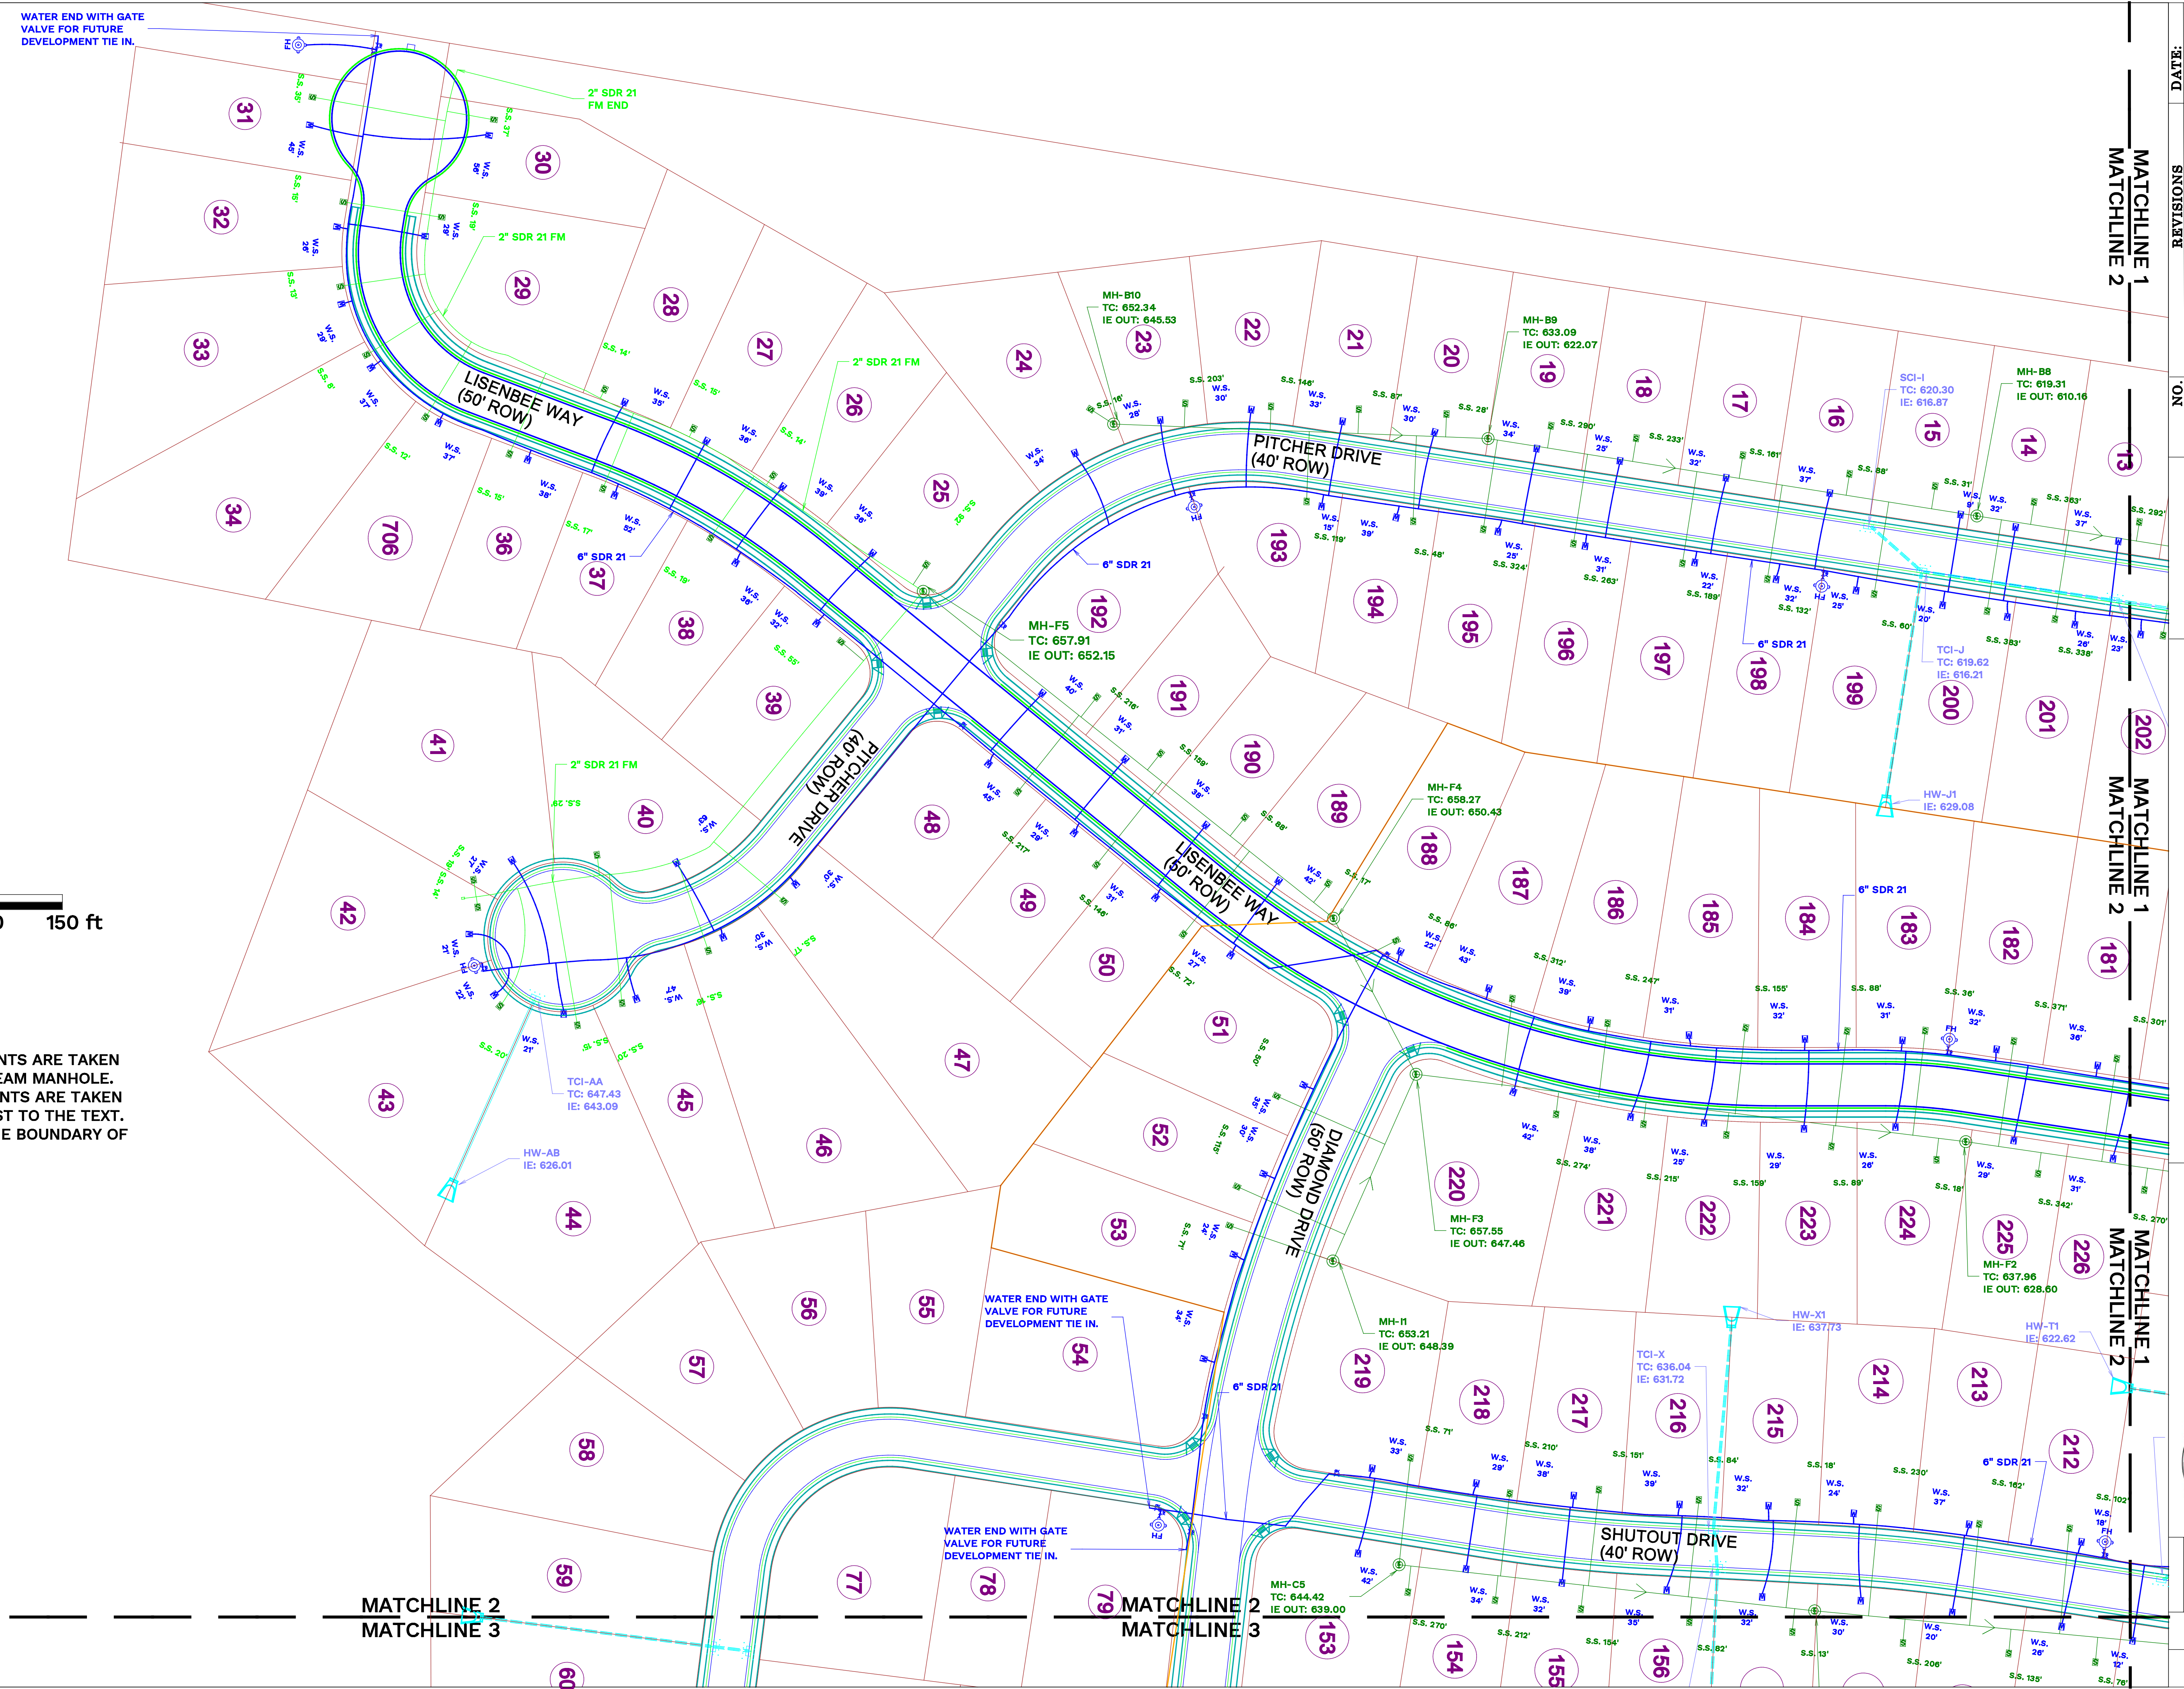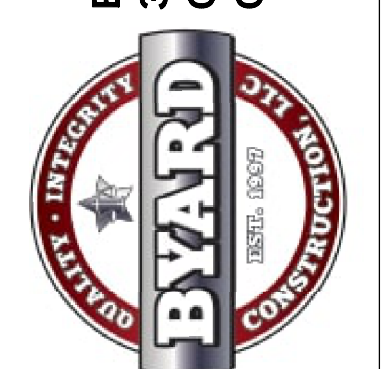

- NOTES:
- SEWER SERVICE MEASUREMENTS ARE TAKEN FROM THE NEAREST DOWNSTREAM MANHOLE.
  - WATER SERVICE MEASUREMENTS ARE TAKEN FROM THE LOT CORNER CLOSEST TO THE TEXT.
  - THE ORANGE LINE SHOWS THE BOUNDARY OF PHASE 1A.

MATCHLINE 2  
MATCHLINE 3

MATCHLINE 2  
MATCHLINE 3

MATCHLINE 2  
MATCHLINE 3

MATCHLINE 1  
MATCHLINE 2

MATCHLINE 1  
MATCHLINE 2

MATCHLINE 1  
MATCHLINE 2

WATER END WITH GATE VALVE FOR FUTURE DEVELOPMENT TIE IN.


WATER END WITH GATE VALVE FOR FUTURE DEVELOPMENT TIE IN.

WATER END WITH GATE VALVE FOR FUTURE DEVELOPMENT TIE IN.



DATE	
REVISION	
NO.	
<b>BYARD CONSTRUCTION</b> <b>CLARKSVILLE, TN</b> <b>OFFICE: (615) 351-3557</b> <b>324 INNOVATION WAY</b> <b>CLARKSVILLE, TN 37041</b>	
	
<b>SHEET</b> <b>4 OF 5</b>	

11011 CLARKSVILLE, TN  
 11011 FIELDS  
 11011 SIBBIT LANE

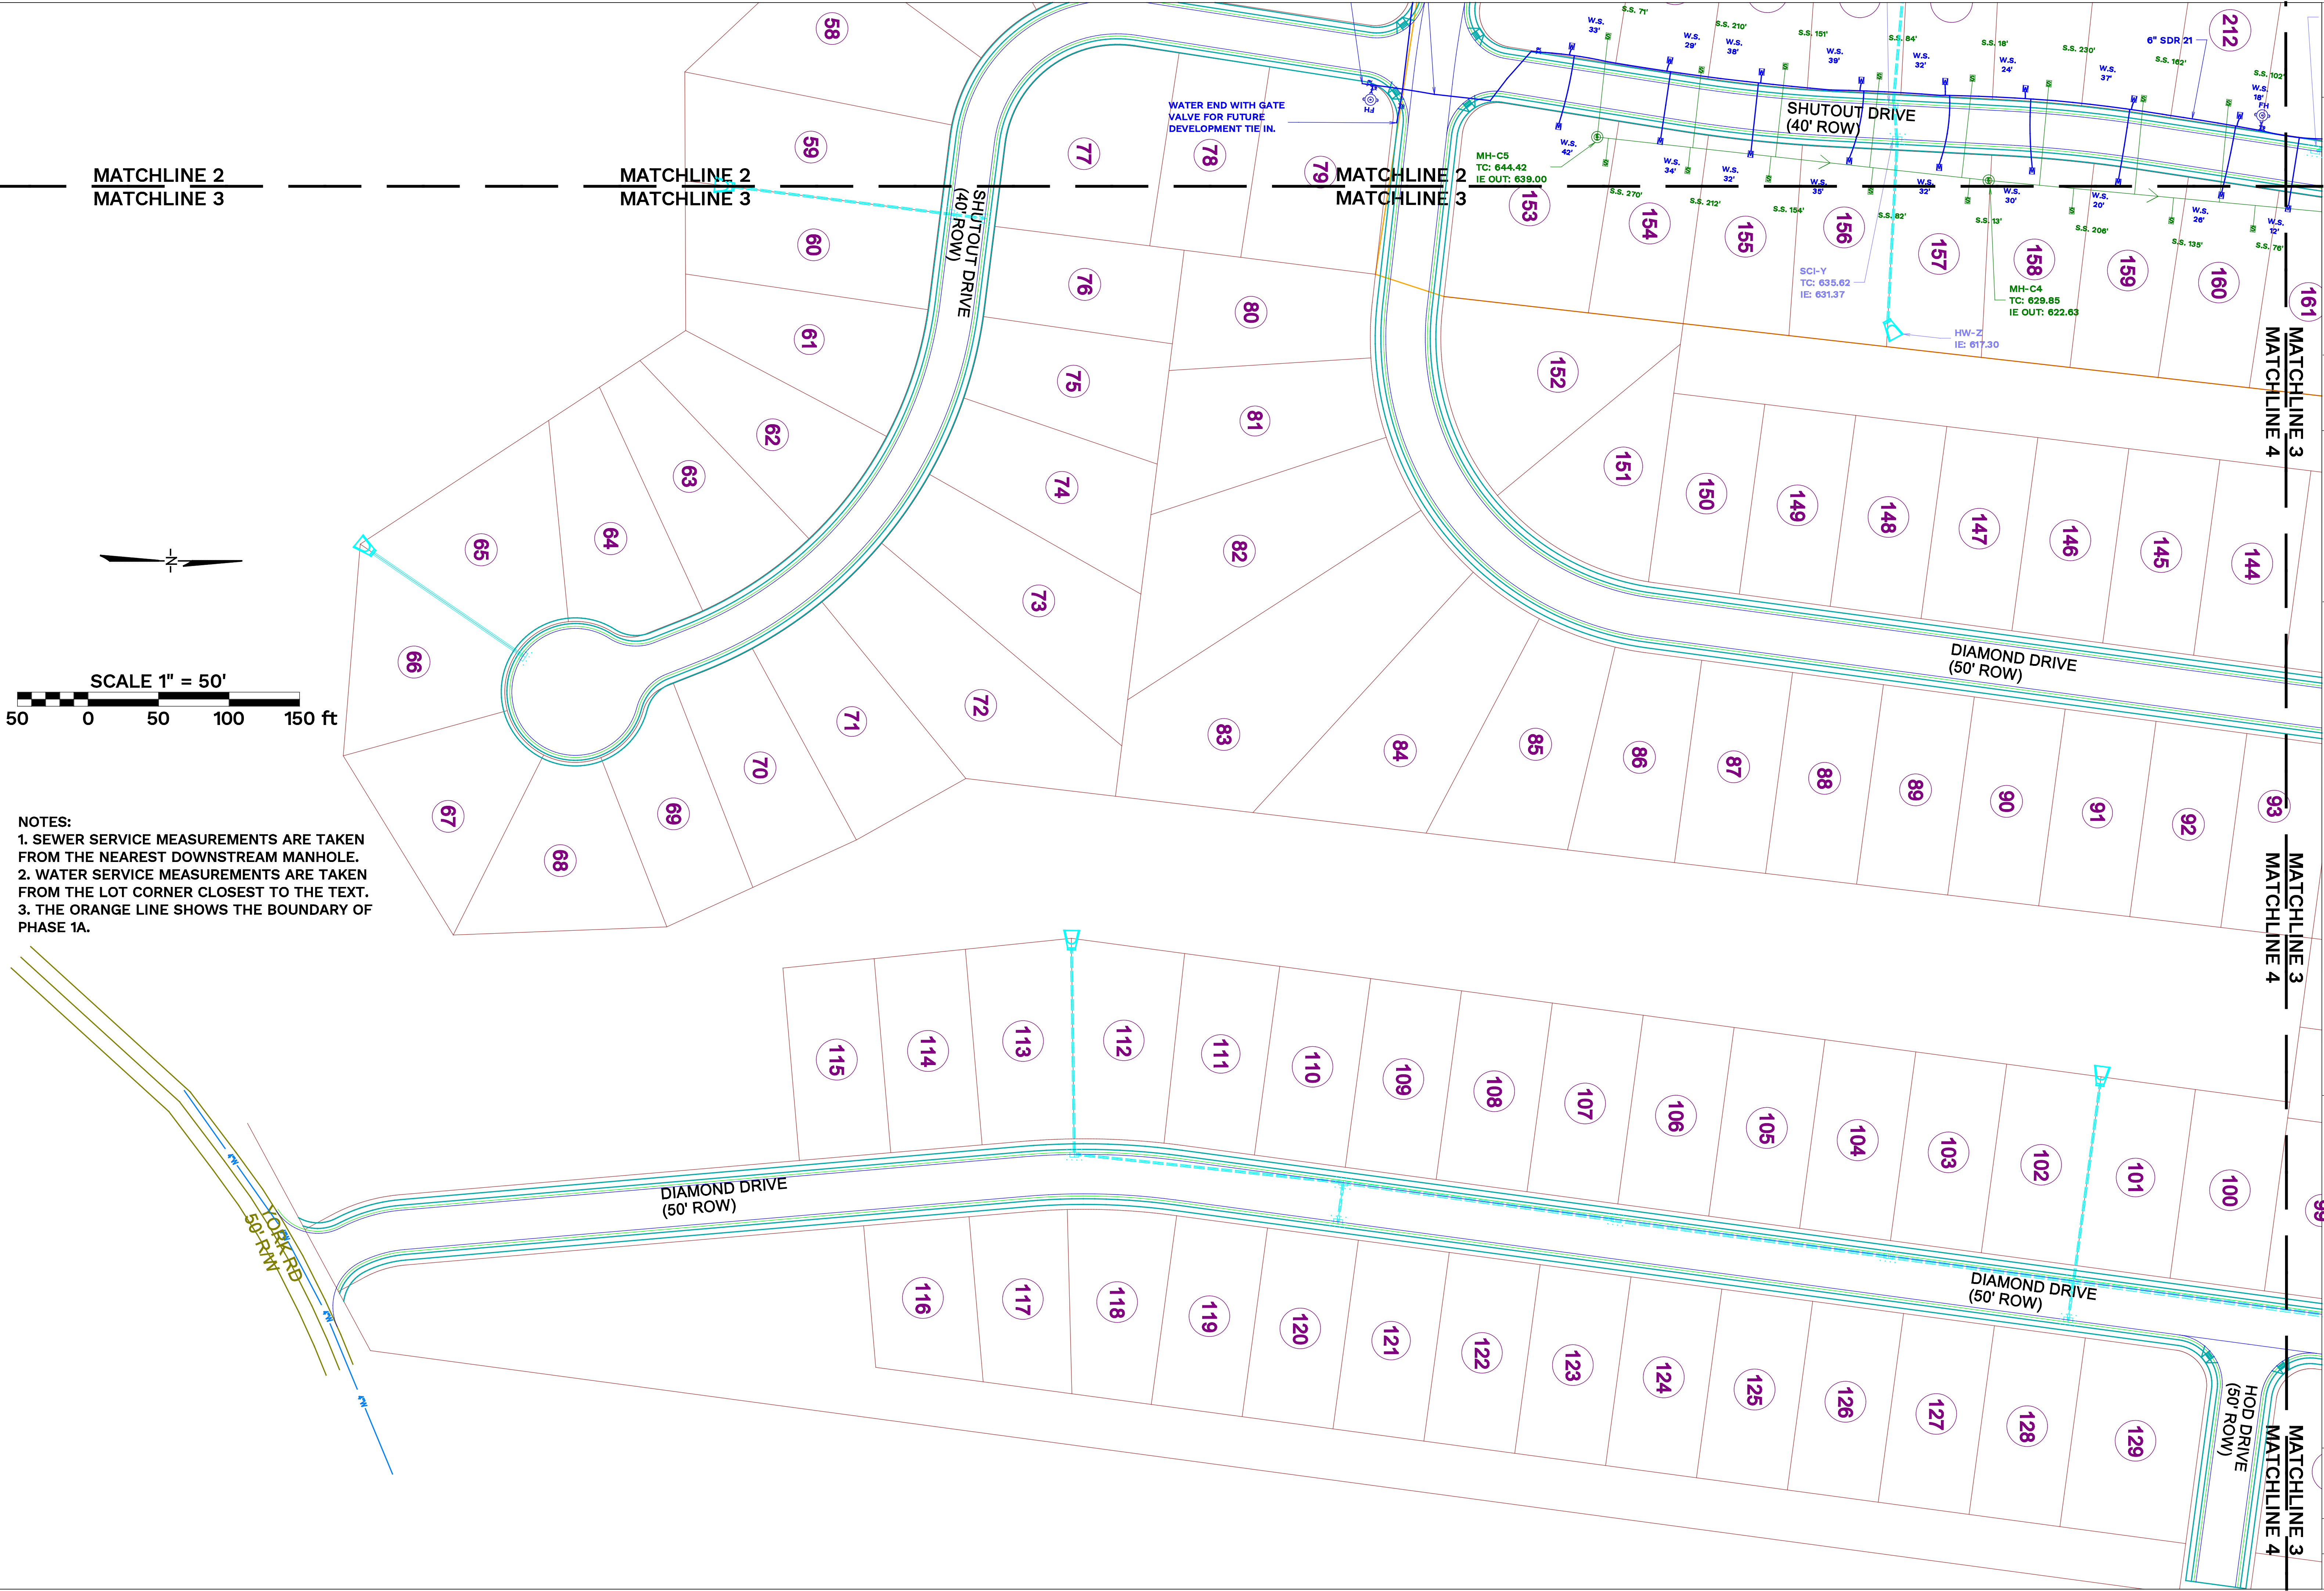

MATCHLINE 2  
MATCHLINE 3


MATCHLINE 2  
MATCHLINE 3

MATCHLINE 2  
MATCHLINE 3

MATCHLINE 3  
MATCHLINE 4

MATCHLINE 3  
MATCHLINE 4

MATCHLINE 3  
MATCHLINE 4

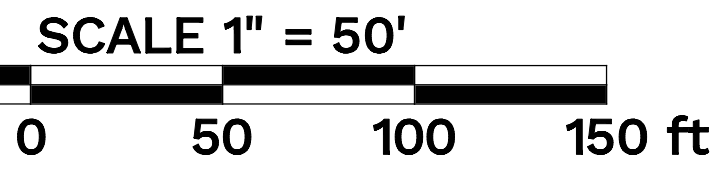

NOTES:  
 1. SEWER SERVICE MEASUREMENTS ARE TAKEN FROM THE NEAREST DOWNSTREAM MANHOLE.  
 2. WATER SERVICE MEASUREMENTS ARE TAKEN FROM THE LOT CORNER CLOSEST TO THE TEXT.  
 3. THE ORANGE LINE SHOWS THE BOUNDARY OF PHASE 1A.

YORK RD  
50' ROW

DIAMOND DRIVE  
(50' ROW)

DIAMOND DRIVE  
(50' ROW)

HOD DRIVE  
(50' ROW)

SHUTOUD DRIVE  
(40' ROW)

WATER END WITH GATE VALVE FOR FUTURE DEVELOPMENT TIE IN.



MH-C5  
TC: 644.42  
IE OUT: 639.00

SCI-Y  
TC: 635.62  
IE: 631.37

MH-C4  
TC: 629.85  
IE OUT: 622.63

HW-Z  
IE: 617.30



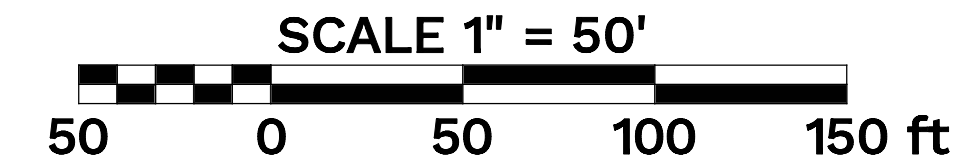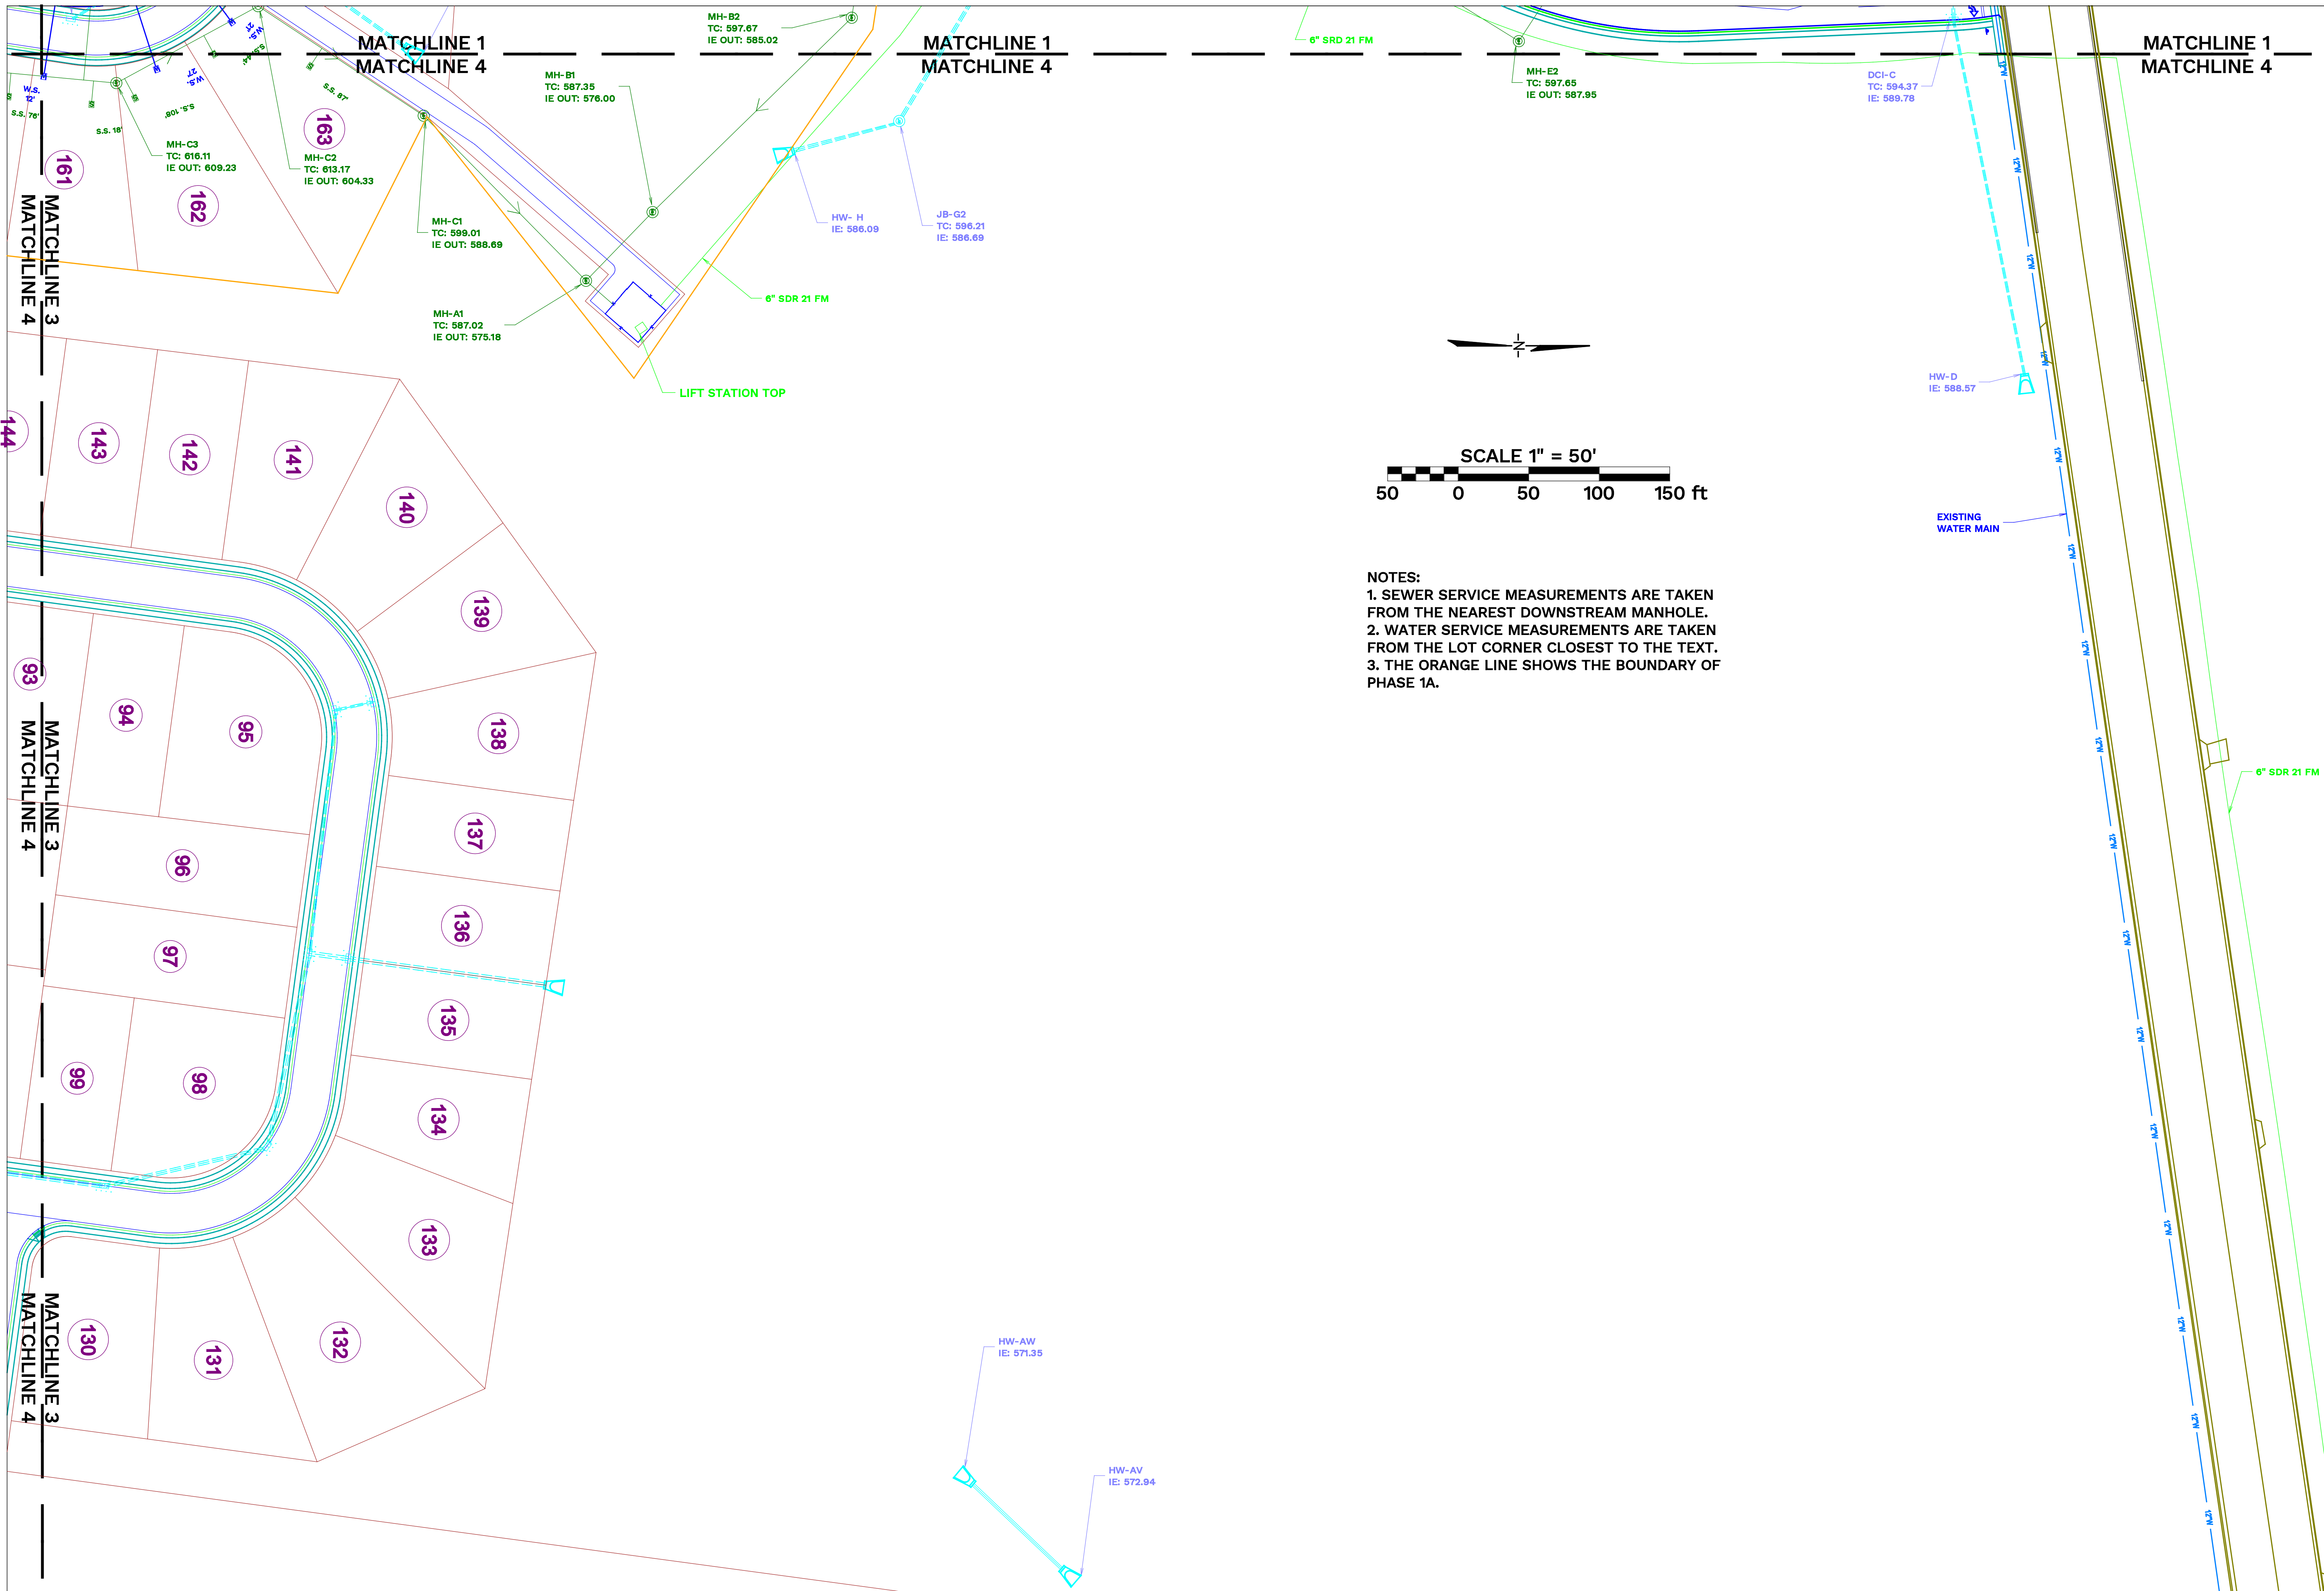

- NOTES:
1. SEWER SERVICE MEASUREMENTS ARE TAKEN FROM THE NEAREST DOWNSTREAM MANHOLE.
  2. WATER SERVICE MEASUREMENTS ARE TAKEN FROM THE LOT CORNER CLOSEST TO THE TEXT.
  3. THE ORANGE LINE SHOWS THE BOUNDARY OF PHASE 1A.

DATE:	
REVISIONS	
NO.	
<b>AS BUILT EXHIBIT</b> <b>LISEBEE FIELDS</b> <b>CLARKSVILLE, TN</b>	
BYARD CONSTRUCTION, LLC. 324 INNOVATION WAY CLARKSVILLE, TN OFFICE: (931) 358 - 4700	
	
<b>SHEET</b> <b>5 OF 5</b>	