


NOTES:
 1. ALL SEWER SERVICE MEASUREMENTS ARE TAKEN FROM THE NEAREST DOWNSTREAM MANHOLE.
 2. ALL WATER SERVICE MEASUREMENTS ARE TAKEN FROM THE LOT CORNER CLOSEST TO THE TEXT.

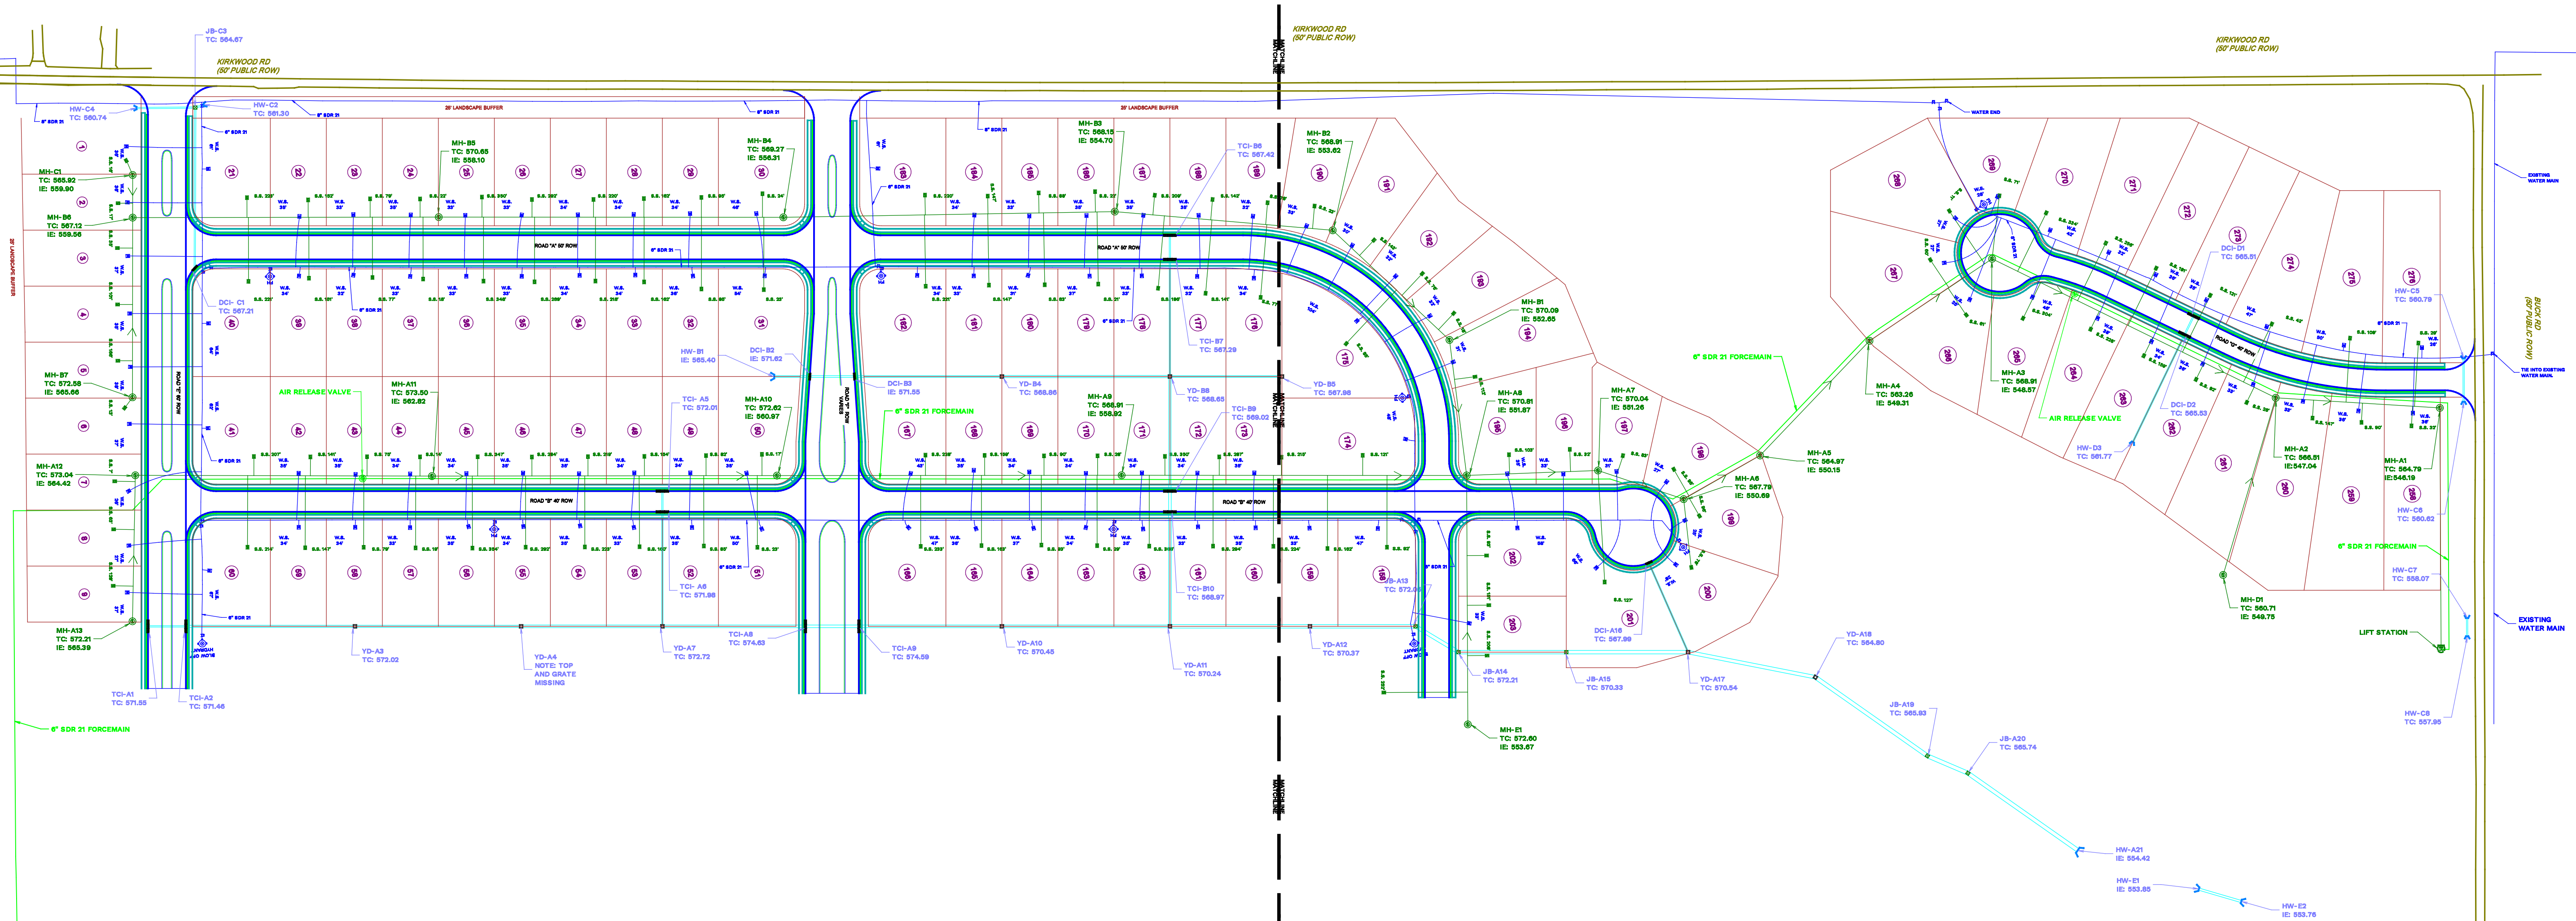


NO.	REVISIONS	DATE:

AS BUILT EXHIBIT PG 1
PARK AT OLIVER FARMS
CLARKSVILLE, TN

BYARD CONSTRUCTION, LLC
 324 INNOVATION WAY
 CLARKSVILLE, TN
 OFFICE: (931) 358-4700



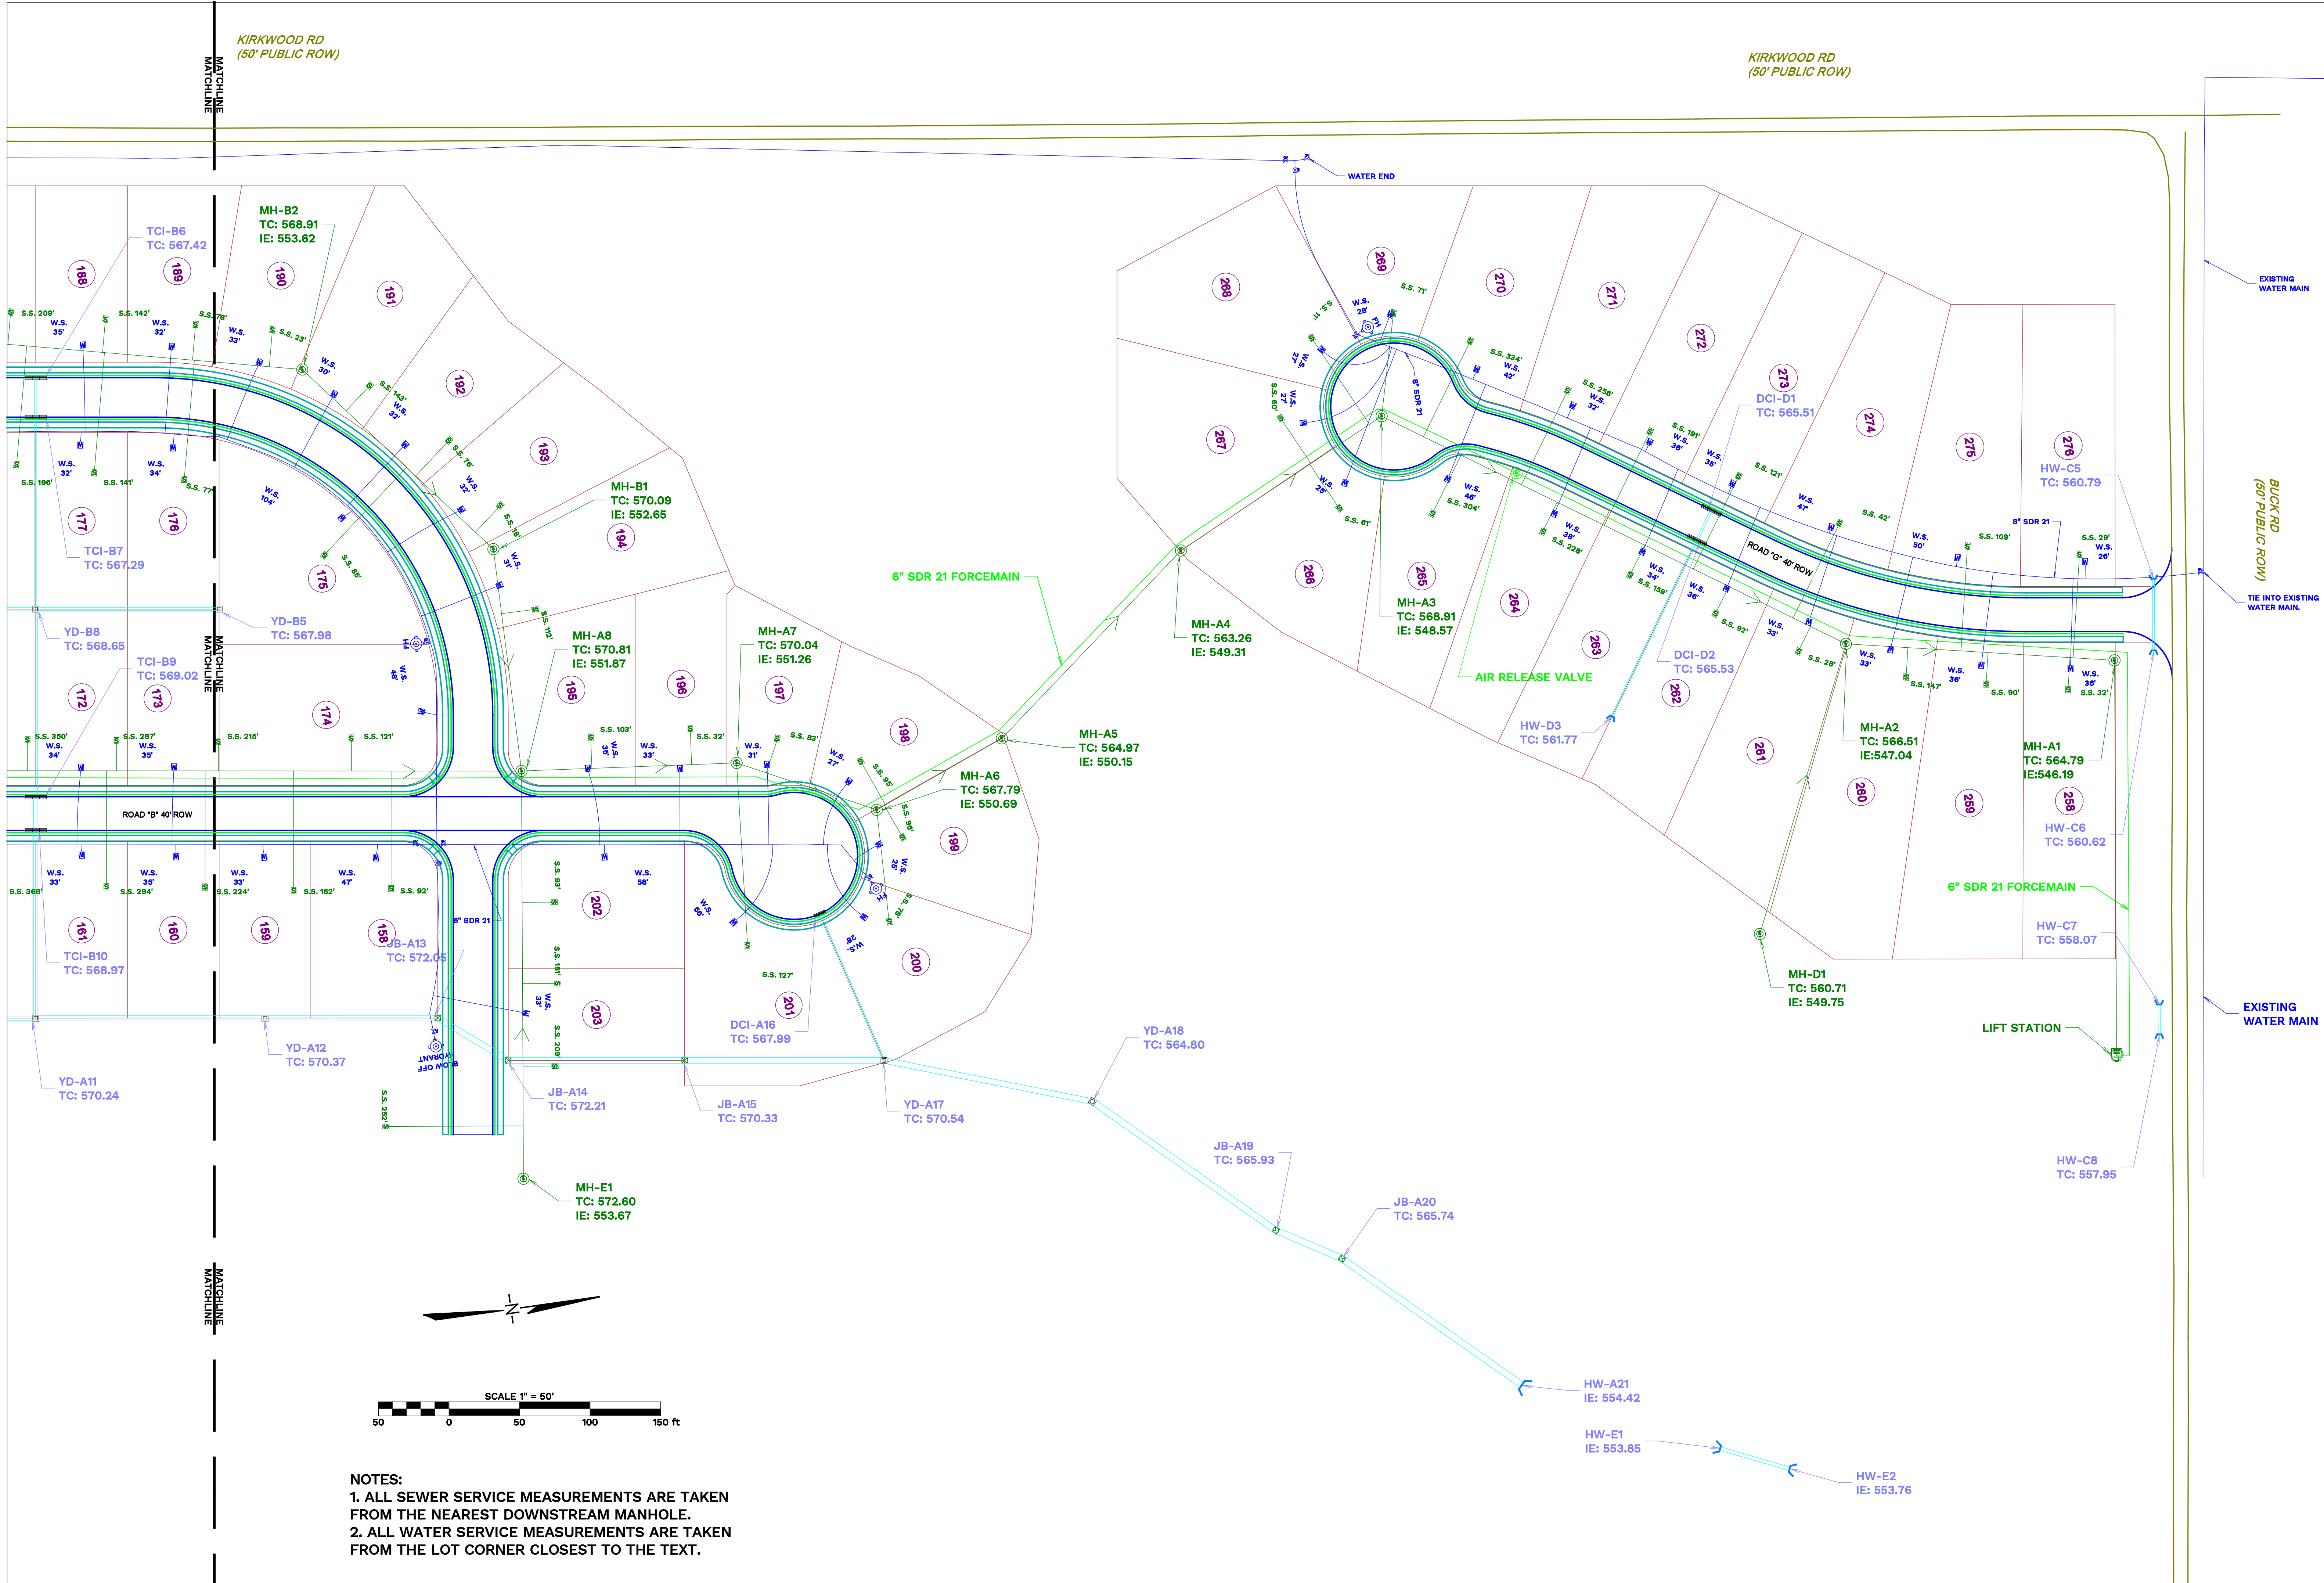

KIRKWOOD RD
(50' PUBLIC ROW)

KIRKWOOD RD
(50' PUBLIC ROW)

DATE:

REVISIONS


NO.



AS BUILT EXHIBIT PG 2
PARK AT OLIVER FARMS
CLARKSVILLE, TN

BYARD CONSTRUCTION, LLC
324 INNOVATION WAY
CLARKSVILLE, TN
OFFICE: (931) 358-4700



- NOTES:
 1. ALL SEWER SERVICE MEASUREMENTS ARE TAKEN FROM THE NEAREST DOWNSTREAM MANHOLE.
 2. ALL WATER SERVICE MEASUREMENTS ARE TAKEN FROM THE LOT CORNER CLOSEST TO THE TEXT.

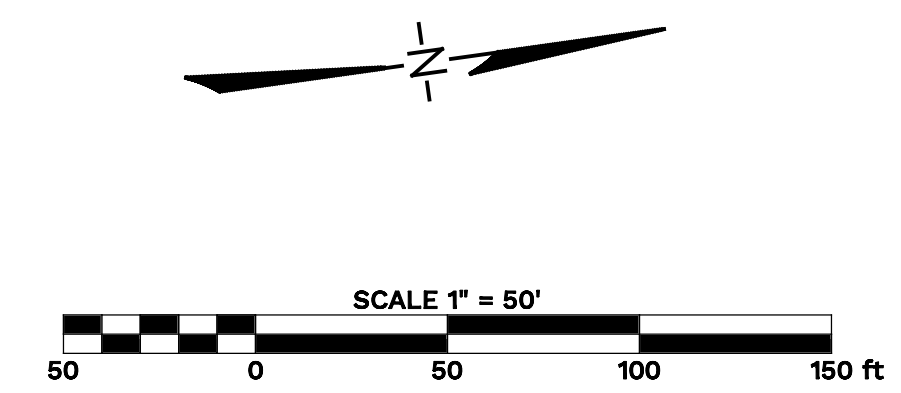

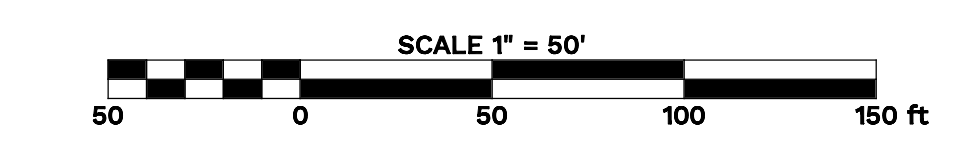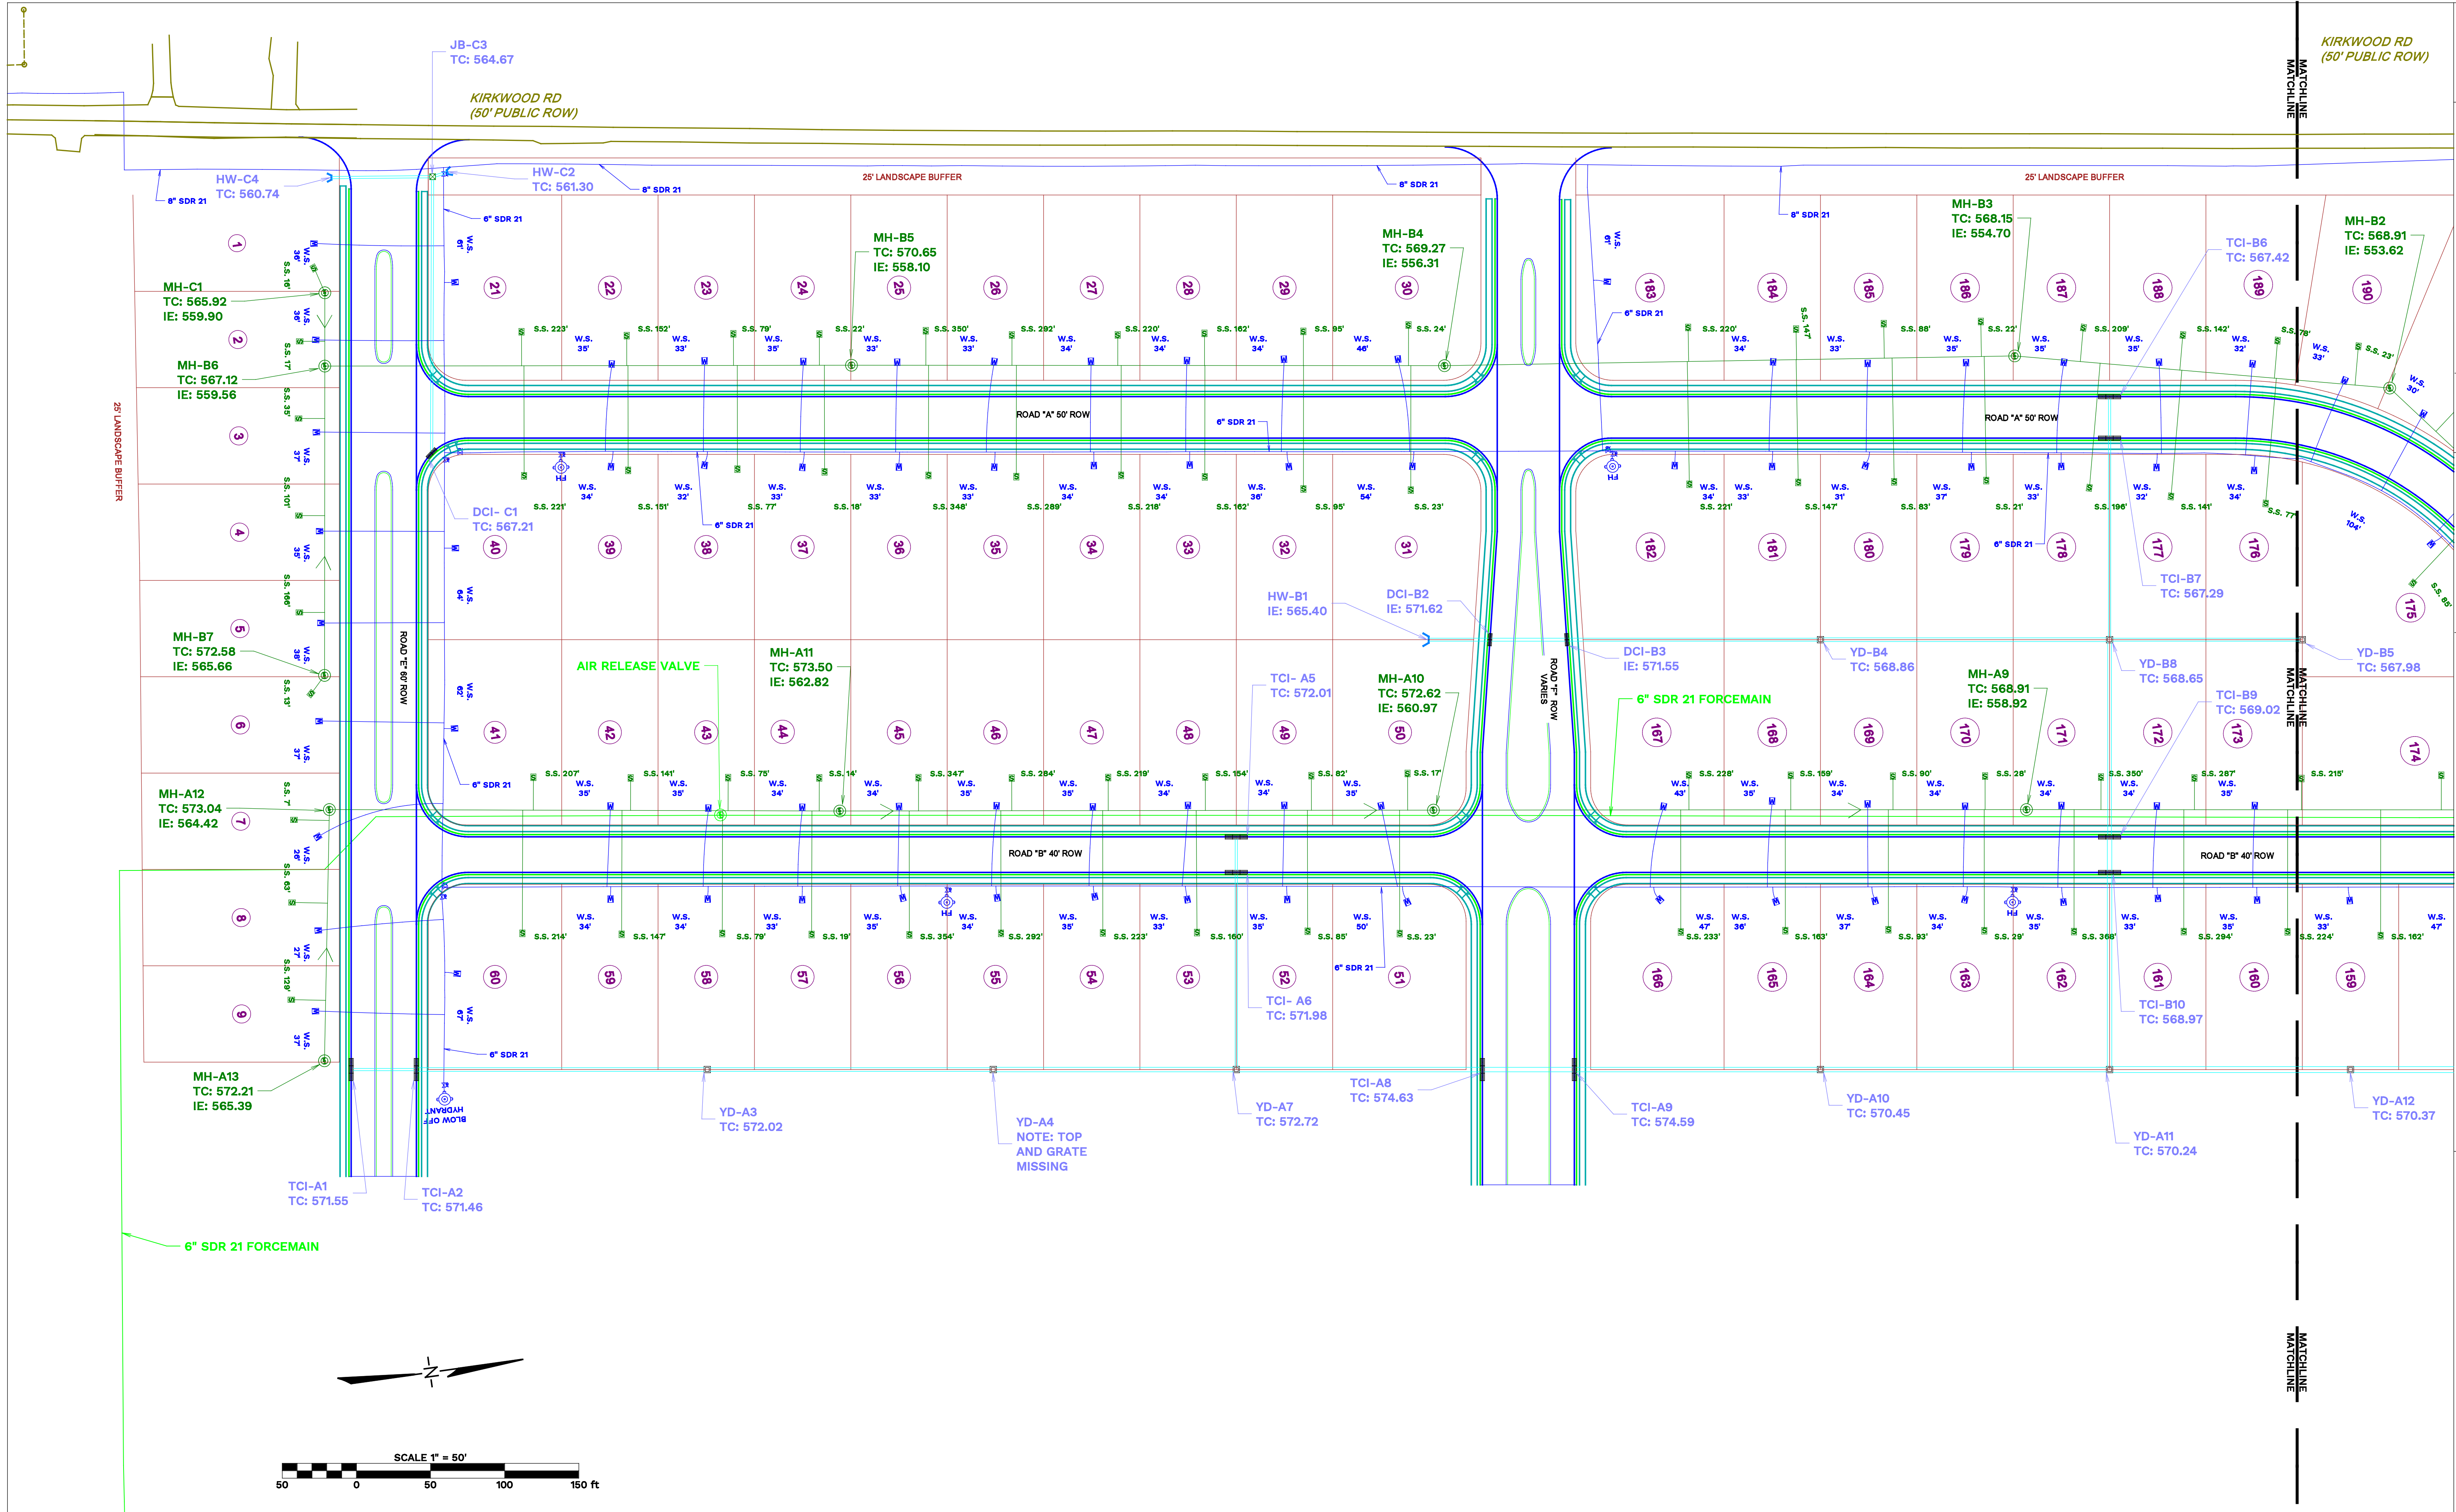

NOTES:
 1. ALL SEWER SERVICE MEASUREMENTS ARE TAKEN FROM THE NEAREST DOWNSTREAM MANHOLE.
 2. ALL WATER SERVICE MEASUREMENTS ARE TAKEN FROM THE LOT CORNER CLOSEST TO THE TEXT.

NO.	REVISIONS	DATE:

AS BUILT EXHIBIT PG 3
PARK AT OLIVER FARMS
CLARKSVILLE, TN

BYARD CONSTRUCTION, LLC
 324 INNOVATION WAY
 CLARKSVILLE, TN
 OFFICE: (931) 358-4700

