

- NOTES:**
- SEWER SERVICE MEASUREMENTS ARE TAKEN FROM THE NEAREST DOWNSTREAM MANHOLE.
 - WATER SERVICE MEASUREMENTS ARE TAKEN FROM THE LOT CORNER CLOSEST TO THE TEXT.
 - THE ORANGE LINE SHOWS THE BOUNDARY OF PHASE 1A.

NO.	REVISIONS	DATE:

**AS BUILT EXHIBIT
LISEEBEE FIELDS
CLARKSVILLE, TN**



BYARD CONSTRUCTION, LLC.
324 INNOVATION WAY
CLARKSVILLE, TN
OFFICE: (931) 358 - 4700




NO.	REVISIONS	DATE:

AS BUILT EXHIBIT
LISENLEE FIELDS
CLARKSVILLE, TN

BYARD CONSTRUCTION, LLC.
324 INNOVATION WAY
CLARKSVILLE, TN
OFFICE: (931) 358 - 4700

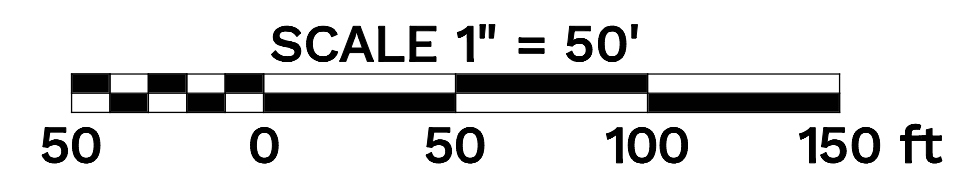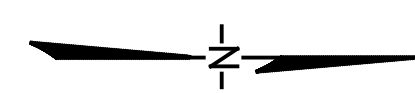


- NOTES:
- SEWER SERVICE MEASUREMENTS ARE TAKEN FROM THE NEAREST DOWNSTREAM MANHOLE.
 - WATER SERVICE MEASUREMENTS ARE TAKEN FROM THE LOT CORNER CLOSEST TO THE TEXT.
 - THE ORANGE LINE SHOWS THE BOUNDARY OF PHASE 1A.

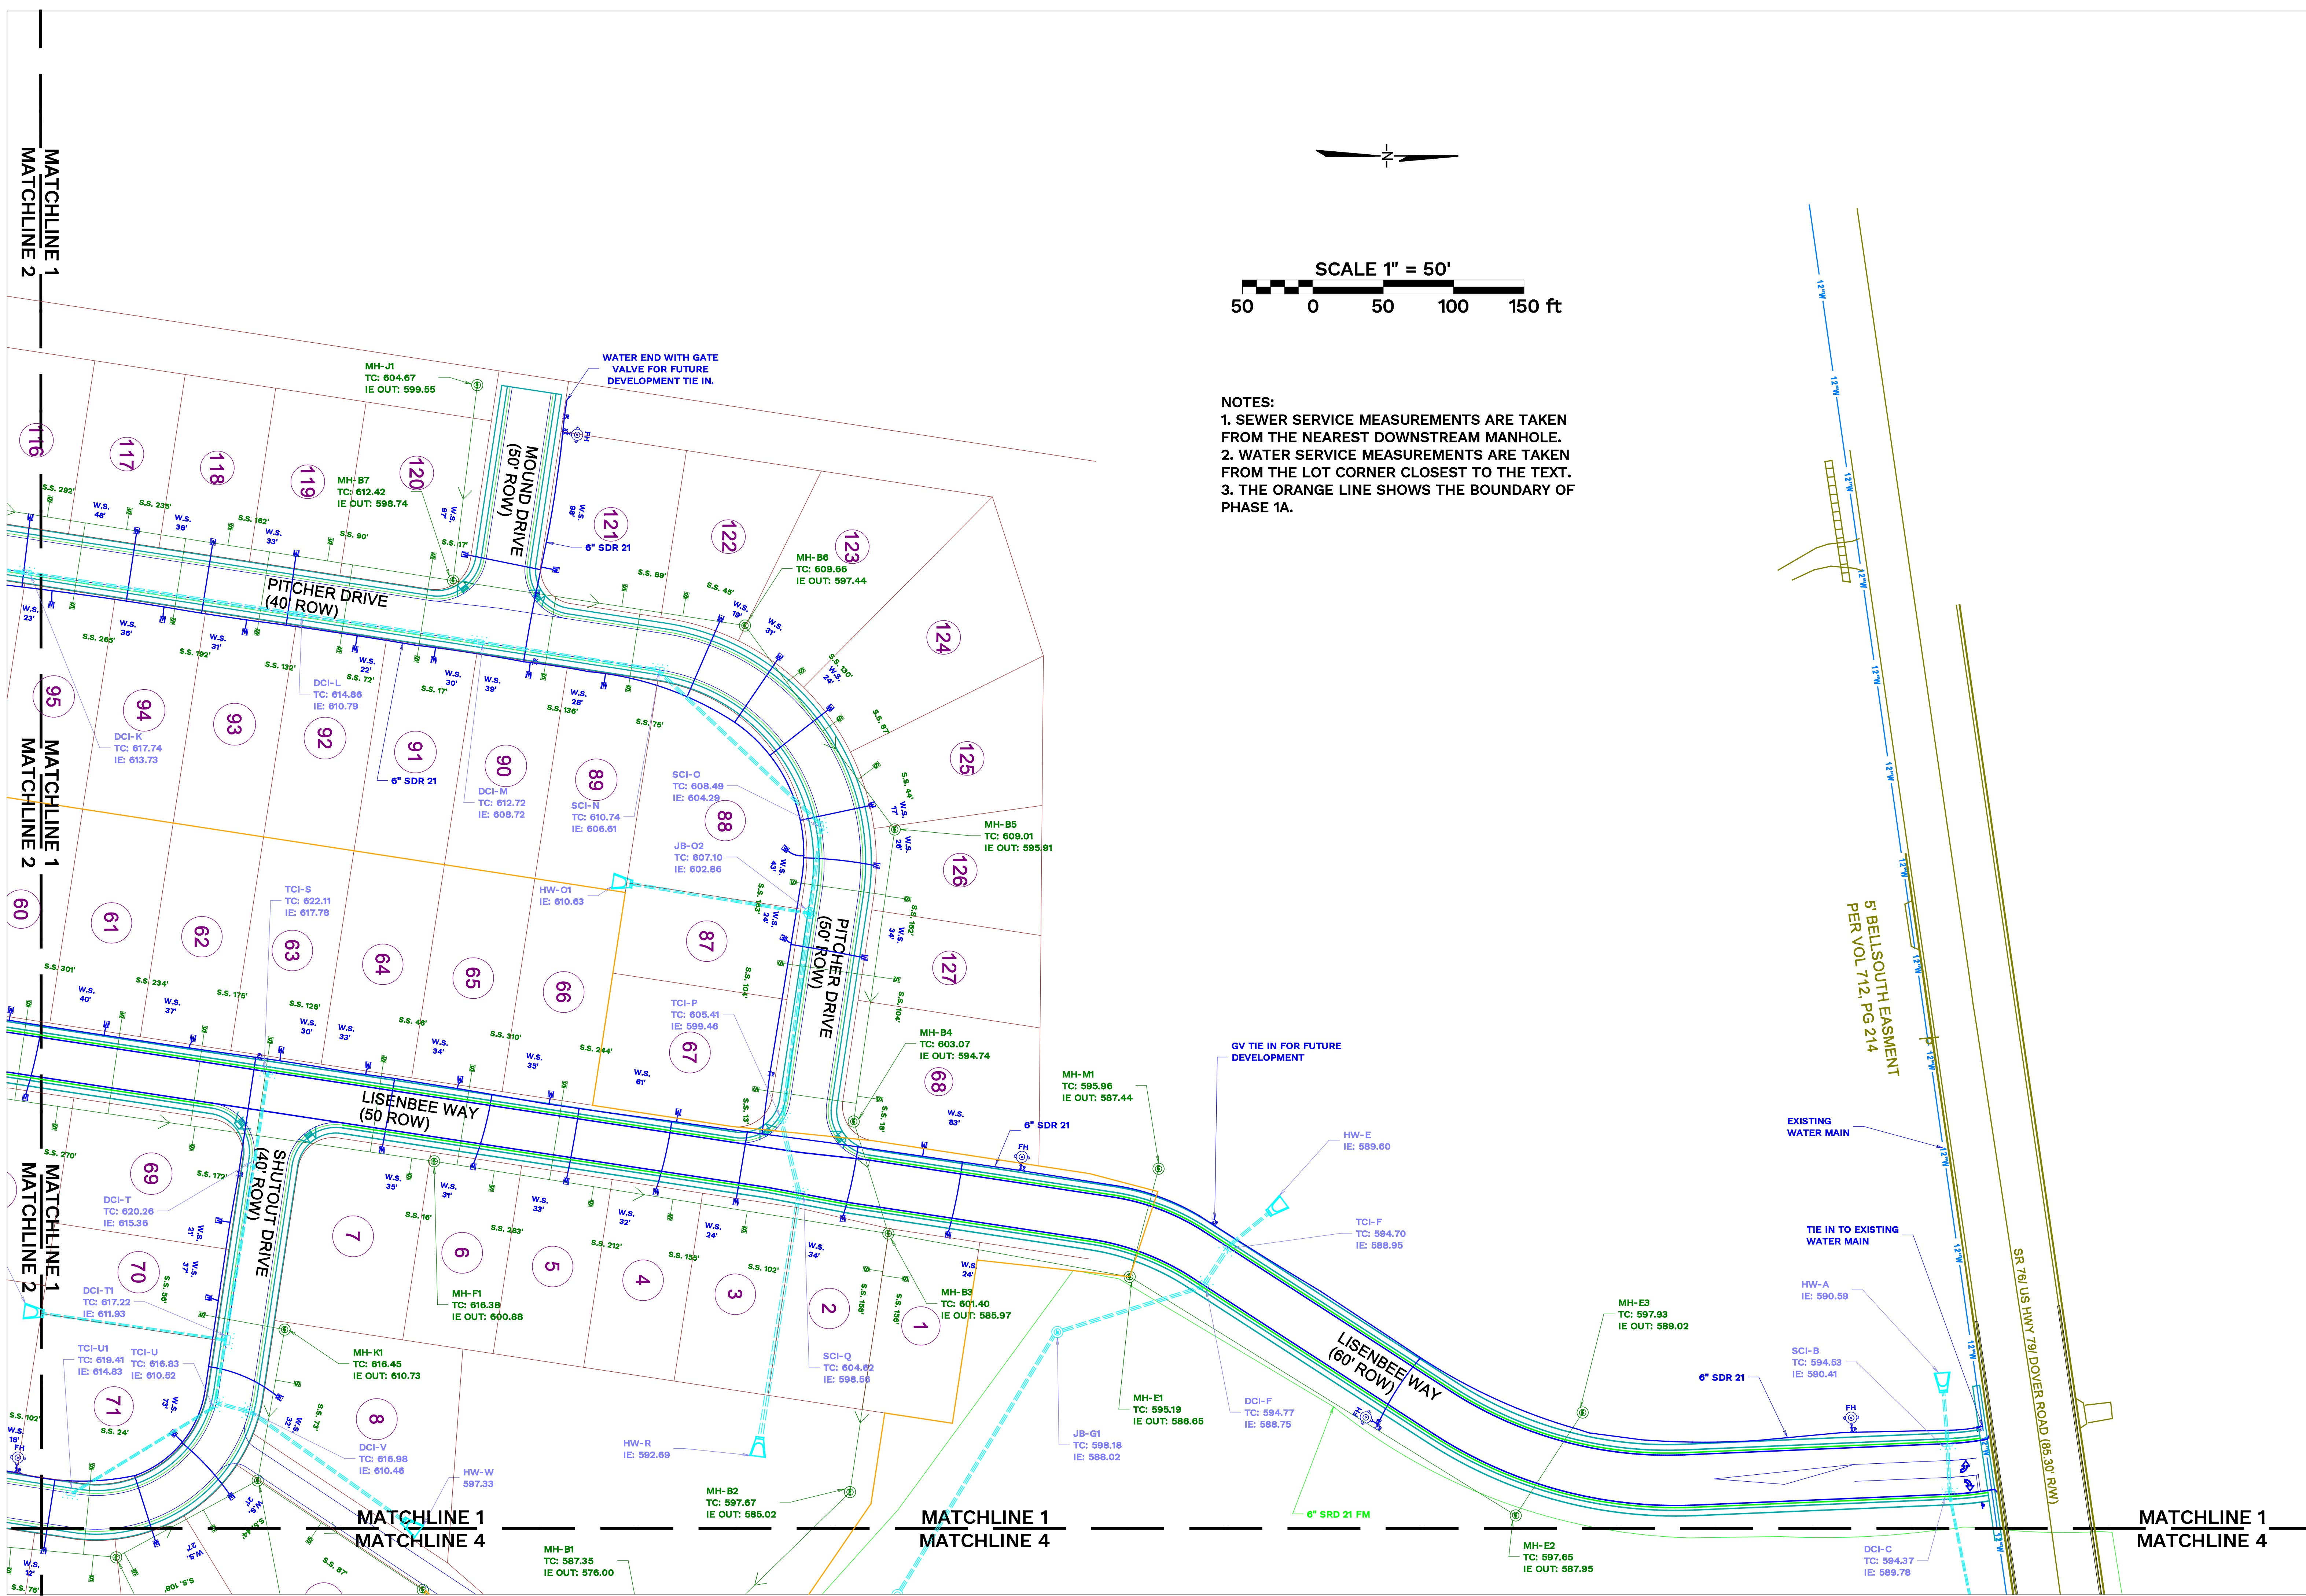

DATE:	
REVISION:	
NO.	

CLARKSVILLE
 LITBIBX
 SLD
 FIELD



BYARD CONSTRUCTION, LLC
 324 INNOVATION WAY
 CLARKSVILLE, TN
 OFFICE: (931) 358-4700

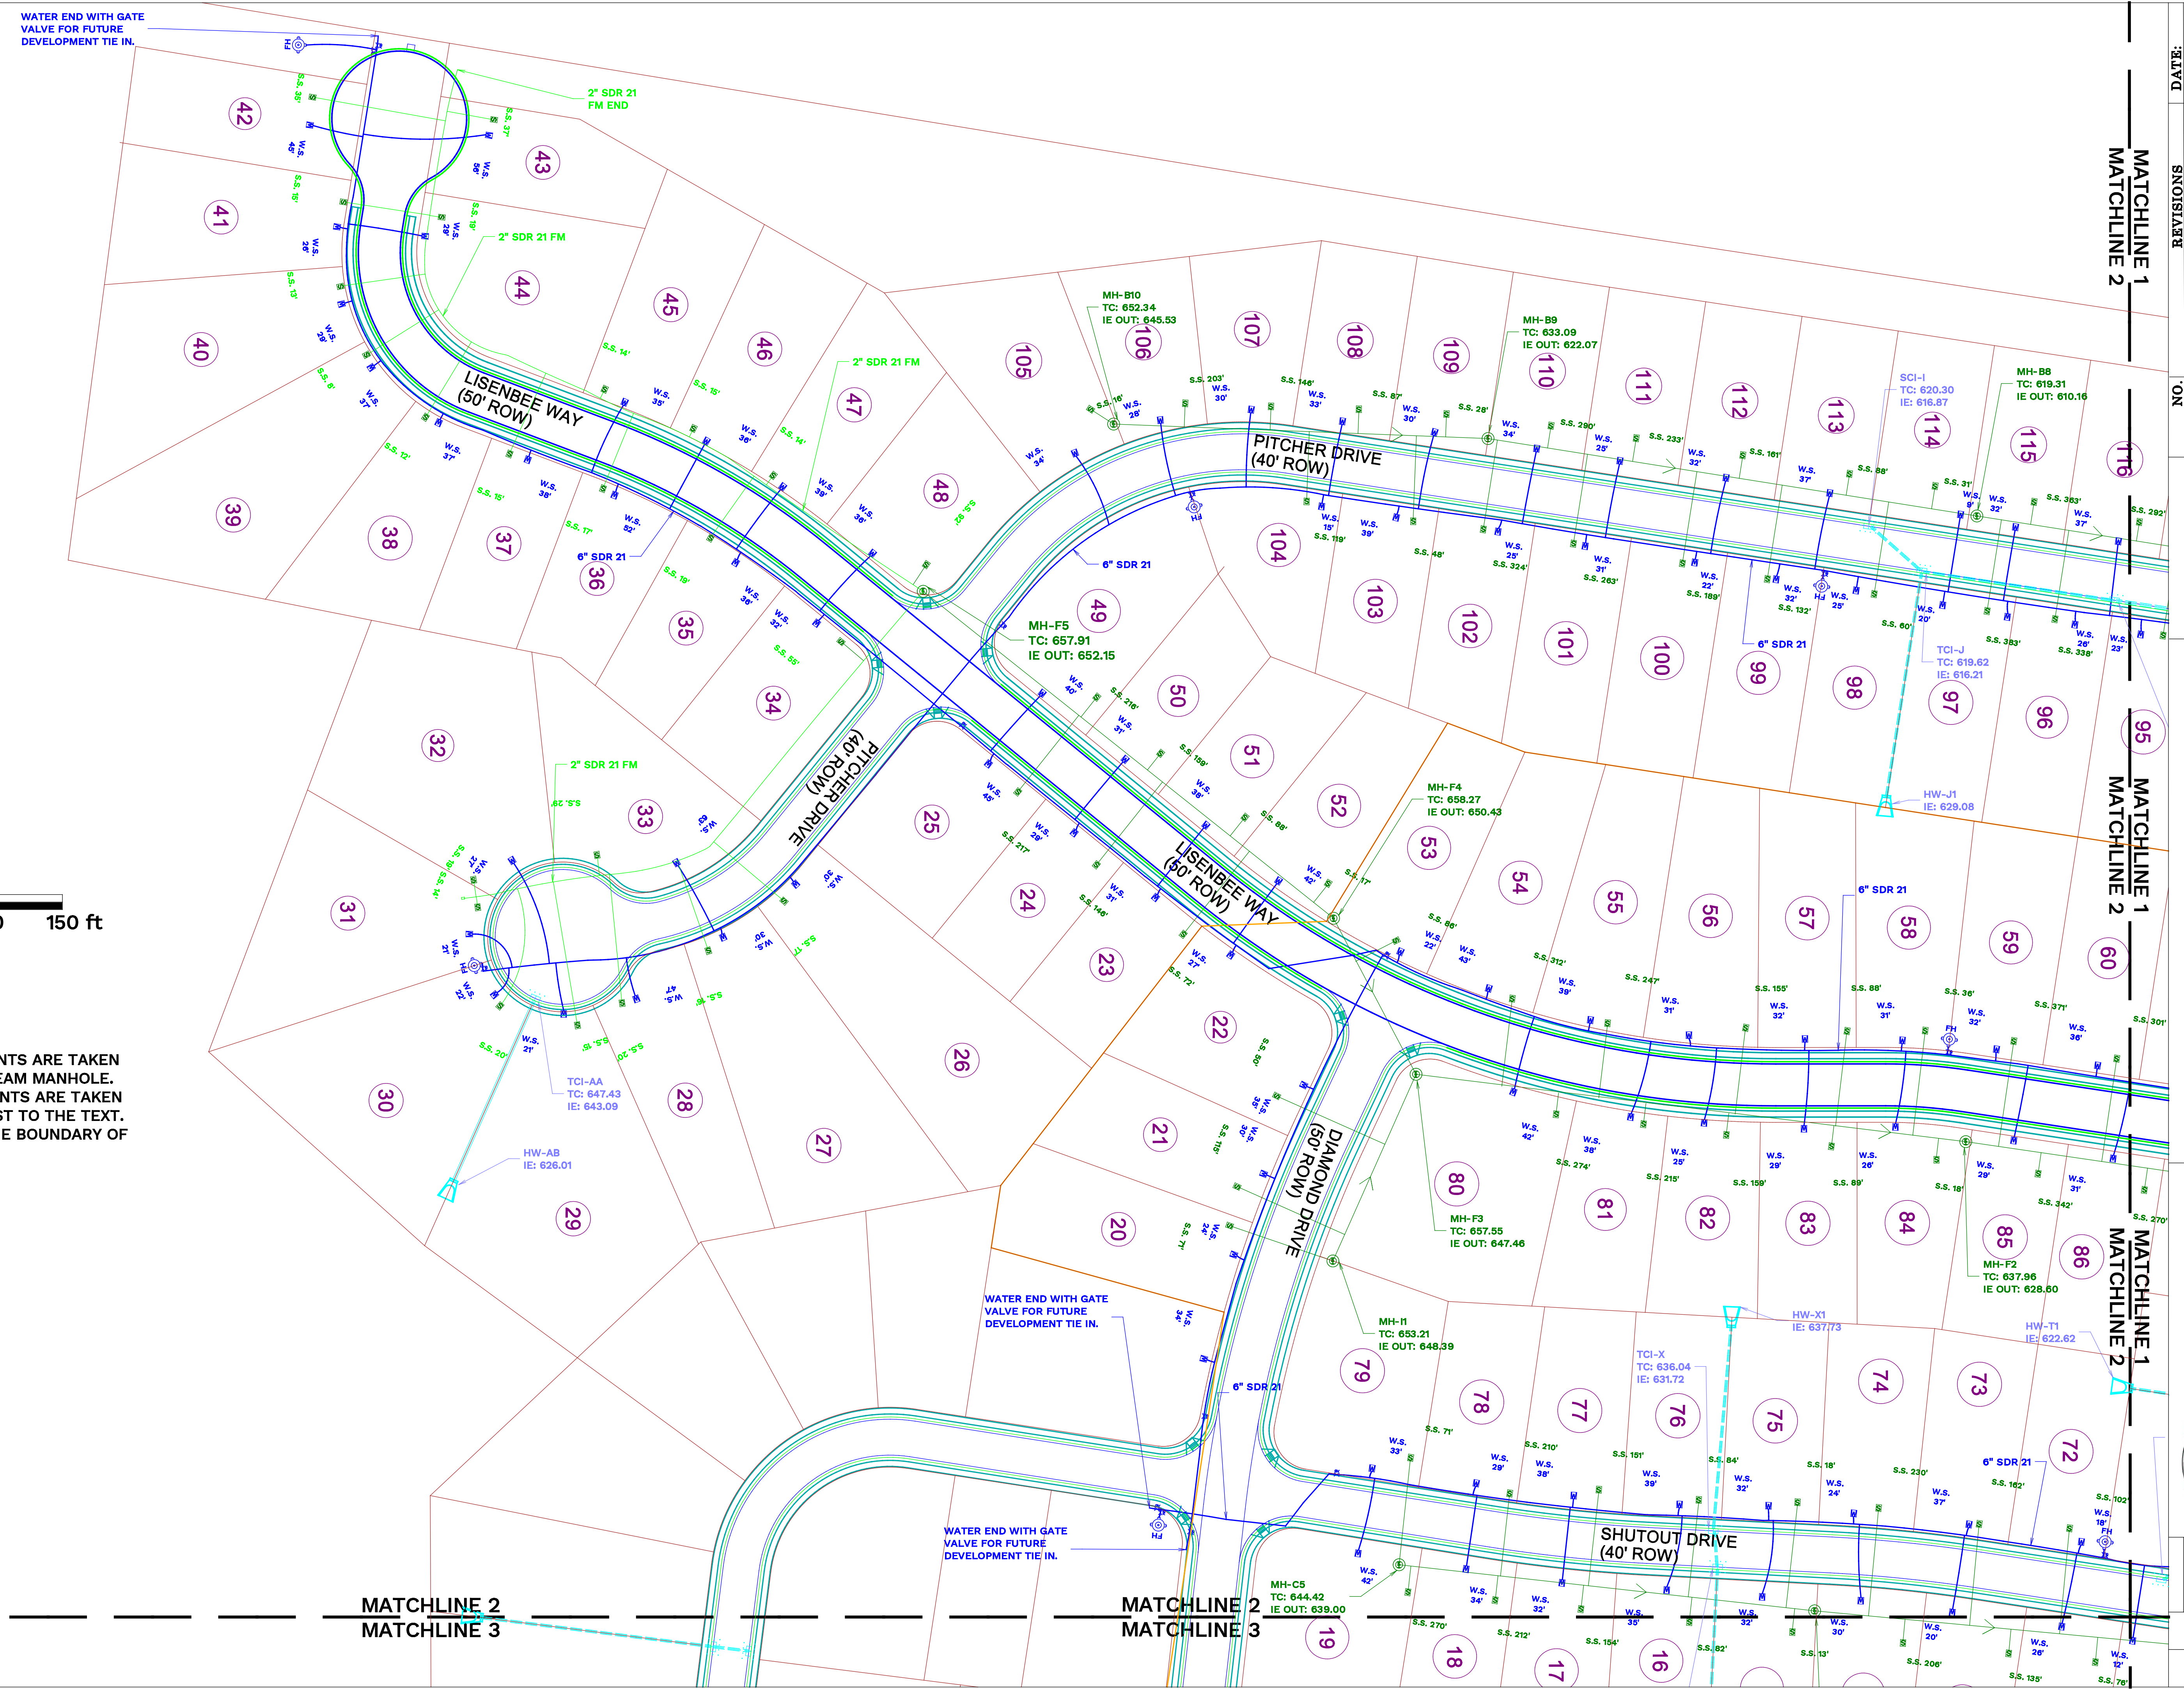

WATER END WITH GATE VALVE FOR FUTURE DEVELOPMENT TIE IN.

WATER END WITH GATE VALVE FOR FUTURE DEVELOPMENT TIE IN.

WATER END WITH GATE VALVE FOR FUTURE DEVELOPMENT TIE IN.

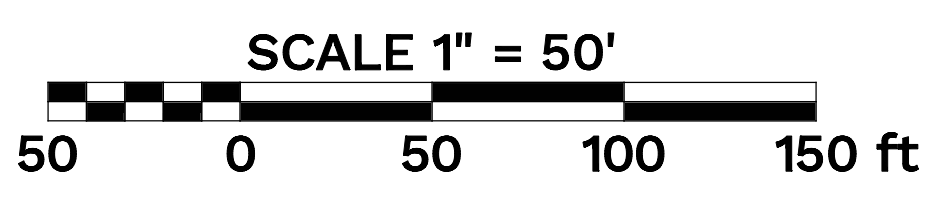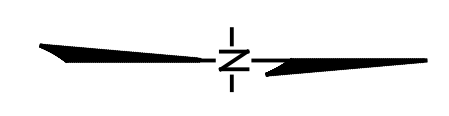

- NOTES:
1. SEWER SERVICE MEASUREMENTS ARE TAKEN FROM THE NEAREST DOWNSTREAM MANHOLE.
 2. WATER SERVICE MEASUREMENTS ARE TAKEN FROM THE LOT CORNER CLOSEST TO THE TEXT.
 3. THE ORANGE LINE SHOWS THE BOUNDARY OF PHASE 1A.

MATCHLINE 2
 MATCHLINE 3

MATCHLINE 2
 MATCHLINE 3

MATCHLINE 2
 MATCHLINE 3

MATCHLINE 1
 MATCHLINE 2

MATCHLINE 1
 MATCHLINE 2

MATCHLINE 1
 MATCHLINE 2

DATE:

REVISIONS


NO.

AS BUILT EXHIBIT
LISEBEE FIELDS
CLARKSVILLE, TN

BYARD CONSTRUCTION, LLC.
324 INNOVATION WAY
CLARKSVILLE, TN
OFFICE: (931) 358 - 4700



SHEET
4 OF 5

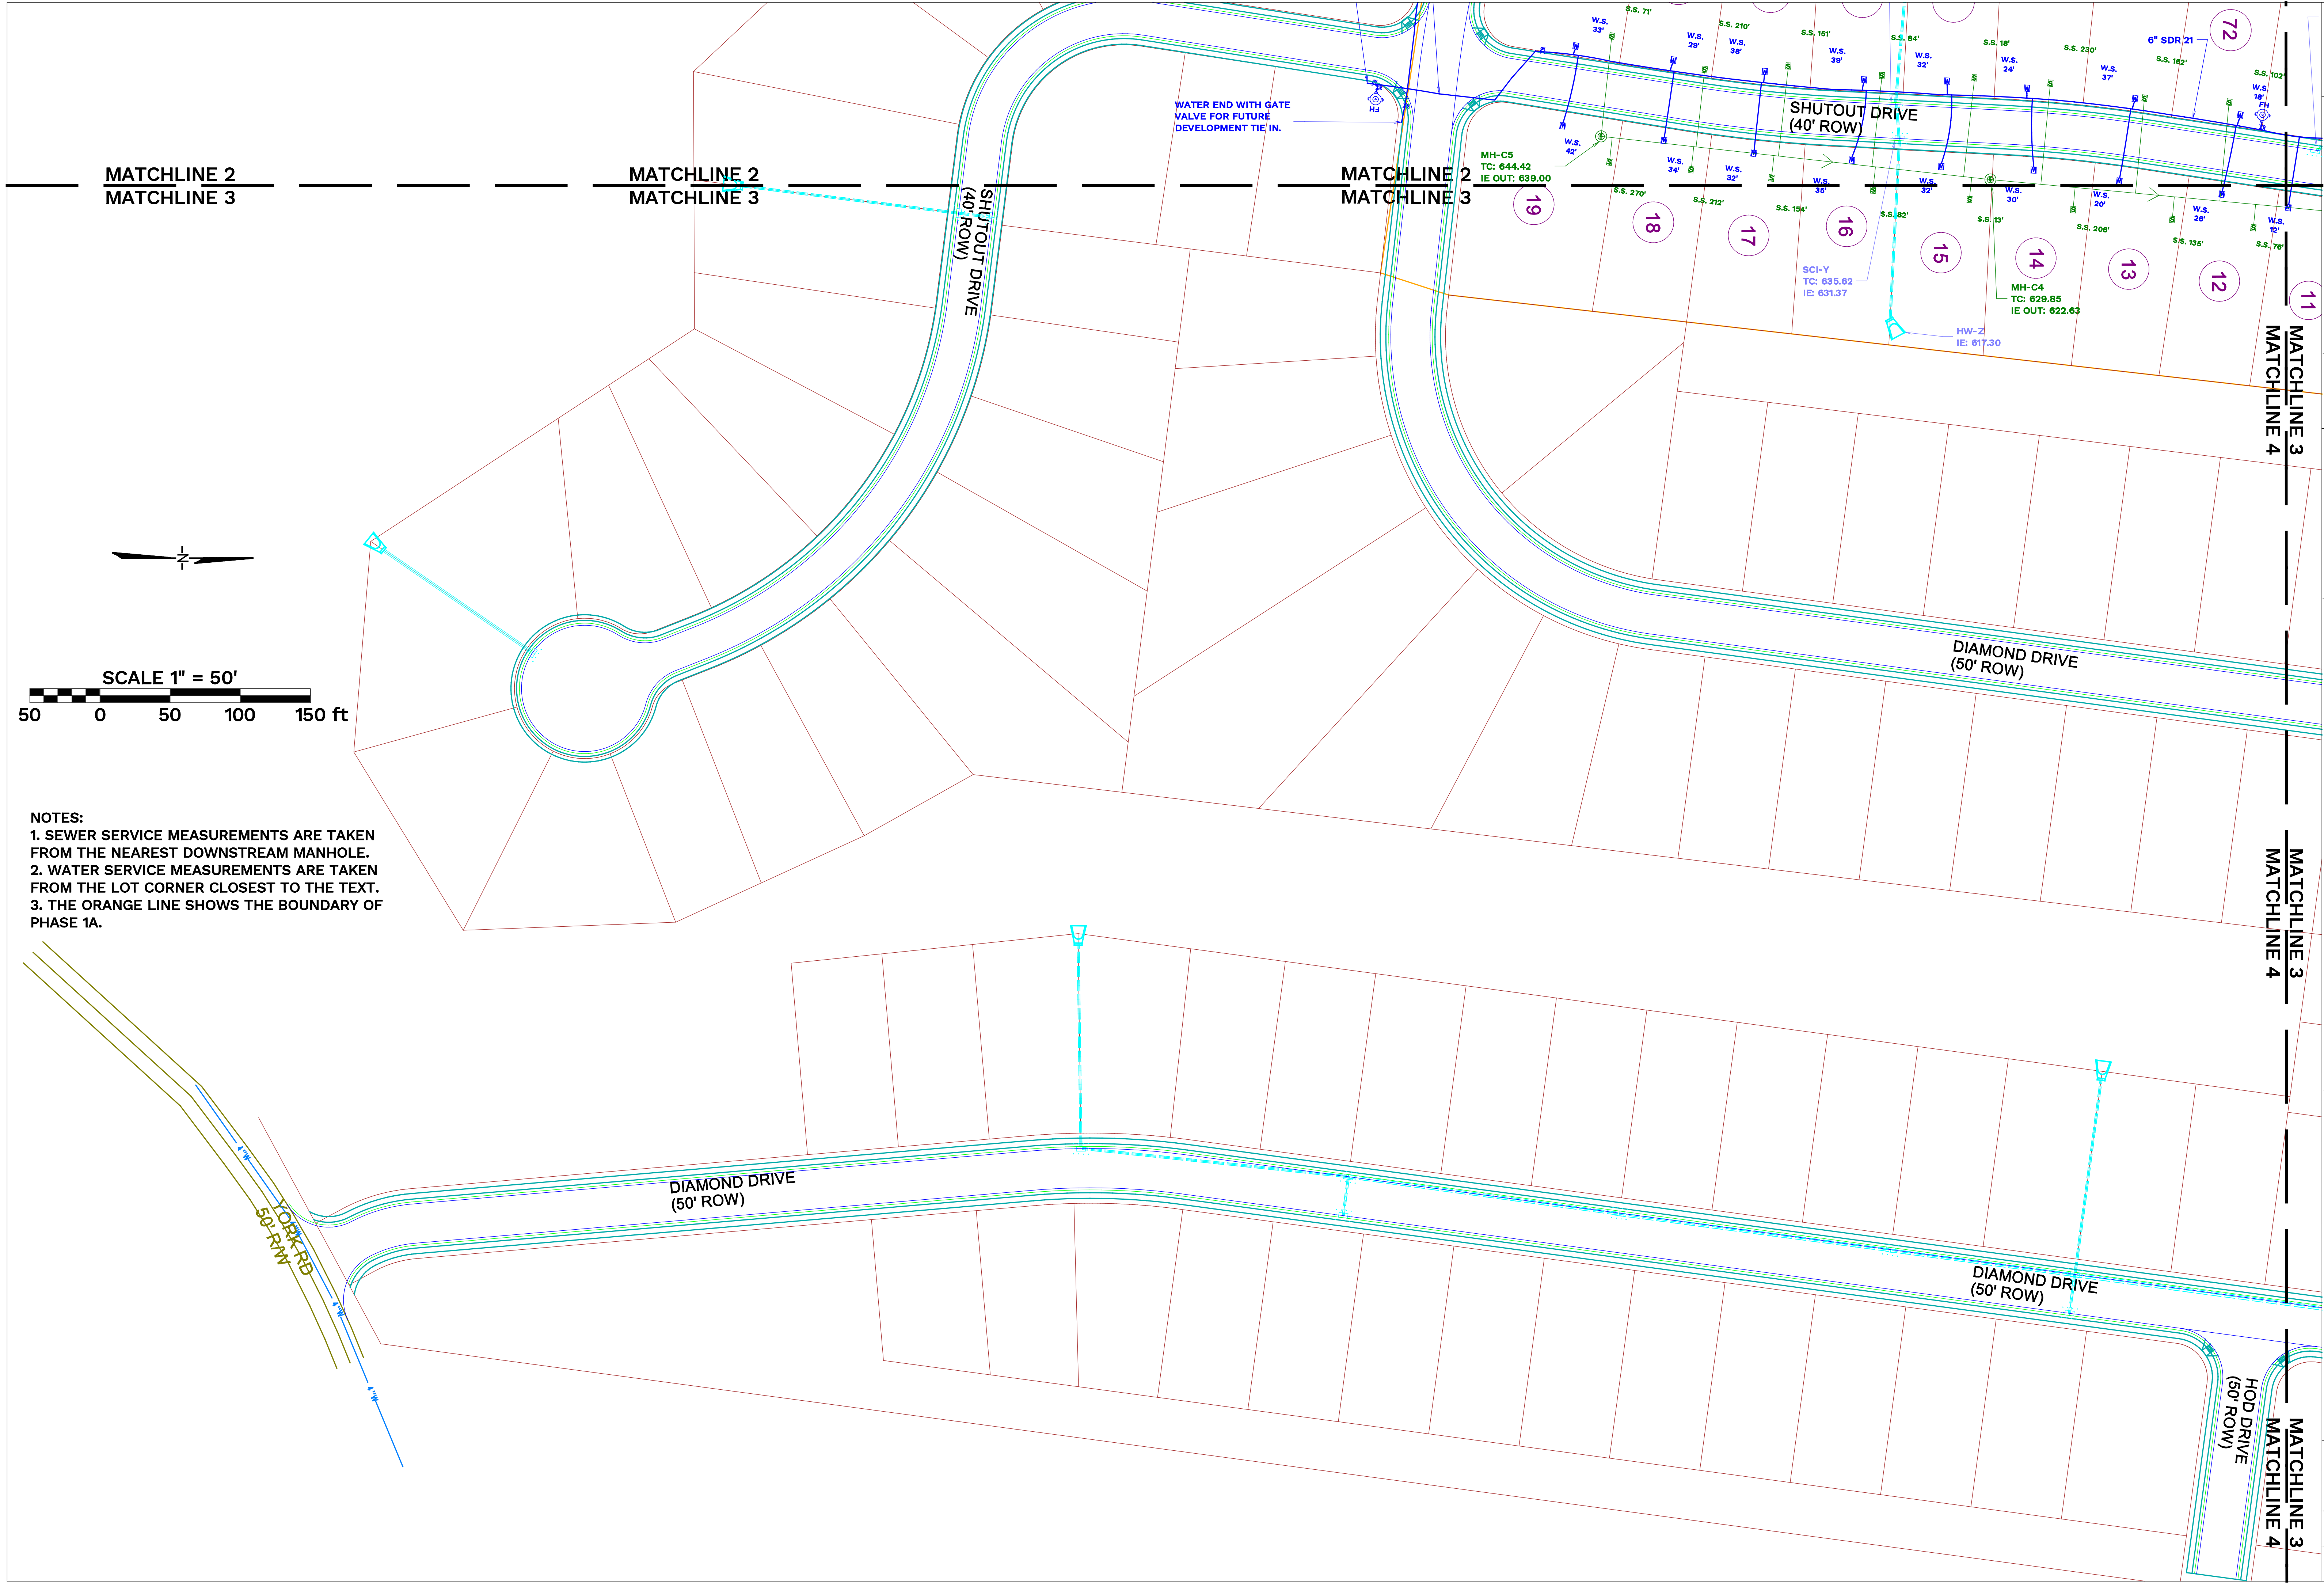

WATER END WITH GATE VALVE FOR FUTURE DEVELOPMENT TIE IN.

SHUTOUT DRIVE (40' ROW)

DIAMOND DRIVE (50' ROW)

DIAMOND DRIVE (50' ROW)

DIAMOND DRIVE (50' ROW)

HOD DRIVE (50' ROW)

MATCHLINE 2
MATCHLINE 3



MATCHLINE 2
MATCHLINE 3

MATCHLINE 2
MATCHLINE 3





MATCHLINE 3
MATCHLINE 4



MATCHLINE 3
MATCHLINE 4

MATCHLINE 3
MATCHLINE 4

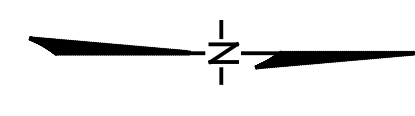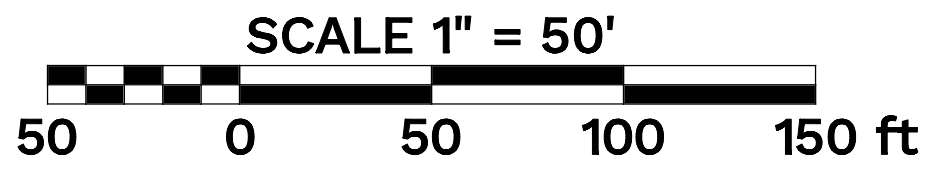

NOTES:
1. SEWER SERVICE MEASUREMENTS ARE TAKEN FROM THE NEAREST DOWNSTREAM MANHOLE.
2. WATER SERVICE MEASUREMENTS ARE TAKEN FROM THE LOT CORNER CLOSEST TO THE TEXT.
3. THE ORANGE LINE SHOWS THE BOUNDARY OF PHASE 1A.

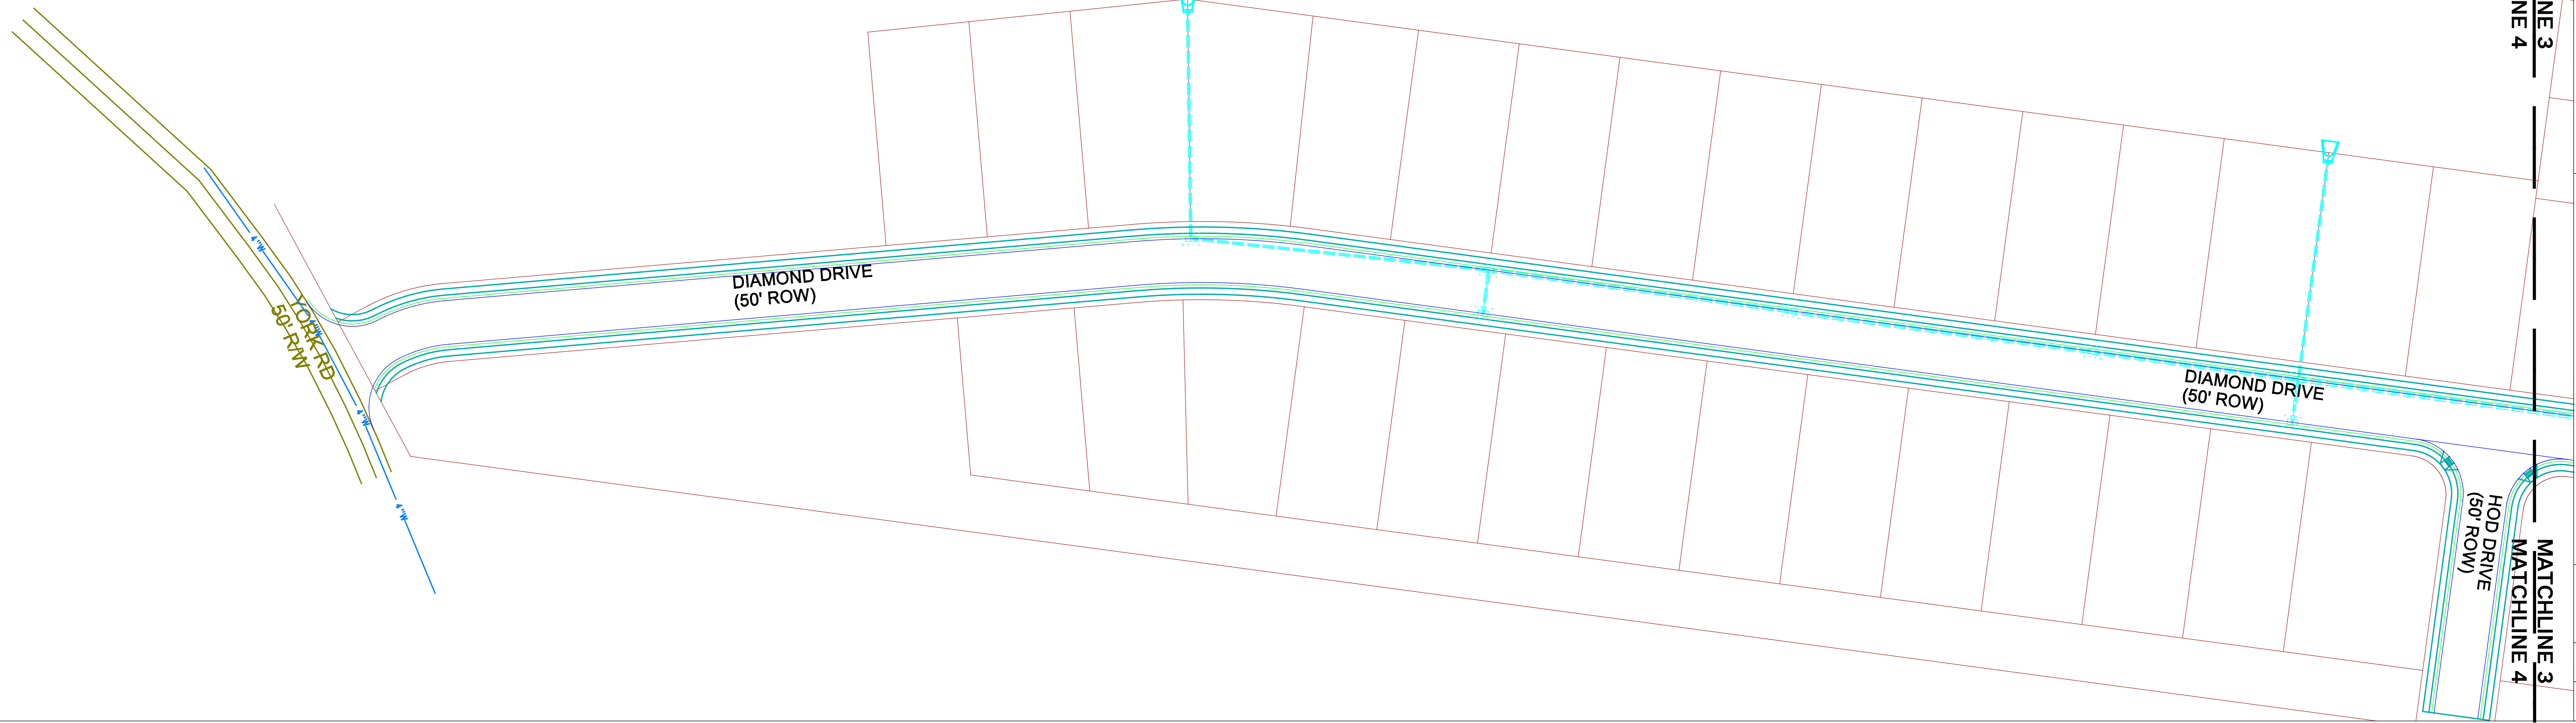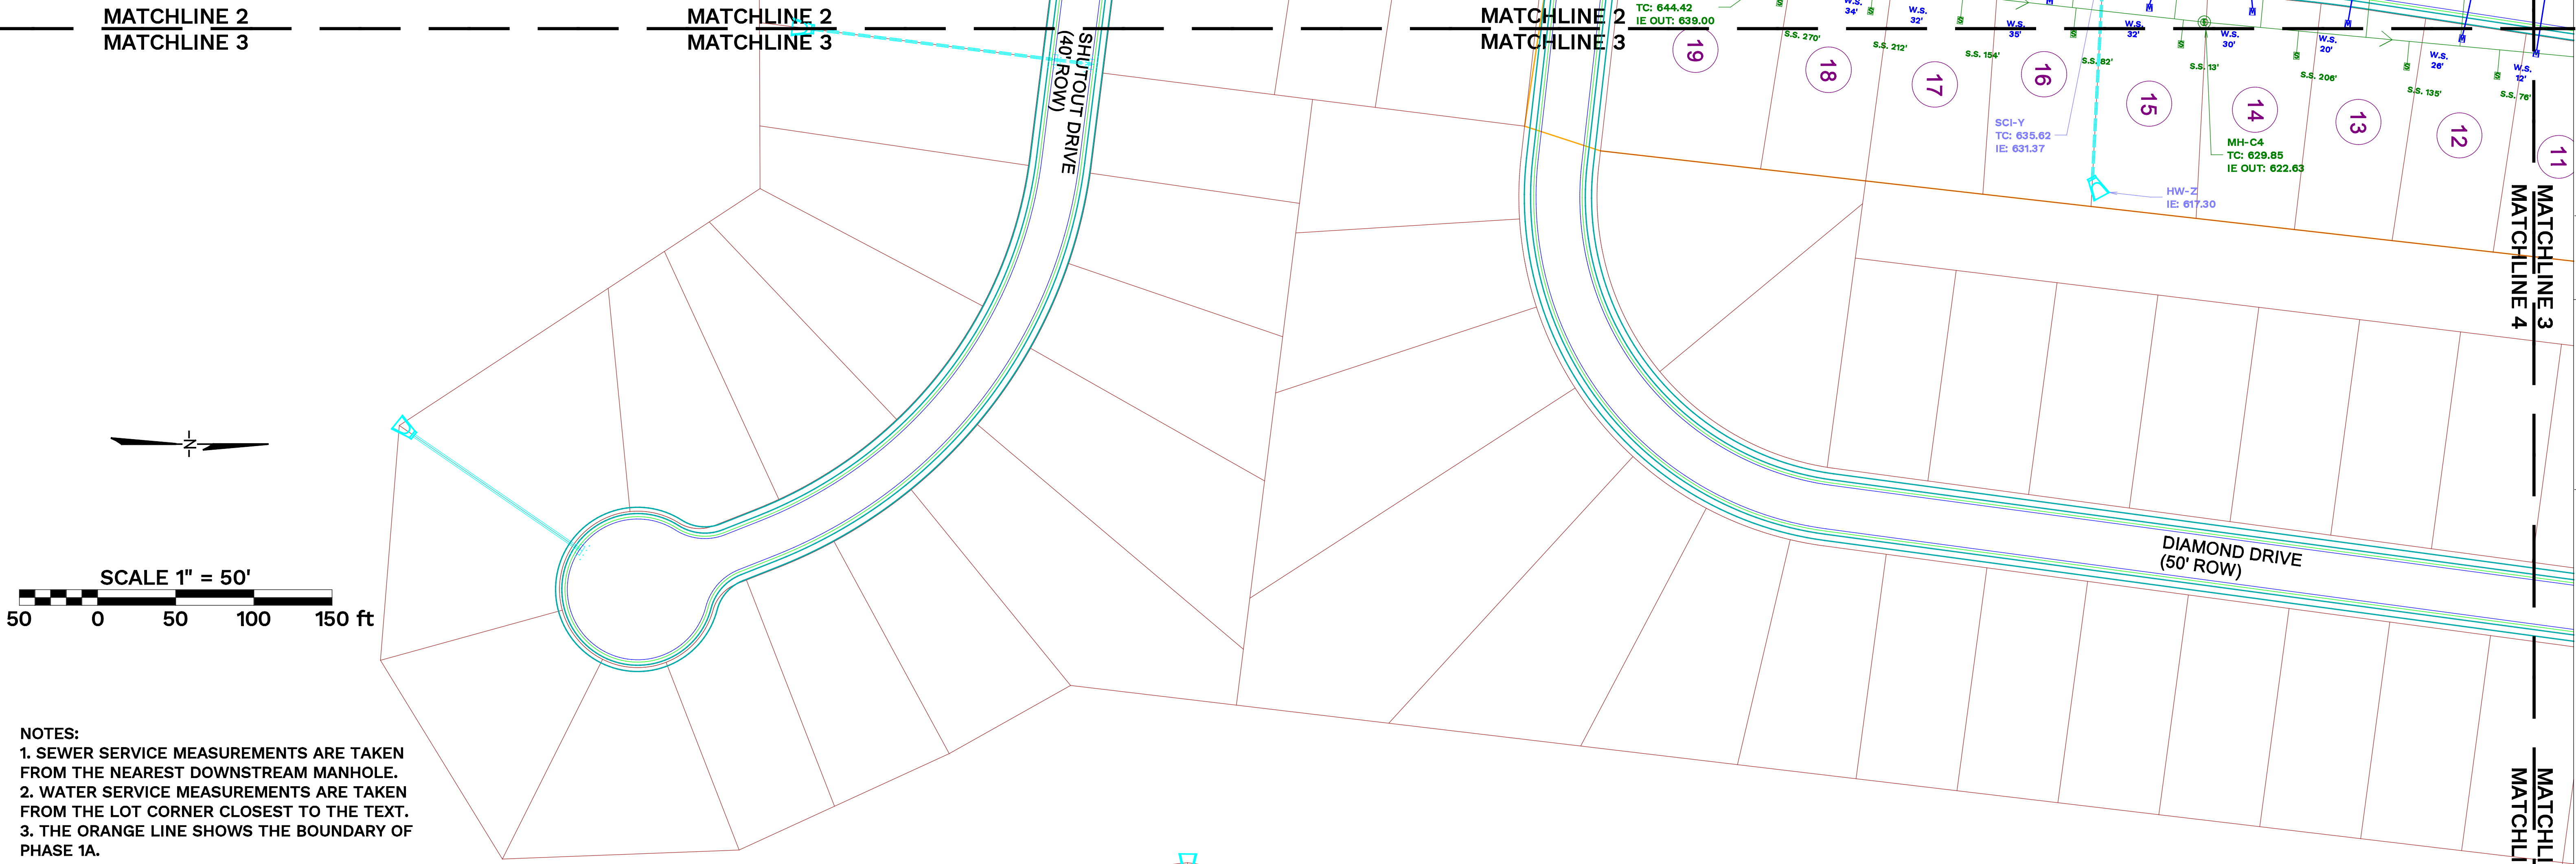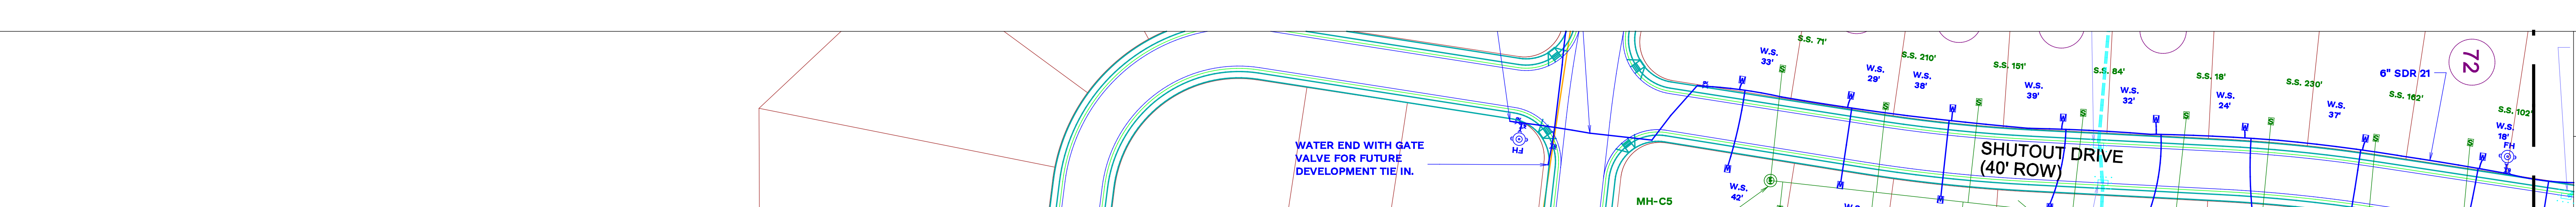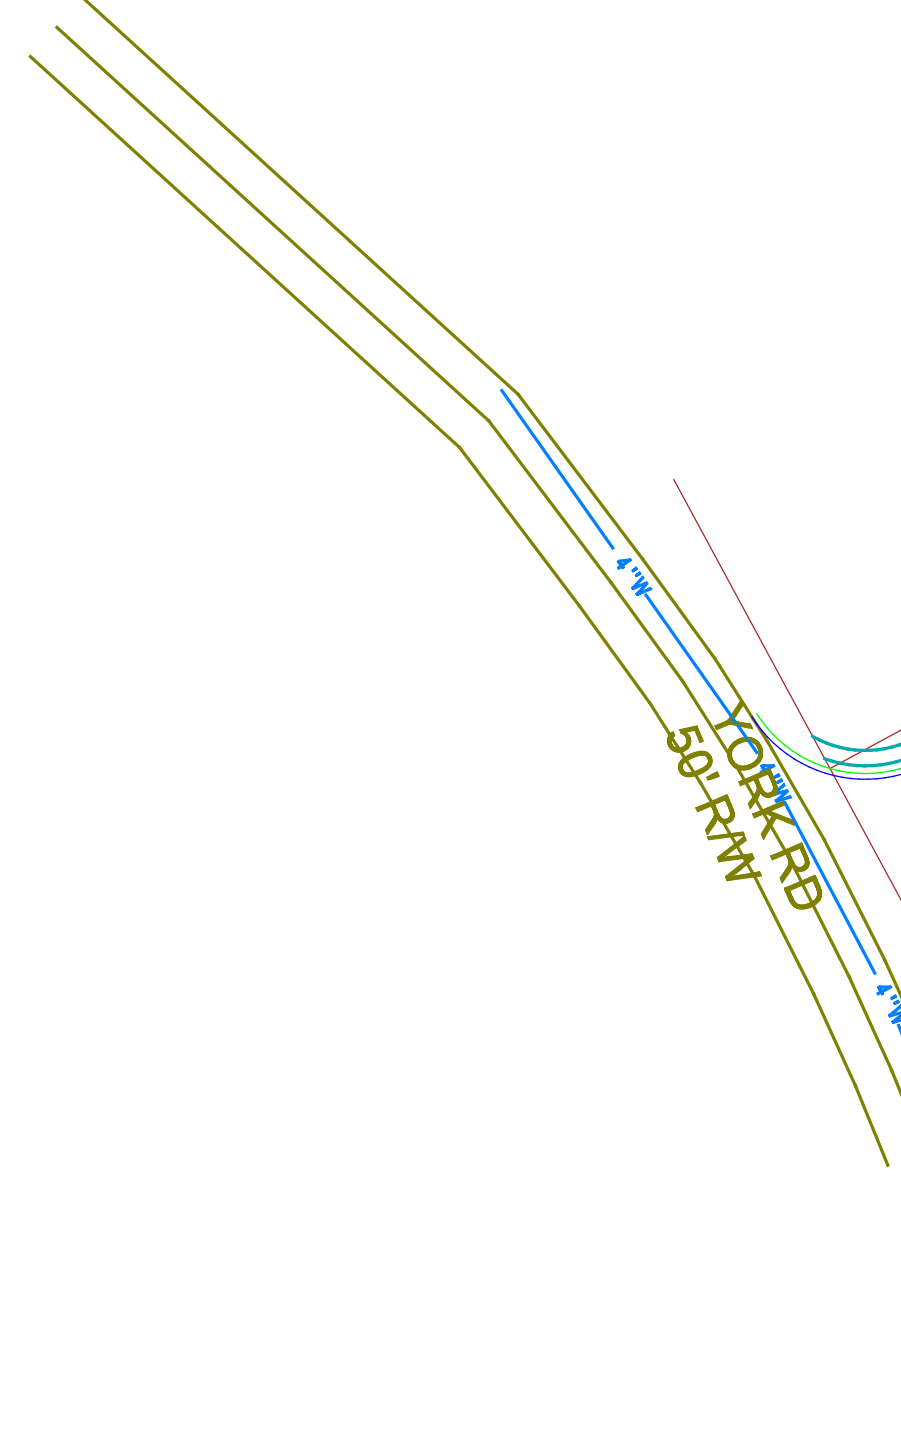

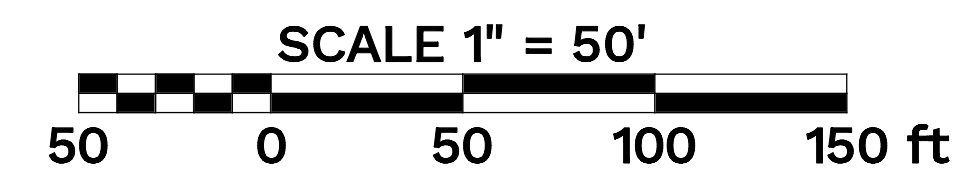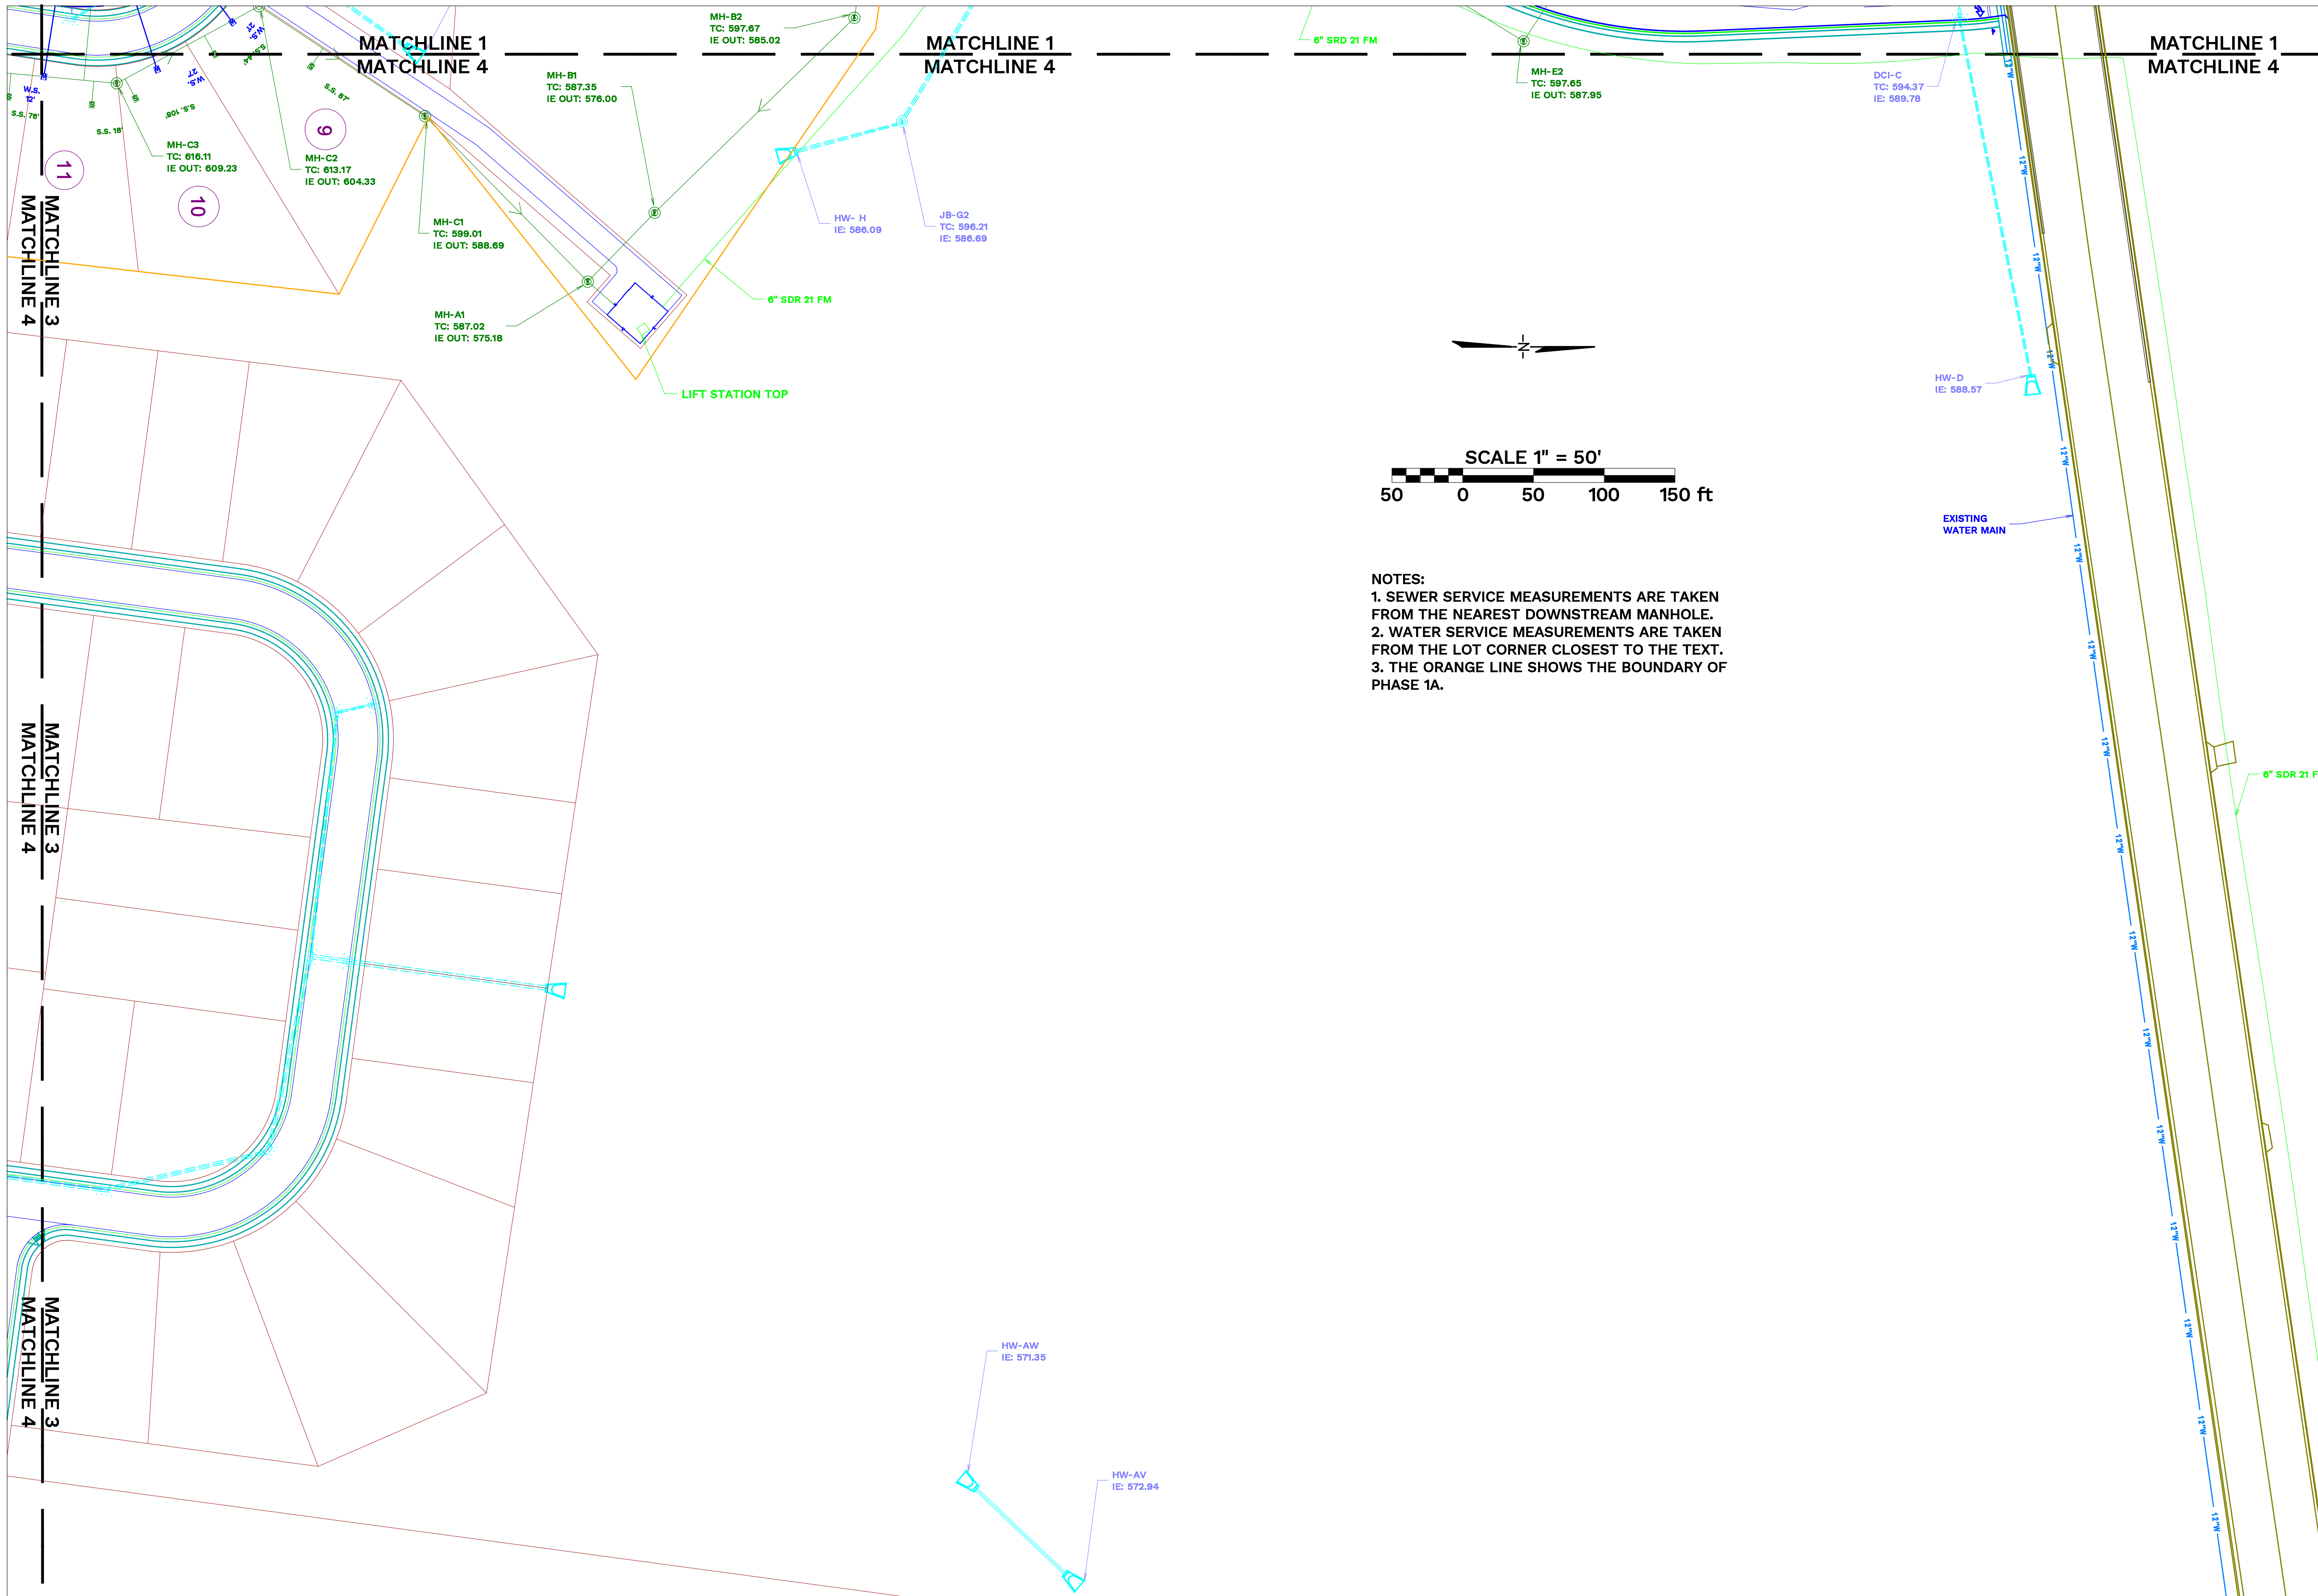

- NOTES:
1. SEWER SERVICE MEASUREMENTS ARE TAKEN FROM THE NEAREST DOWNSTREAM MANHOLE.
 2. WATER SERVICE MEASUREMENTS ARE TAKEN FROM THE LOT CORNER CLOSEST TO THE TEXT.
 3. THE ORANGE LINE SHOWS THE BOUNDARY OF PHASE 1A.

NO.	REVISIONS	DATE:

AS BUILT EXHIBIT
LISENSEE FIELDS
CLARKSVILLE, TN

BYARD CONSTRUCTION, LLC.
324 INNOVATION WAY
CLARKSVILLE, TN
OFFICE: (931) 358 - 4700

