


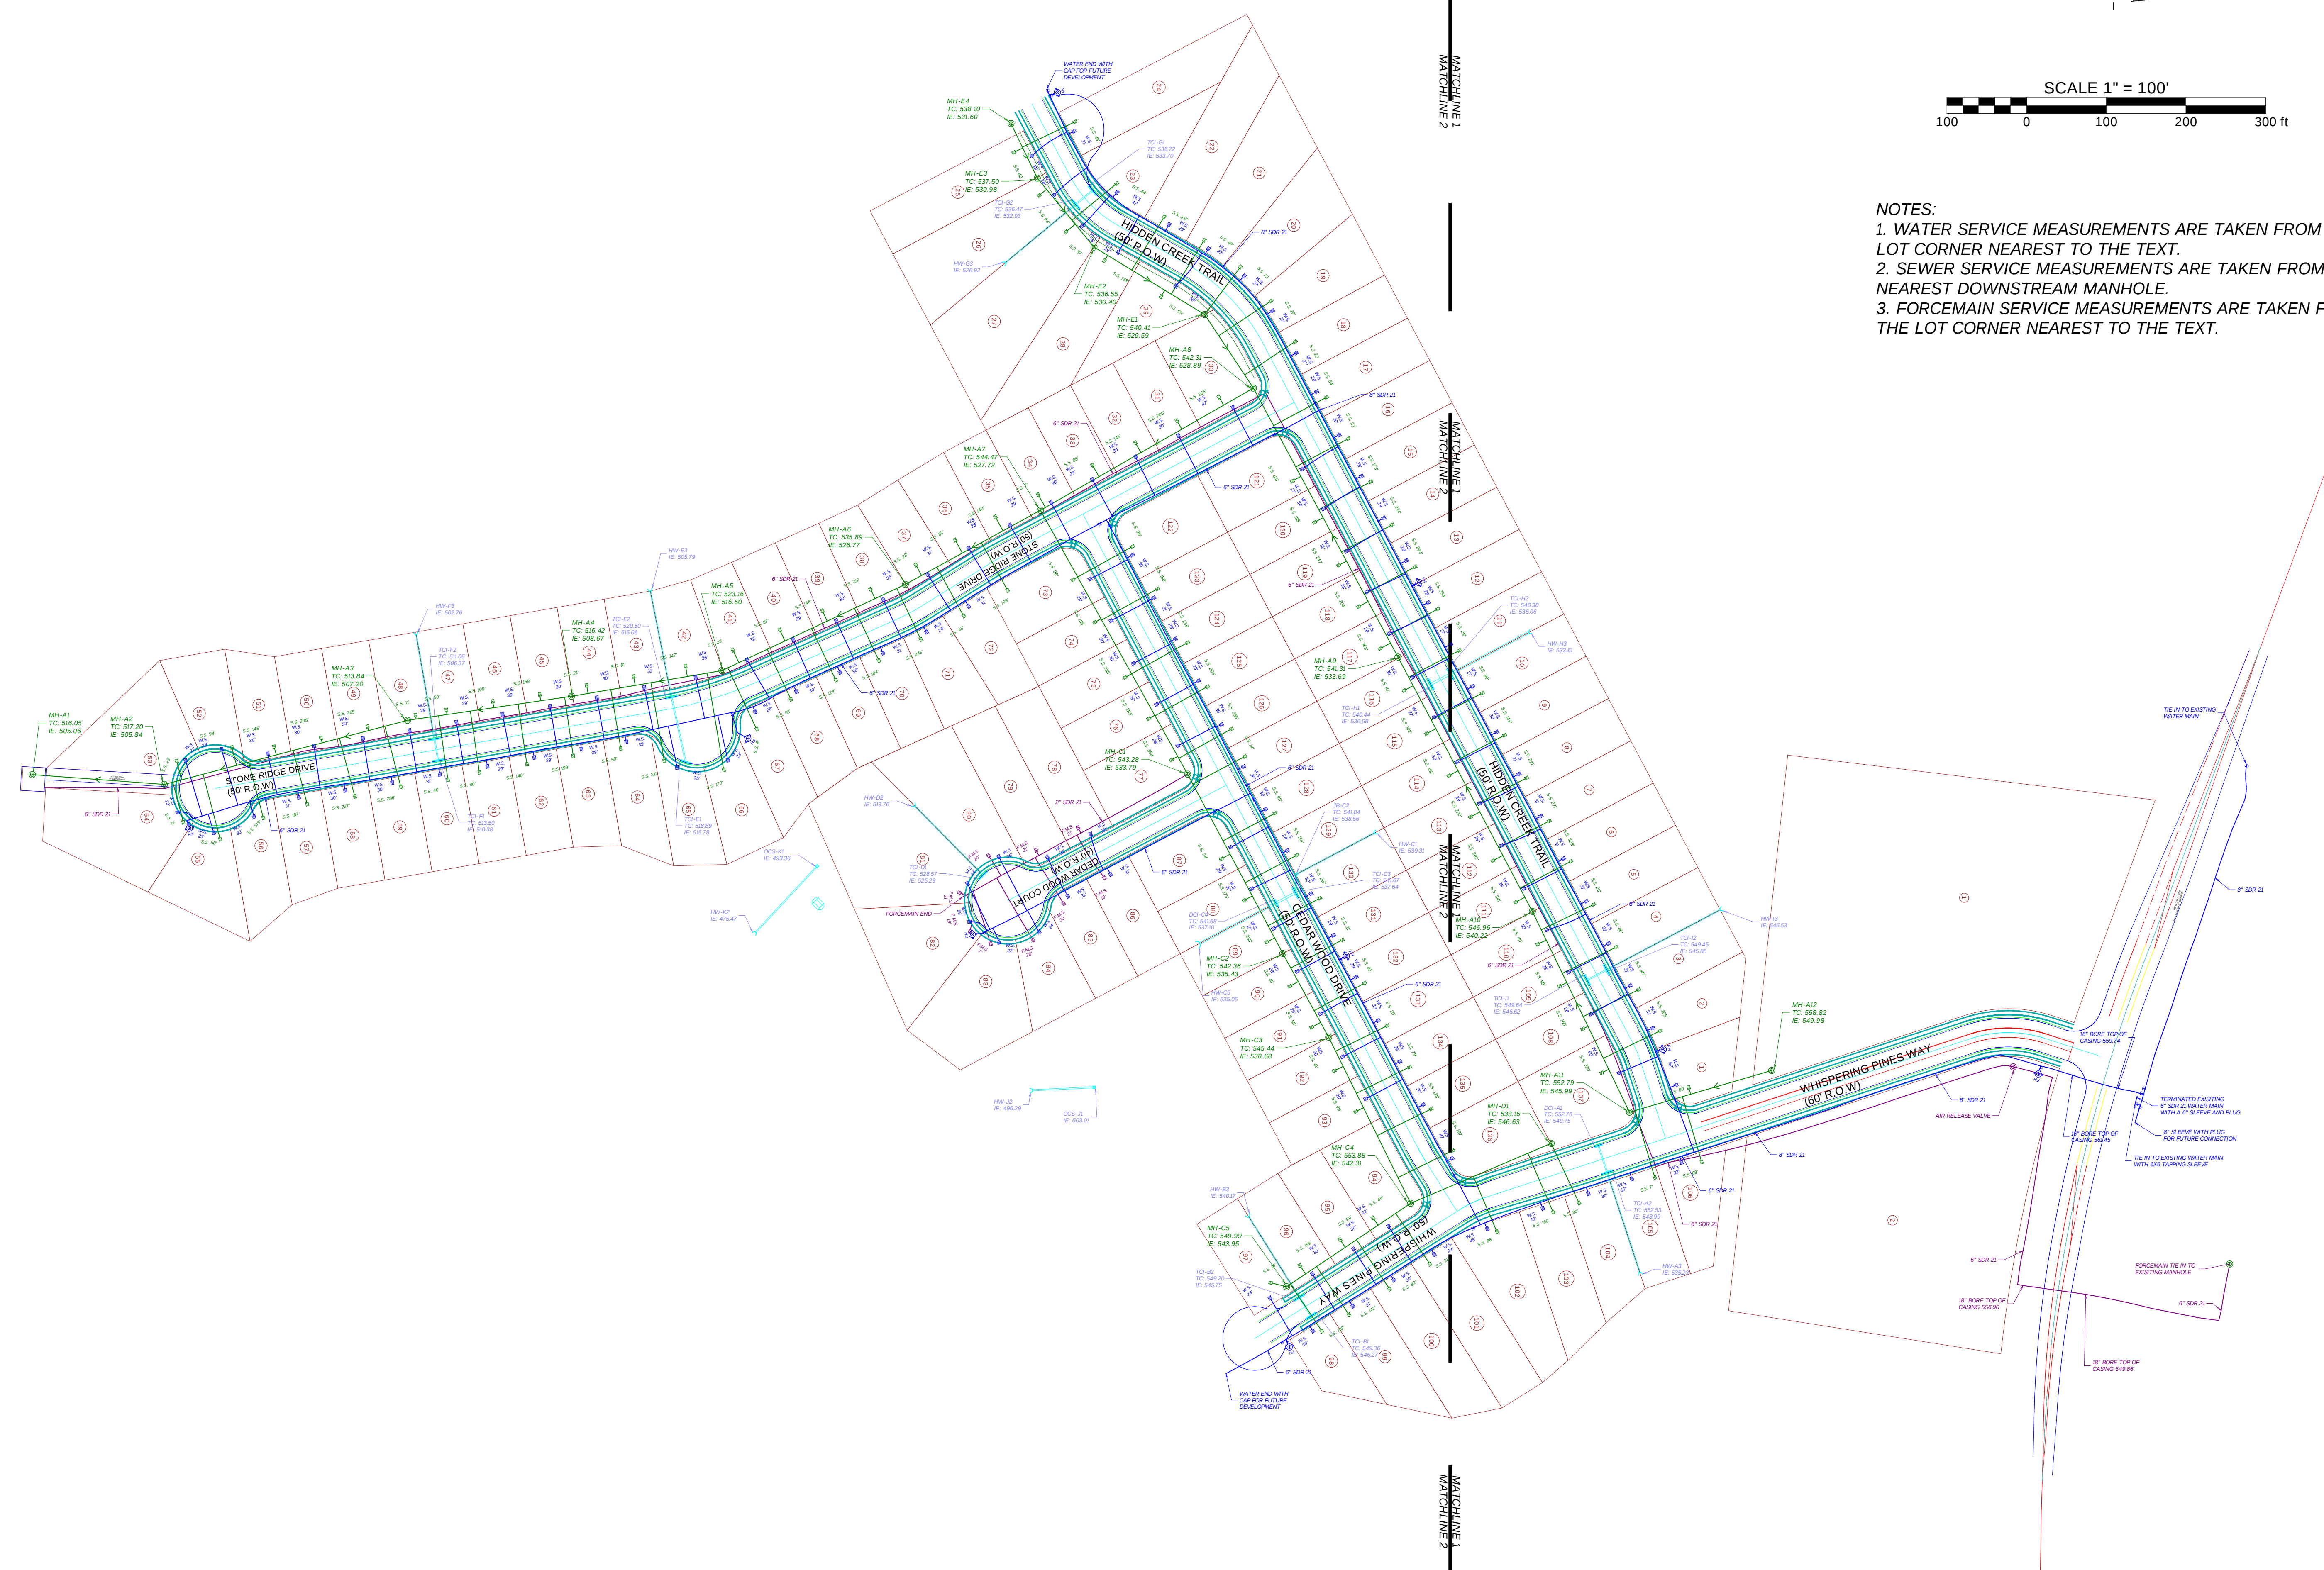

NOTES:

1. WATER SERVICE MEASUREMENTS ARE TAKEN FROM THE LOT CORNER NEAREST TO THE TEXT.
2. SEWER SERVICE MEASUREMENTS ARE TAKEN FROM THE NEAREST DOWNSTREAM MANHOLE.
3. FORCEMAIN SERVICE MEASUREMENTS ARE TAKEN FROM THE LOT CORNER NEAREST TO THE TEXT.

 BYARD CONSTRUCTION, LLC 324 INNOVATION WAY CLARKSVILLE, TN OFFICE: (931) 358-4700	AS-BUILT EXHIBIT PG 1 MILLER FARMS CLARKSVILLE, TN			NO.	REVISIONS	DATE:
SHEET						
1 OF 3						