Bell Trace Section 1

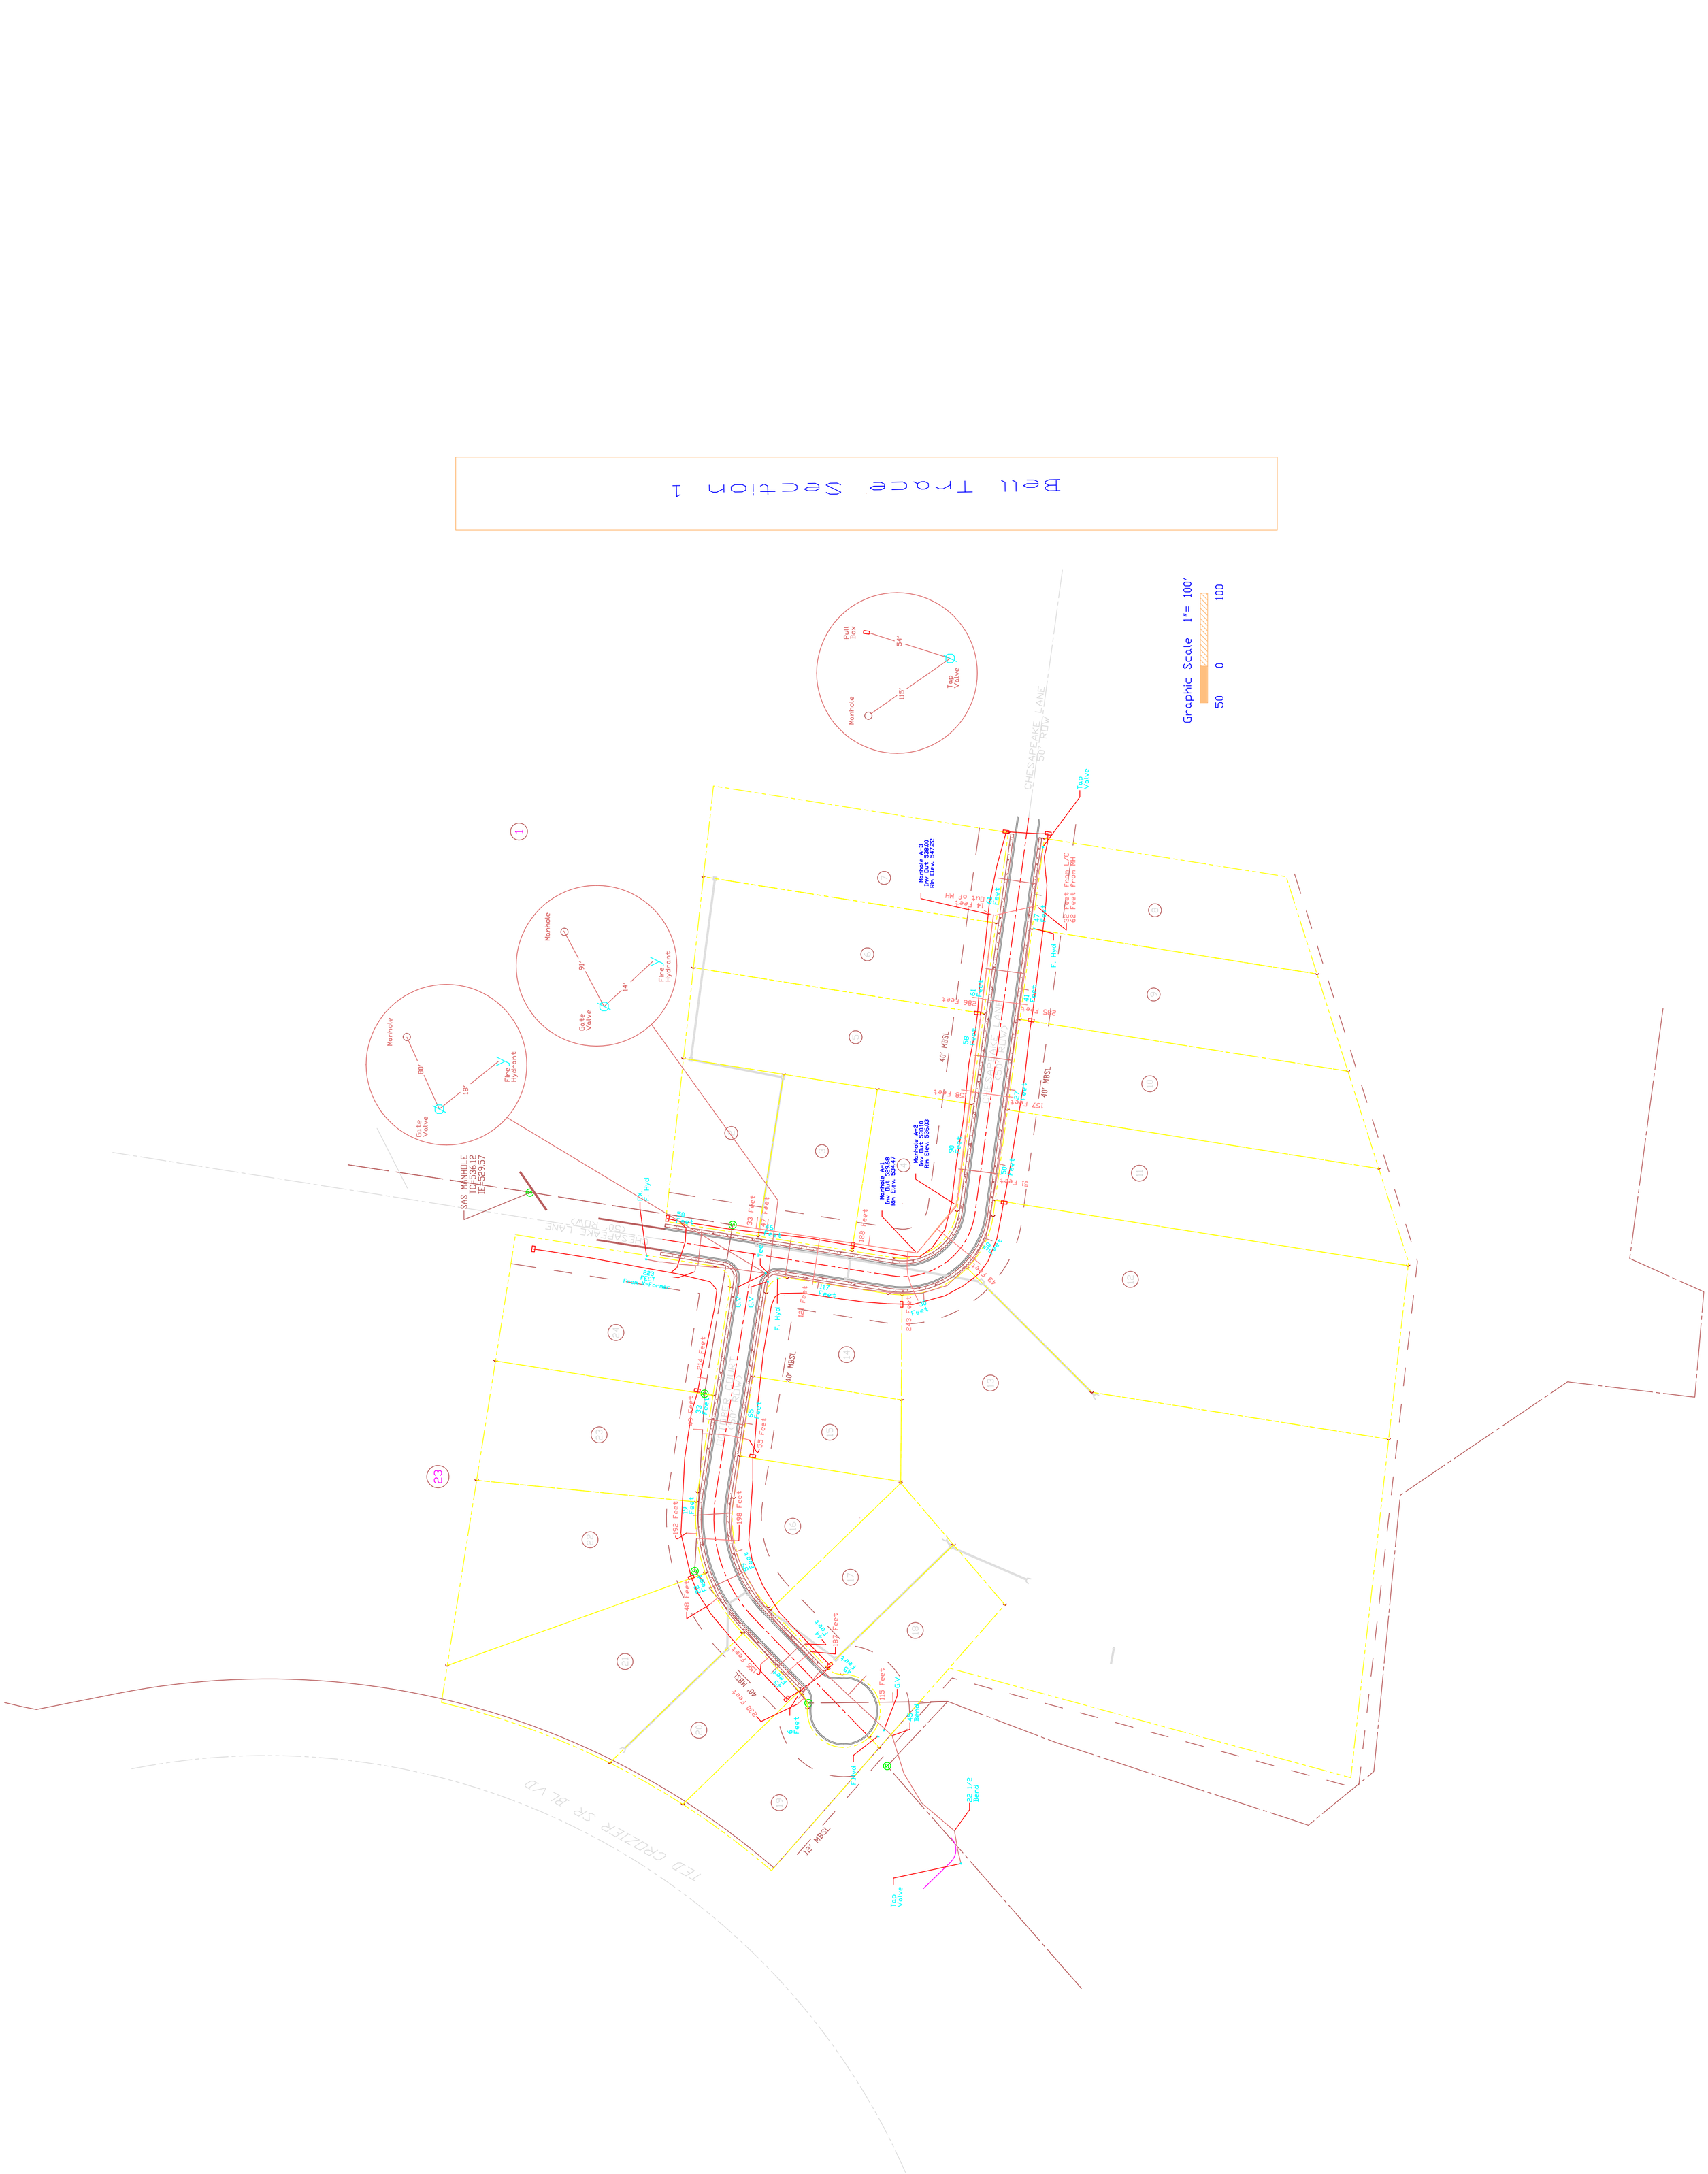

Bell Trace As-Built File

11/1/2010 10:01:52 AM, 1:100