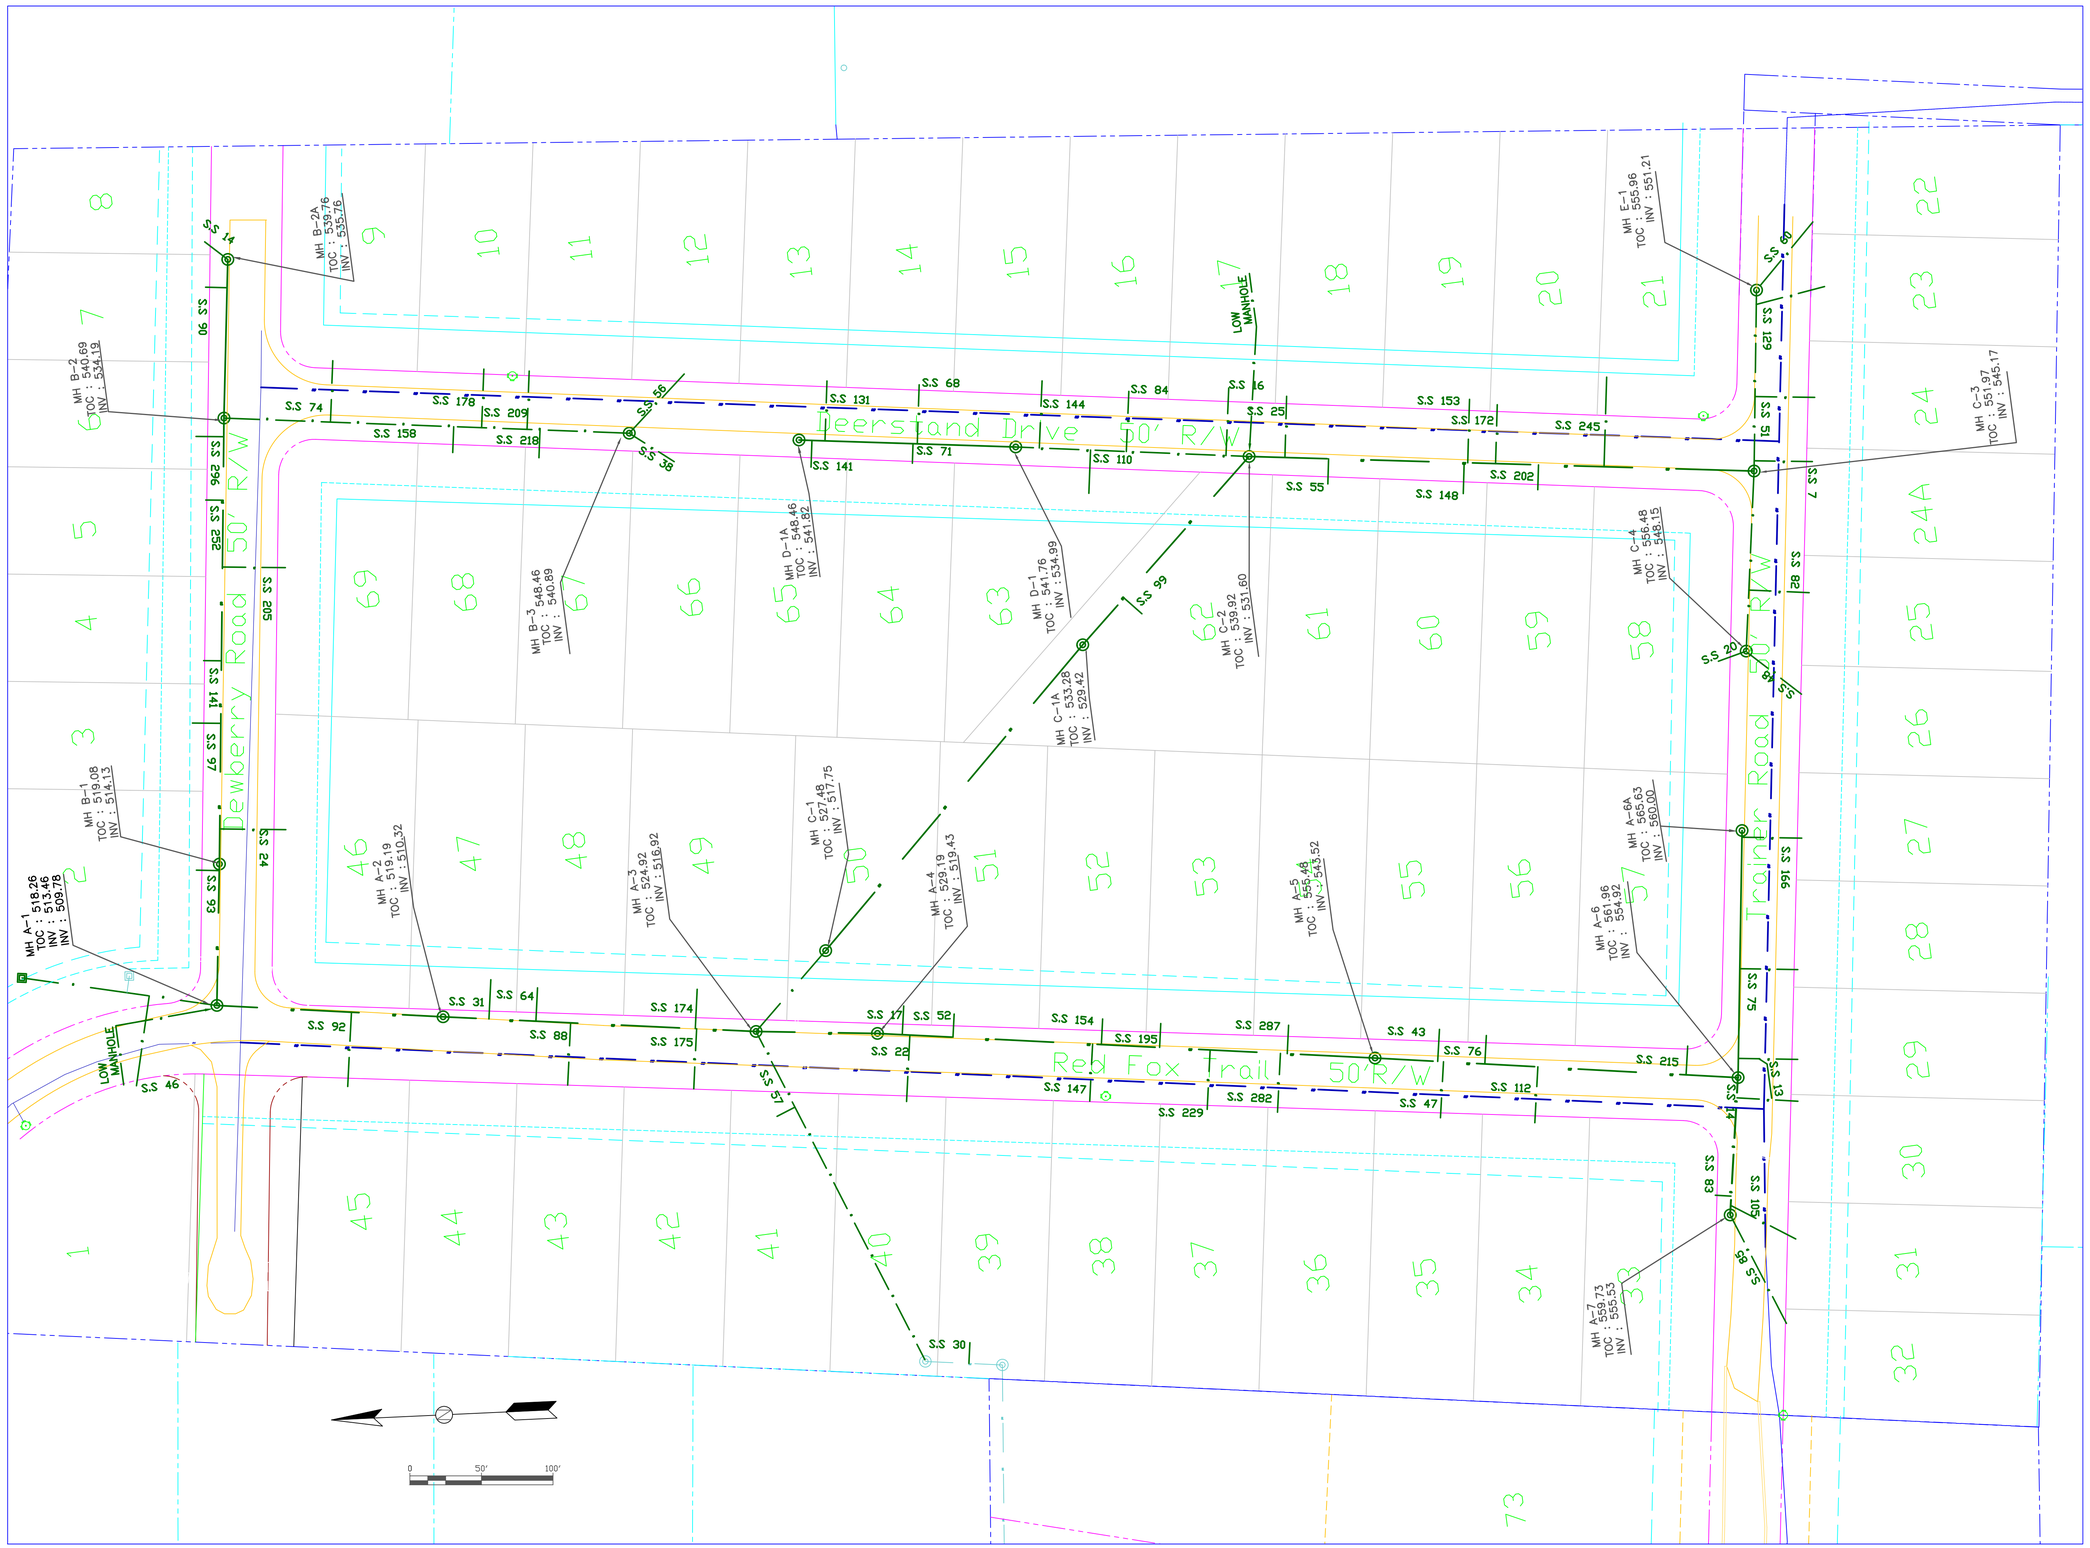

BYARD construction, LLC
CLARKSVILLE, TN.

NOTES:

1. All Sewer Service measurements are taken from the nearest downstream manhole.
2. All Water Service measurements are taken from the nearest lot corner.
3. Manholes A-6A, B-2A, and D1A were added during new construction.

site map

No.	Revision/Issue	Date
No.	Revision/Issue	Date

Project title/info

Sheet Title
UTILITY AS-BUILTS SEWER

Project Name	Sheet #
Deer Hollow	AB-S
Date: 1/22/2014	
Scale: 1" = 50'	

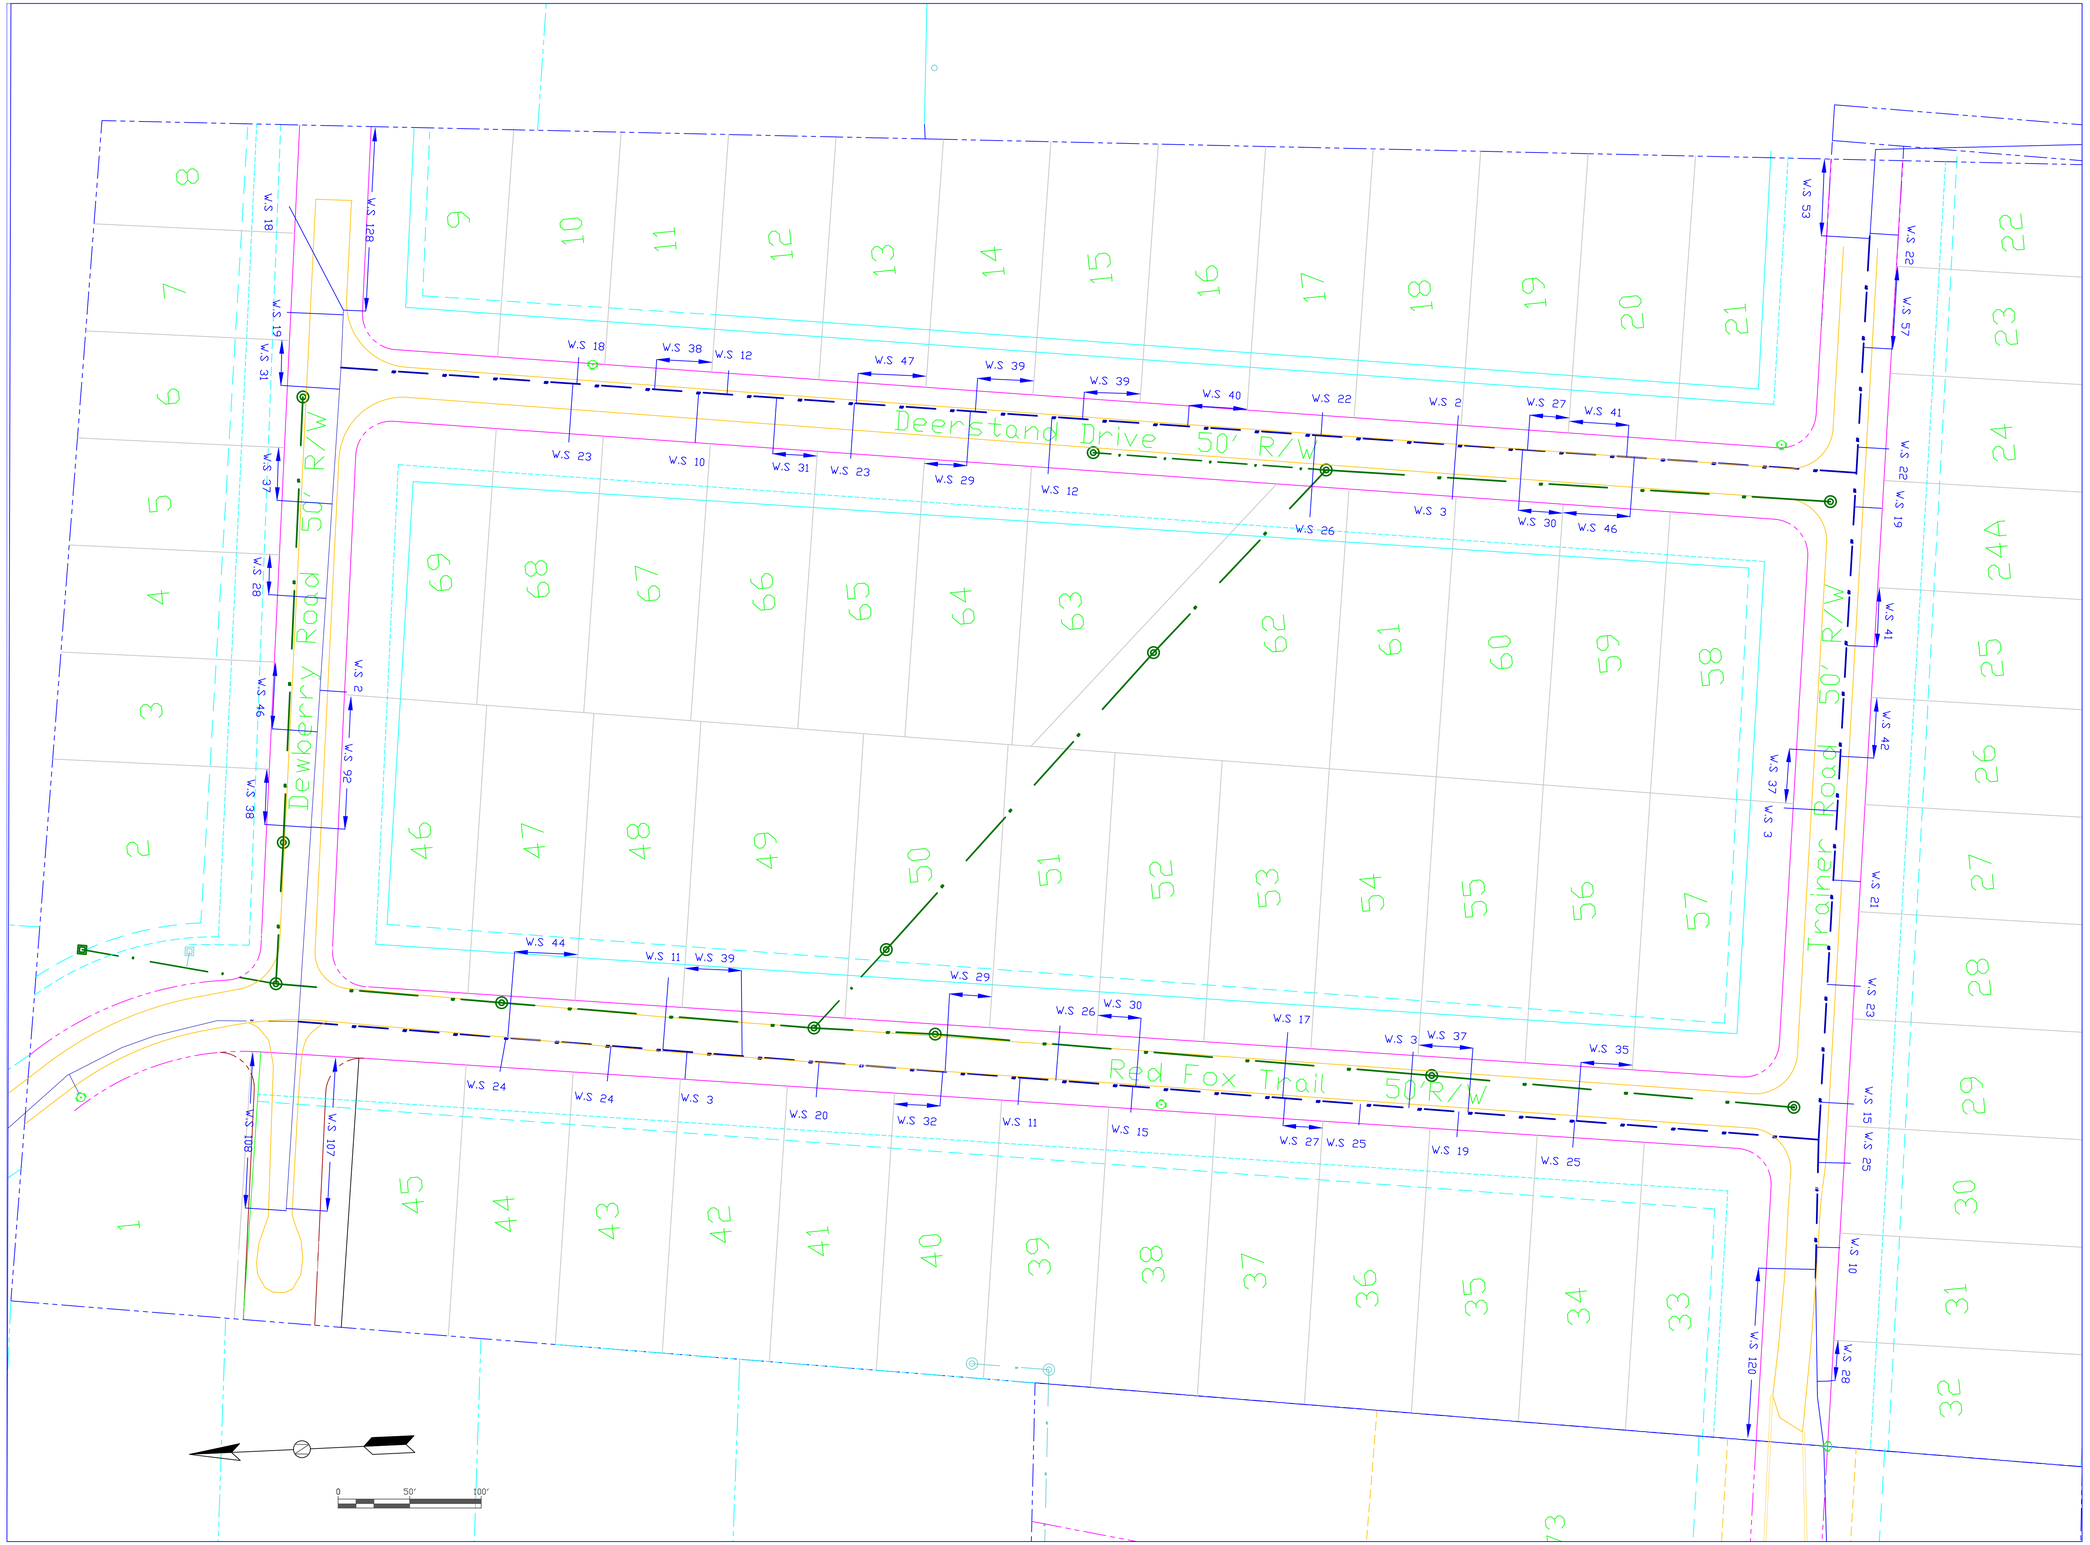

BYARD Construction, LLC.
CLARKSVILLE, TN.

NOTES:

1. All Sewer Service measurements are taken from the nearest downstream manhole.
2. All Water Service measurements are taken from the nearest lot corner.
3. Manholes A–6A, B–2A, and D1A were added during new construction.

site map

No.	Revision/Issue	Date
No.	Revision/Issue	Date

Project title/info

Sheet Title
UTILITY AS–BUILTS
WATER

Project Name	Sheet #
Deer Hollow	AB–W
Date: 1/22/2014	
Scale: 1" = 50'	

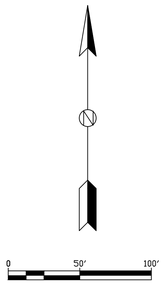

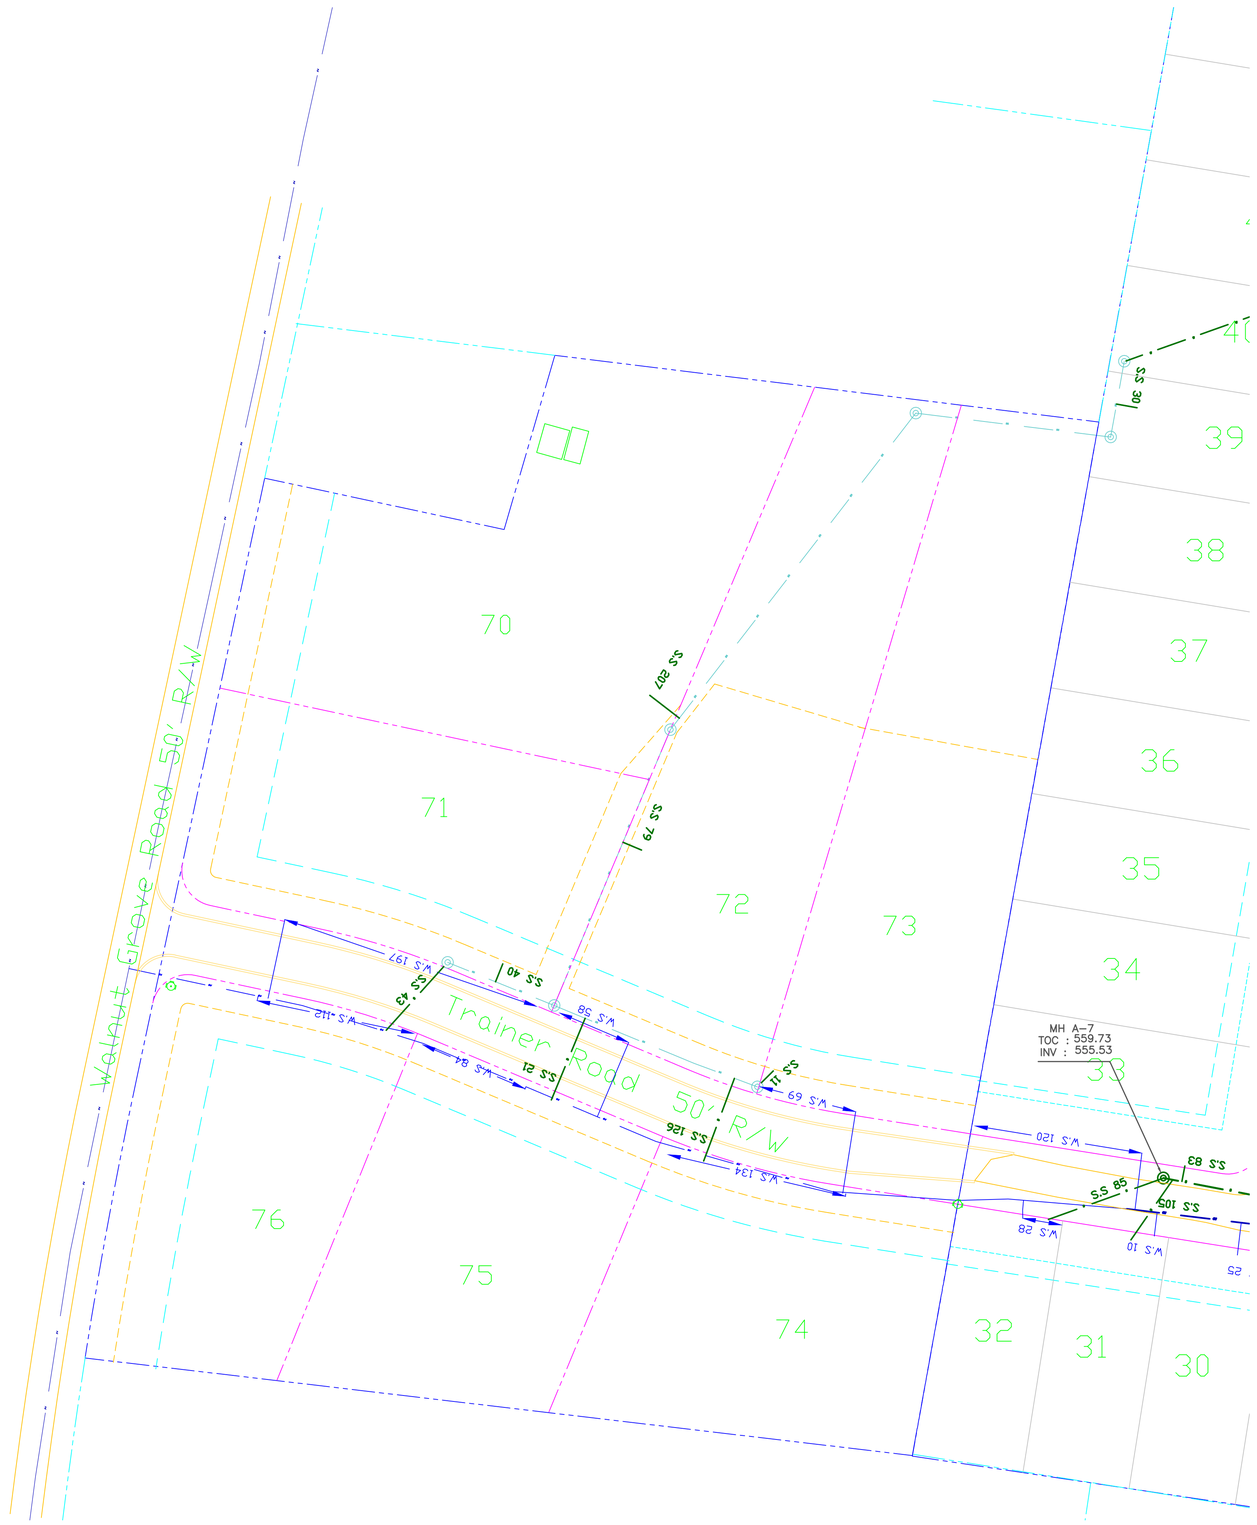

NOTES:

1. All Sewer Service measurements are taken from the nearest downstream manhole.
2. All Water Service measurements are taken from the nearest lot corner.
3. Manholes A-6A, B-2A, and D1A were added during new construction.

Notes:

No.	Revision/Issue	Date
No.	Revision/Issue	Date

Project title/info

Sheet Title
UTILITY AS-BUILTS
NEW SECTION

Project Name	Sheet #
Deer Hollow	AB-N1
Date: 1/22/2014	
Scale: 1" = 50'	