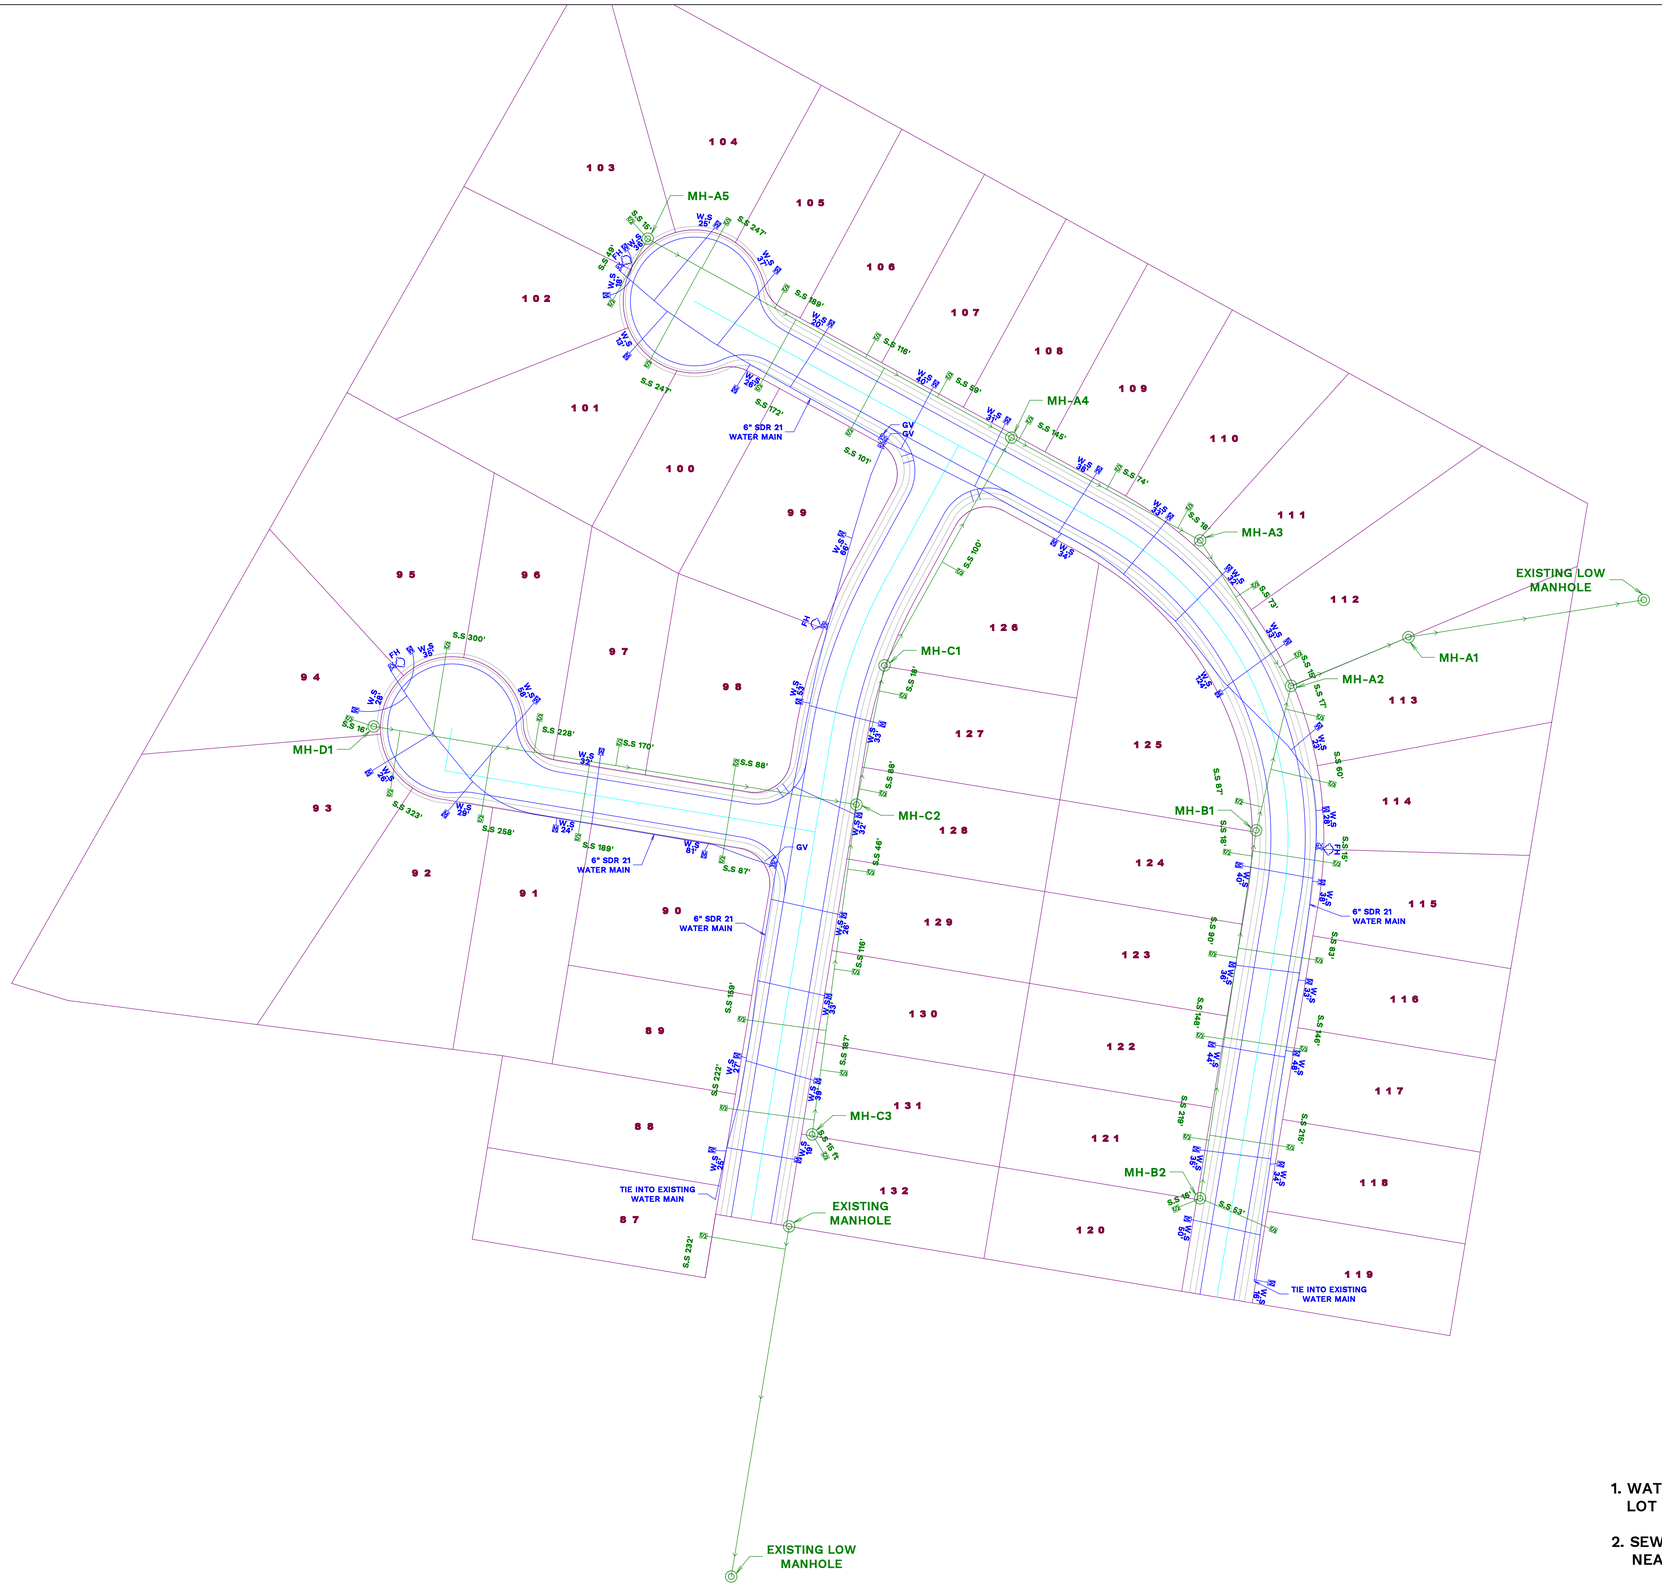
MH-A5
MH-A4
MH-A3
MH-A2
MH-A1
MH-C1
MH-C2
MH-C3
MH-D1
MH-B1
MH-B2
EXISTING LOW MANHOLE
EXISTING MANHOLE
EXISTING LOW MANHOLE
6" SDR 21 WATER MAIN
6" SDR 21 WATER MAIN
6" SDR 21 WATER MAIN
6" SDR 21 WATER MAIN
TIE INTO EXISTING WATER MAIN
TIE INTO EXISTING WATER MAIN
GV
GV
GV
S.S 247'
S.S 189'
S.S 116'
S.S 59'
S.S 145'
S.S 74'
S.S 18'
S.S 72'
S.S 77'
S.S 60'
S.S 114'
S.S 67'
S.S 18'
S.S 15'
S.S 90'
S.S 83'
S.S 148'
S.S 148'
S.S 259'
S.S 259'
S.S 53'
S.S 46'
S.S 87'
S.S 116'
S.S 167'
S.S 222'
S.S 232'
S.S 189'
S.S 258'
S.S 323'
S.S 228'
S.S 170'
S.S 88'
S.S 300'
S.S 247'
S.S 172'
S.S 107'
S.S 100'
S.S 18'
S.S 88'
S.S 55'
S.S 16'
S.S 15'
S.S 49'
S.S 15'
FH
FH
FH