NOTES:

1. WATER SERVICE MEASURMENTS ARE TAKEN FROM THE LOT CORNER NEAREST TO THE MEASURMENT TEXT.

2. SEWER SERVICE MEASURMENTS ARE TAKEN FROM THE NEAREST DOWNSTREAM MANHOLE.

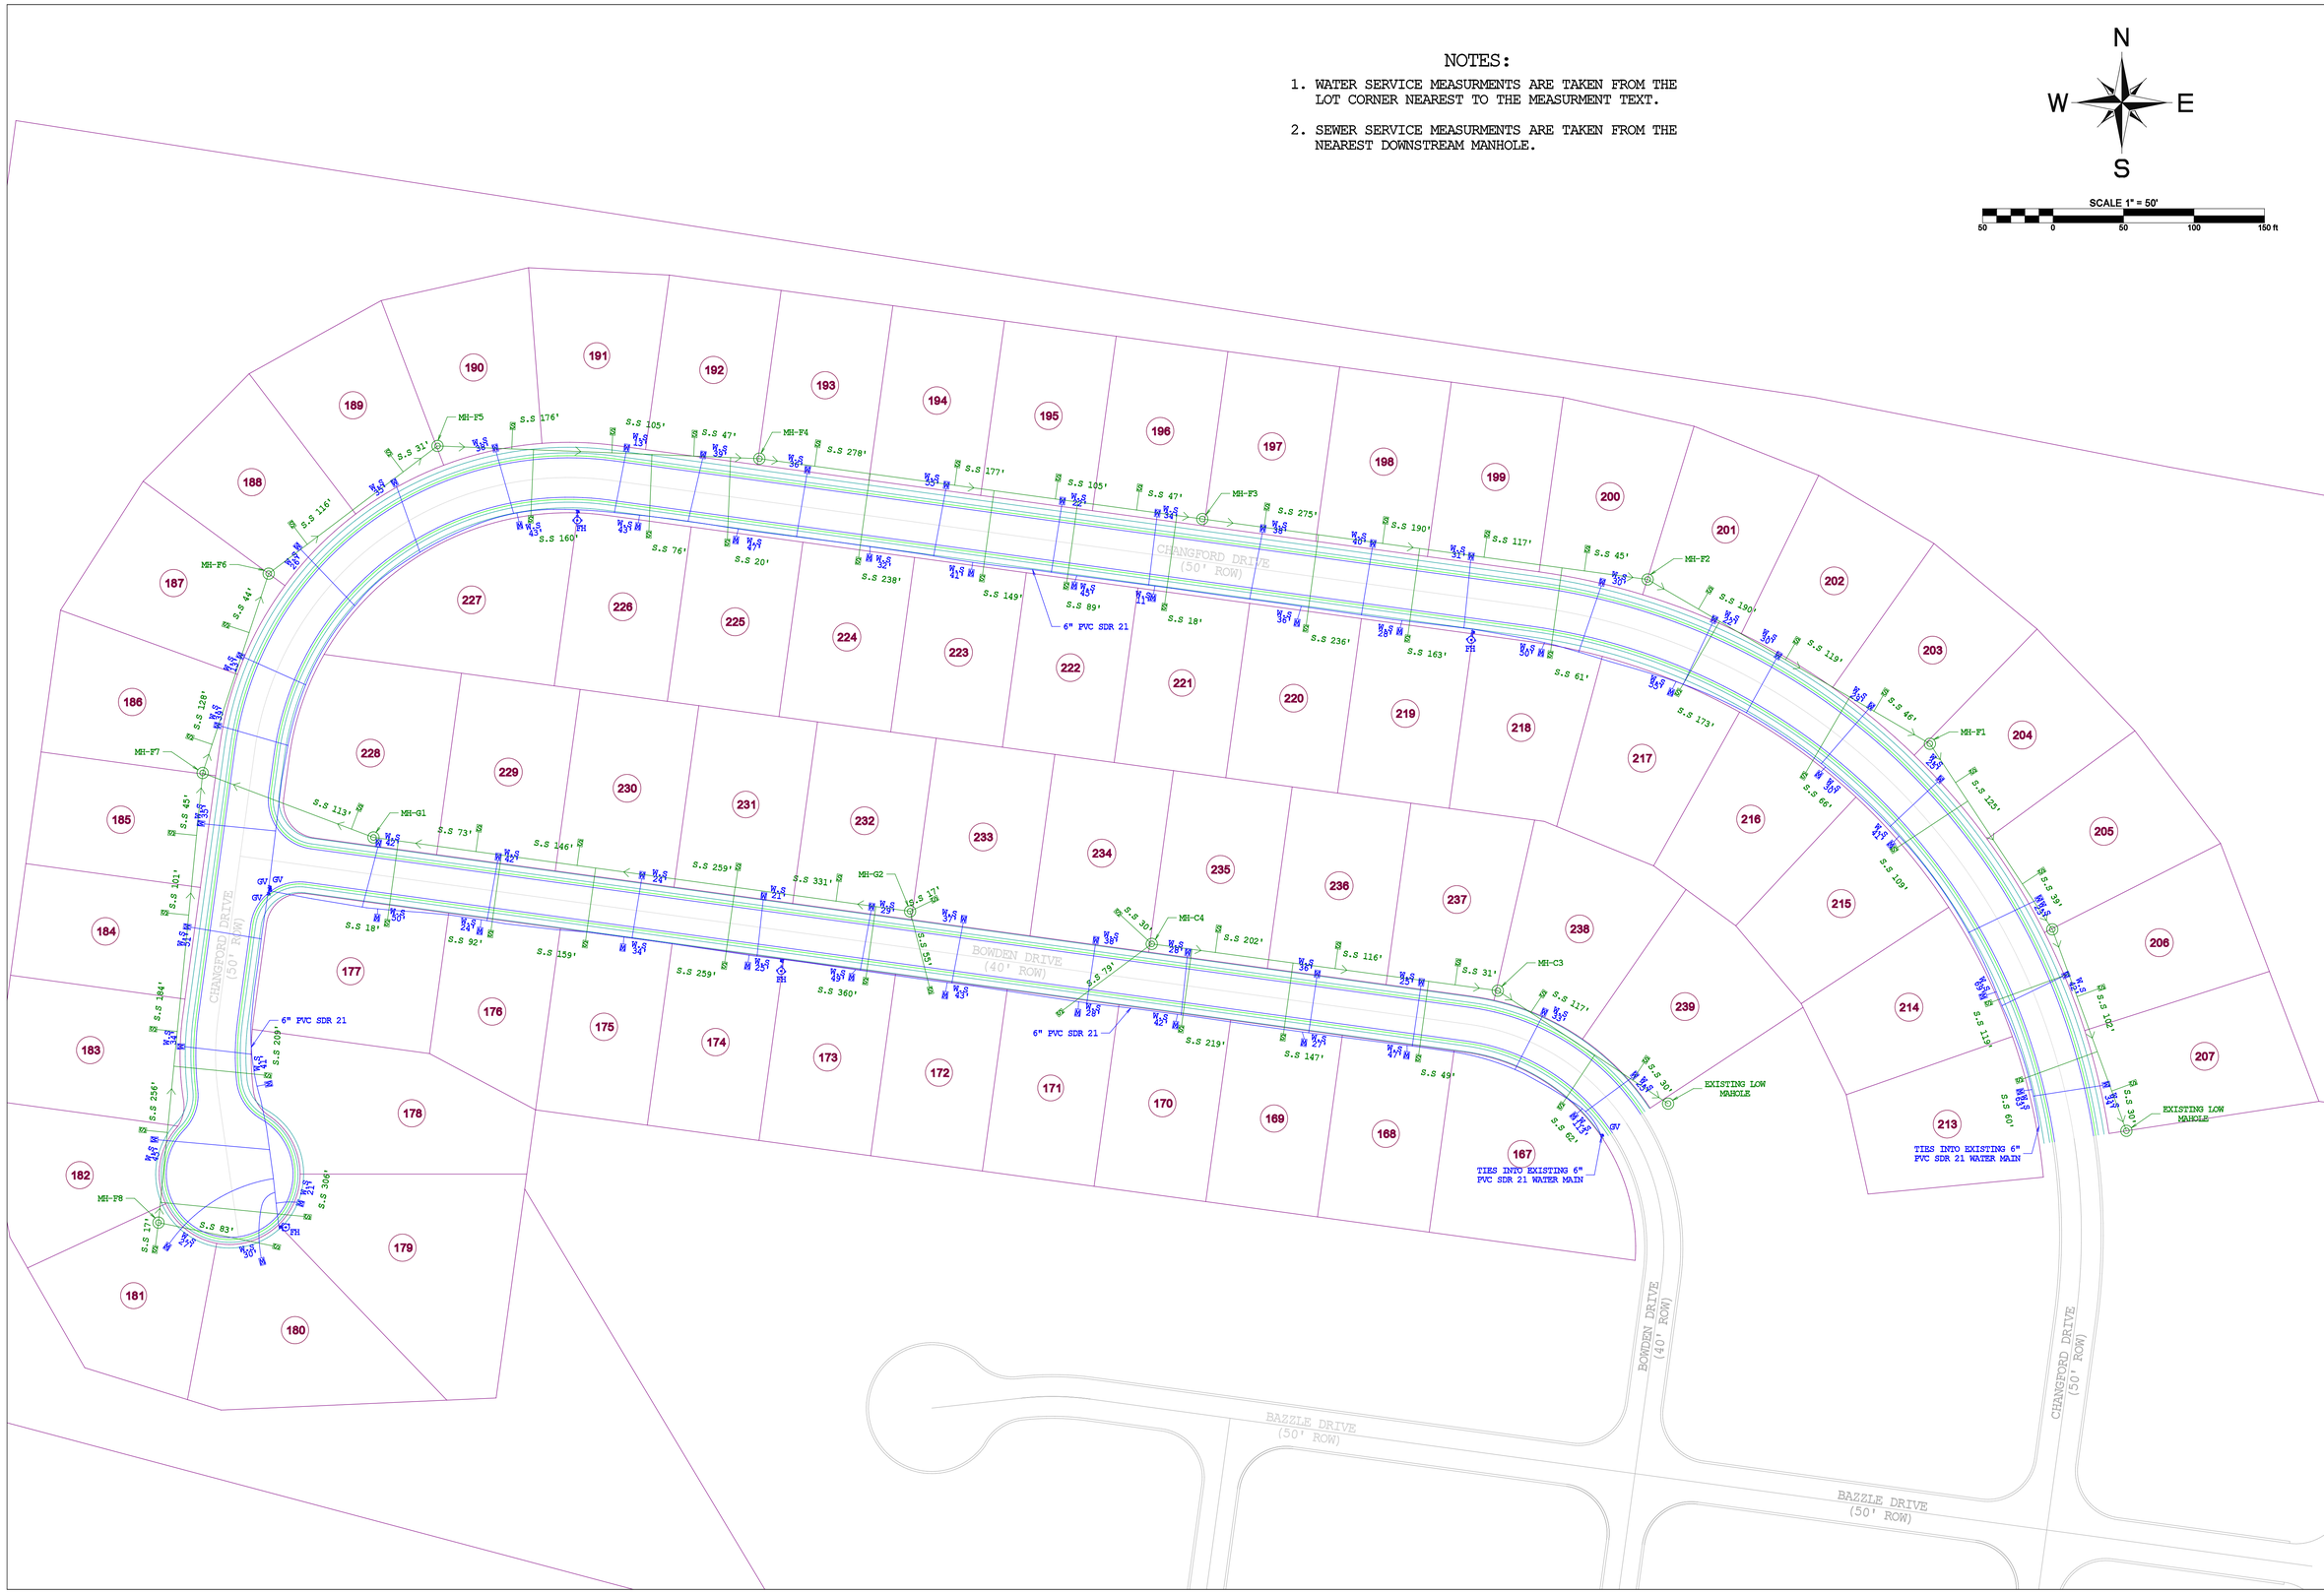

DATE:	REVISIONS	NO.

AS BUILTS
EASTHAVEN SECTION 4
CLARKSVILLE, TN

BYARD CONSTRUCTION, LLC
3136 OLD SANGO ROAD
CLARKSVILLE, TN
OFFICE: (931) 358-4700

SHEET
1 OF 1