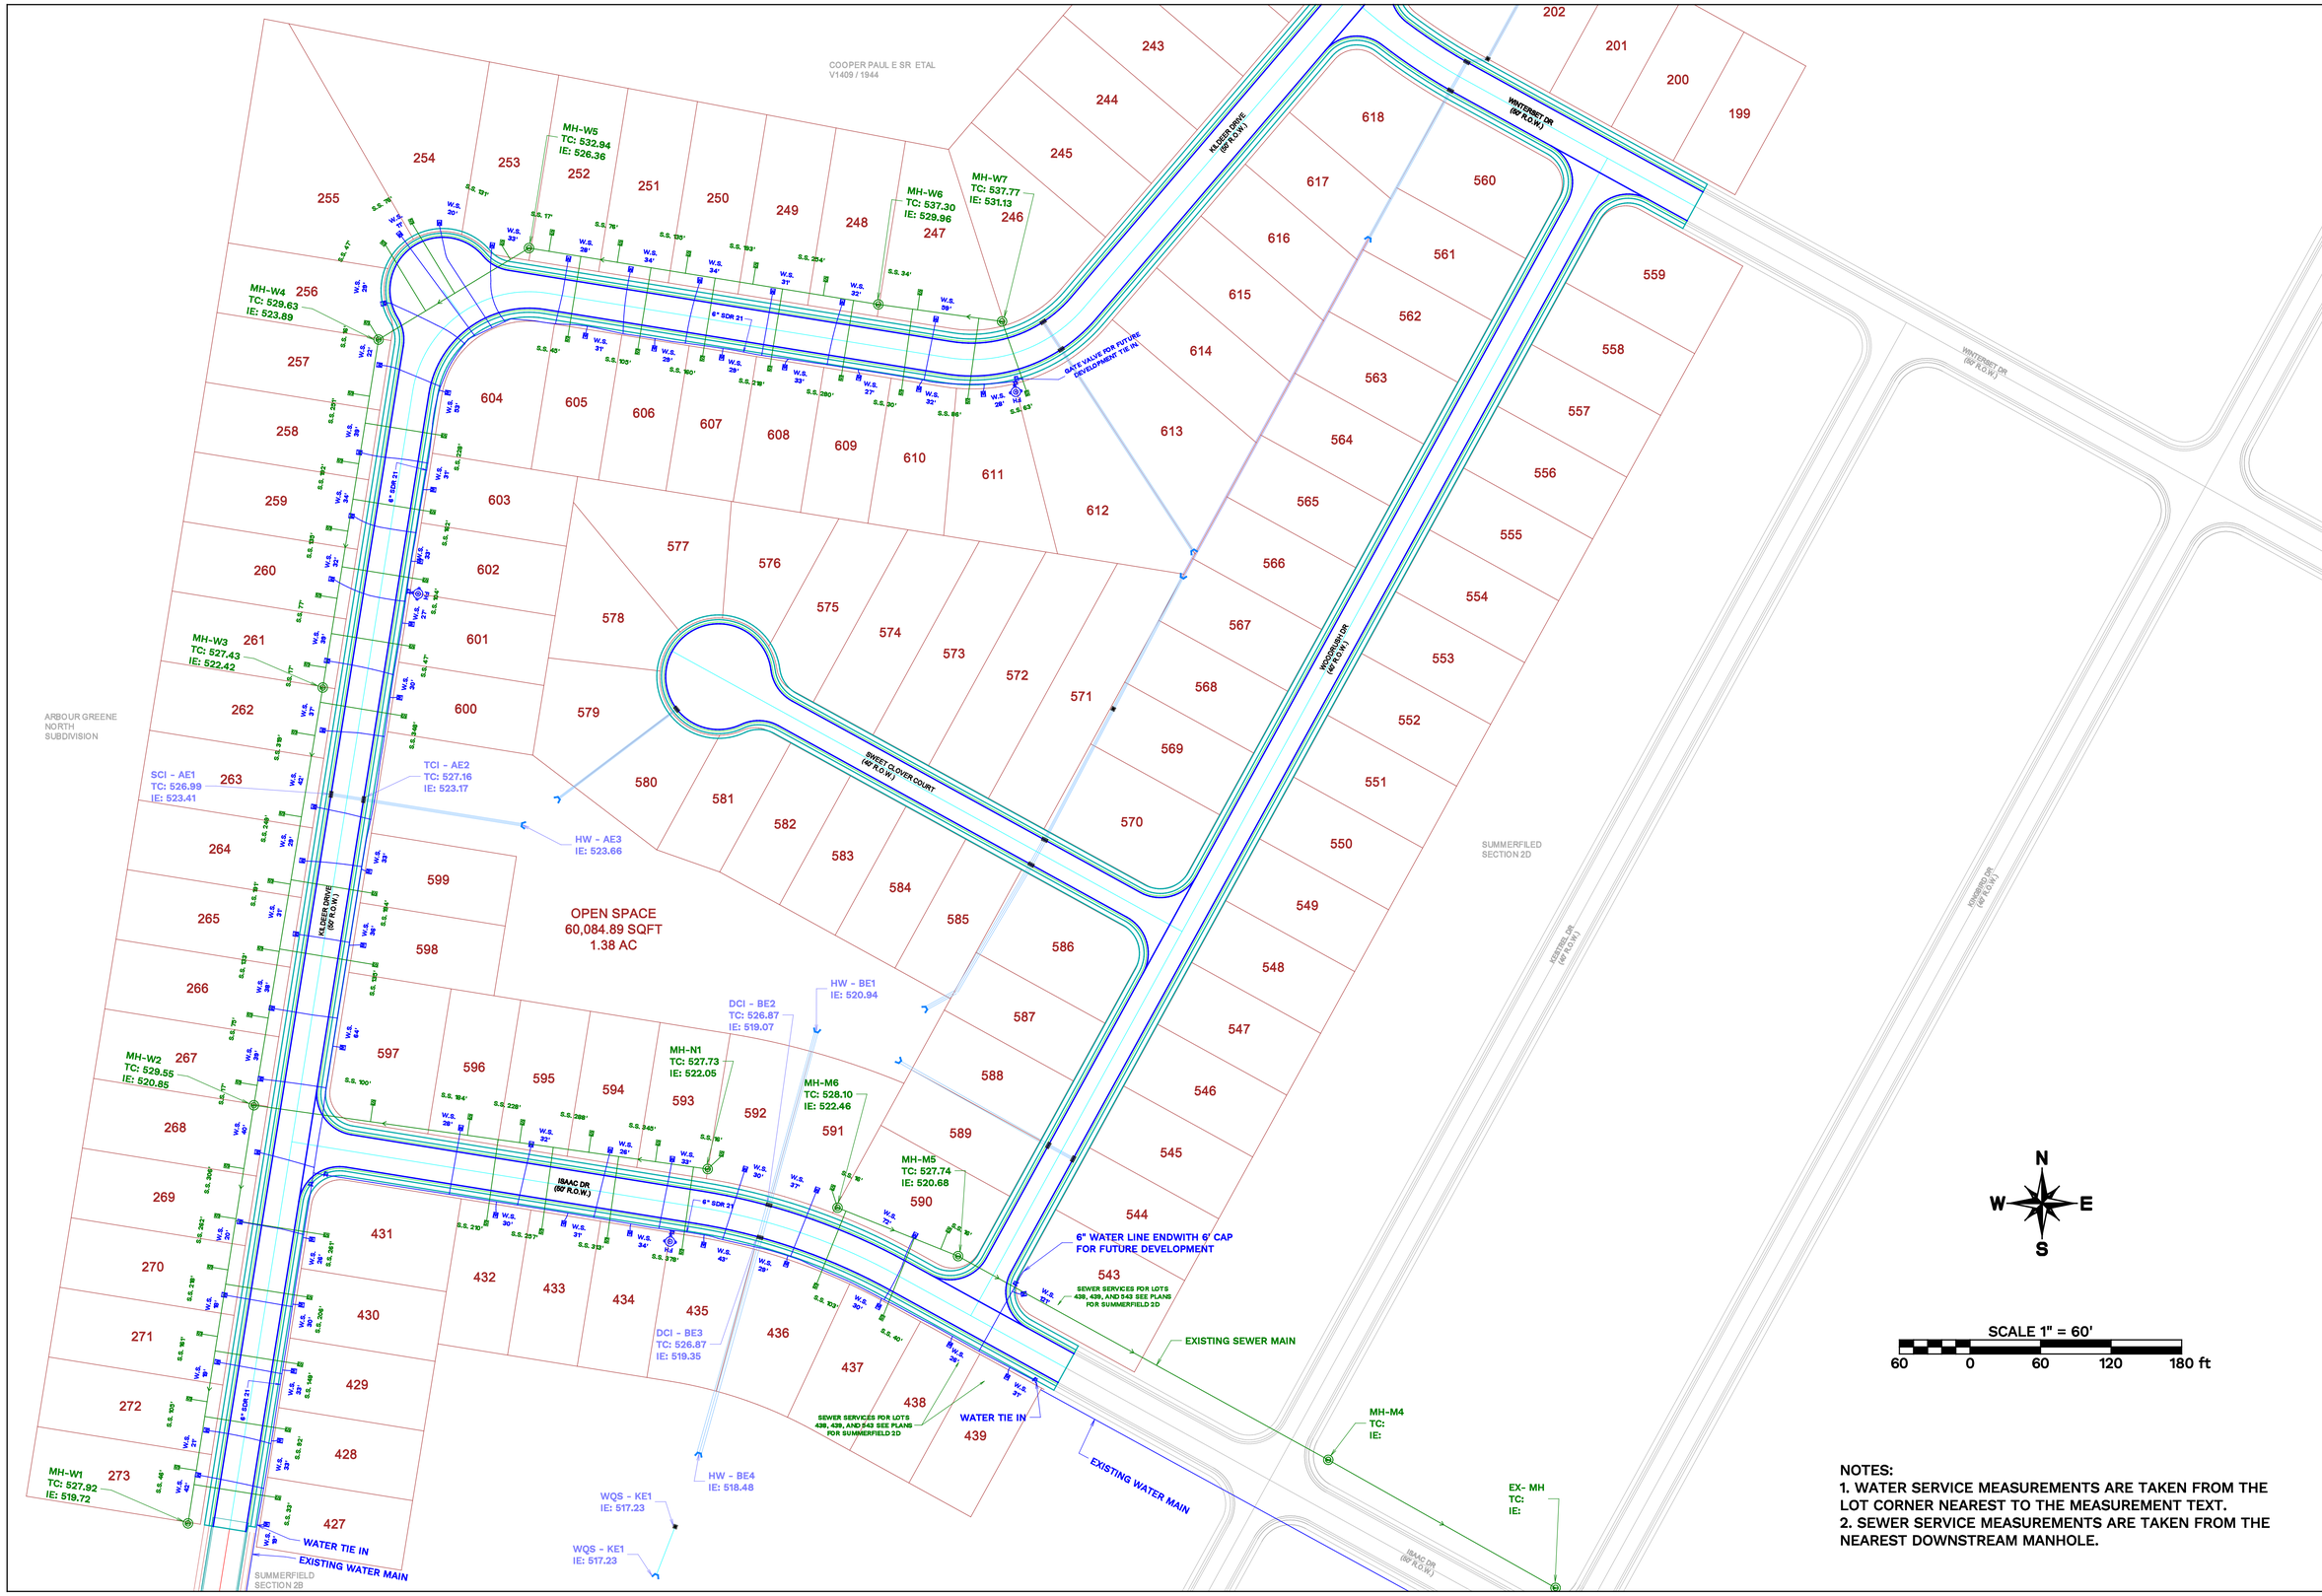

NOTES:
1. WATER SERVICE MEASUREMENTS ARE TAKEN FROM THE LOT CORNER NEAREST TO THE MEASUREMENT TEXT.
2. SEWER SERVICE MEASUREMENTS ARE TAKEN FROM THE NEAREST DOWNSTREAM MANHOLE.

NO.	REVISIONS	DATE:

AS BUILT EXHIBIT

SUMMERFIELD SECTION 2E PHASE 1
CLARKSVILLE, TN

BYARD CONSTRUCTION, LLC
324 INNOVATION WAY
CLARKSVILLE, TN
OFFICE: (931) 358 - 4700

SHEET
1 OF 1