-N-

SCALE 1" = 30'

30 0 30 60 90 ft

NOTES:
1. SEWER SERVICE MEASUREMENTS ARE TAKEN FROM THE NEAREST DOWNSTREAM MANHOLE.

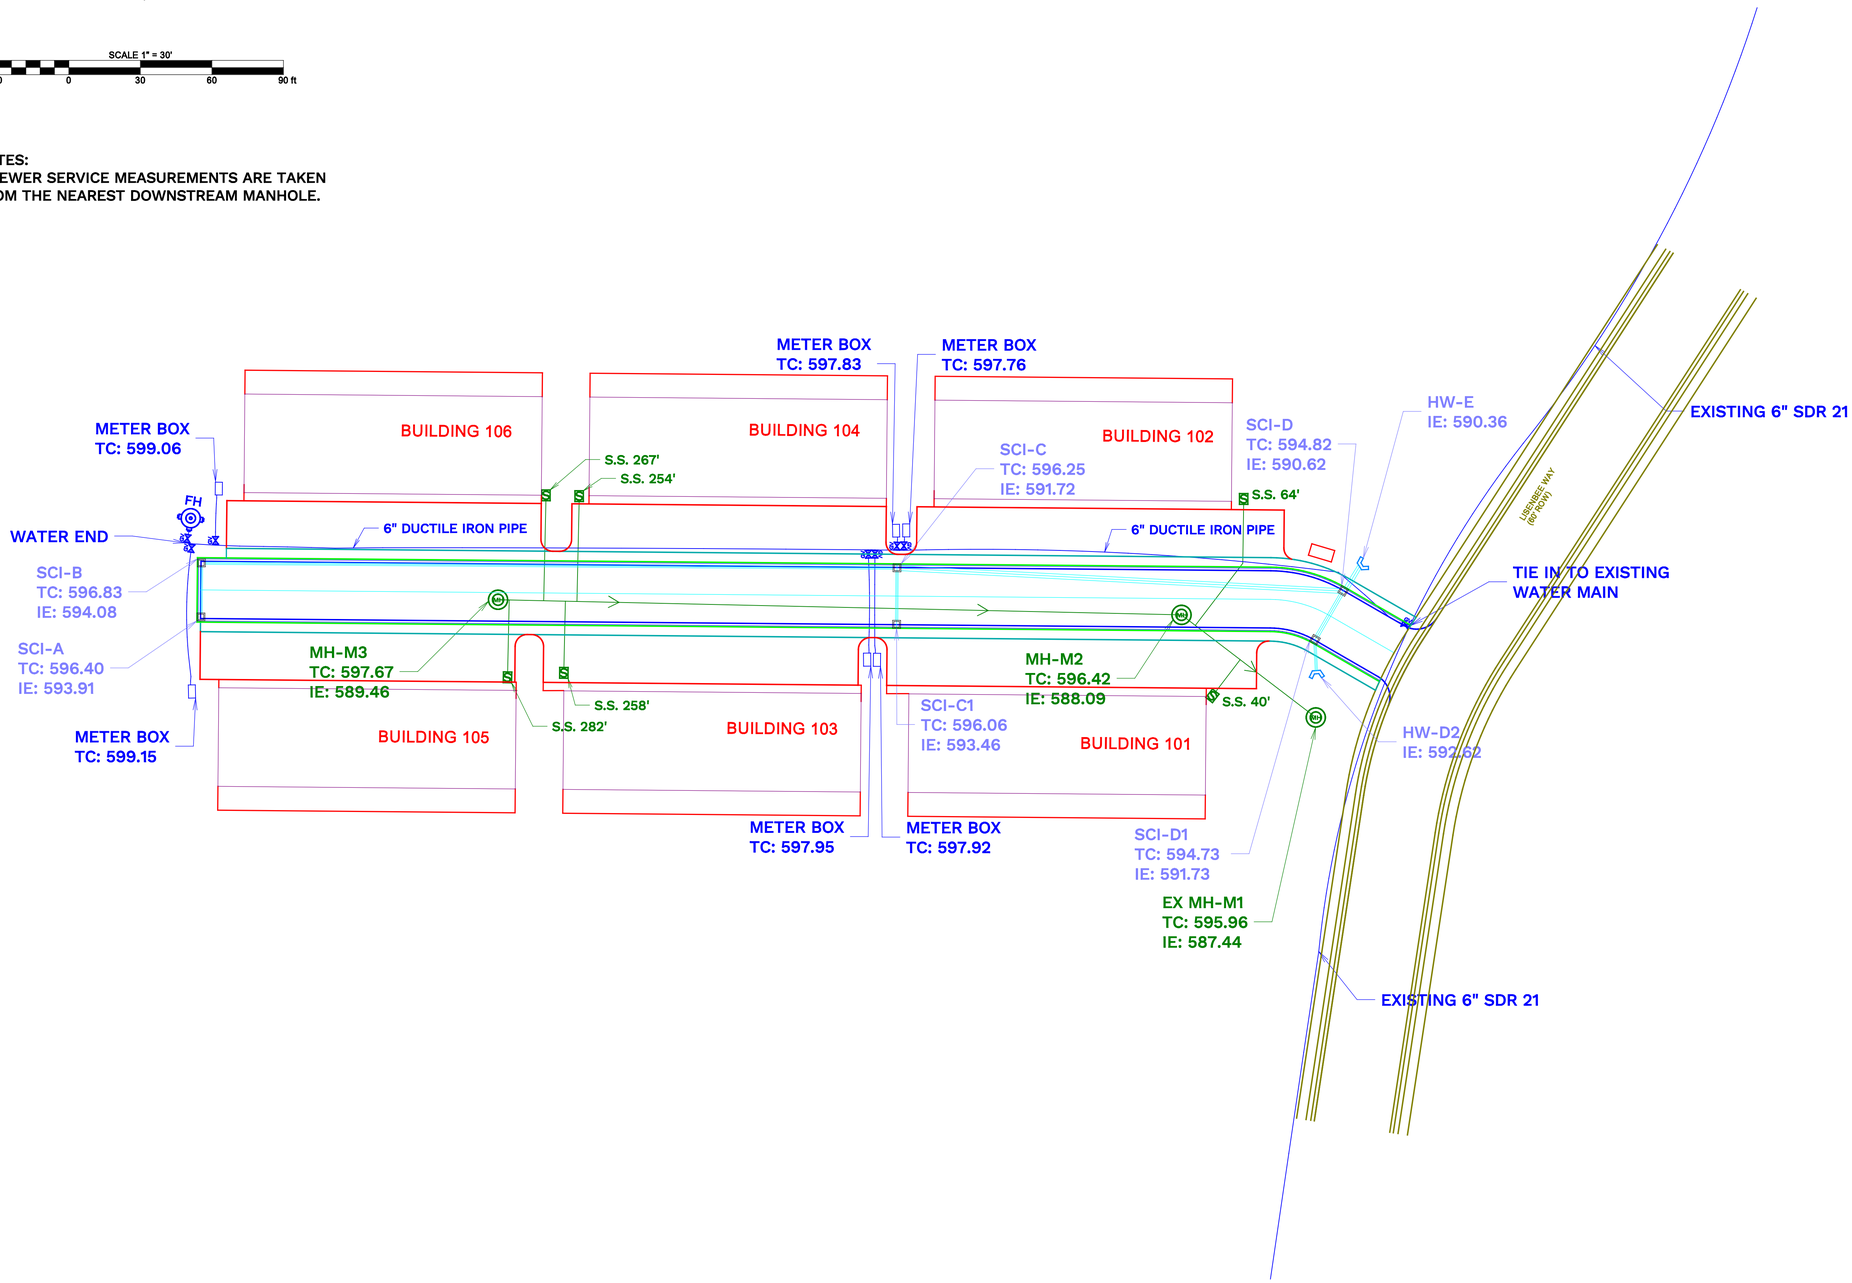

DATE:

REVISIONS

NO.

AS-BUILT EXHIBIT

LISENBEE TOWNHOMES
CLARKSVILLE, TN

BYARD CONSTRUCTION, LLC
3136 OLD SANGO ROAD
CLARKSVILLE, TN
OFFICE: (931) 358-4700

SHEET
1 OF 1