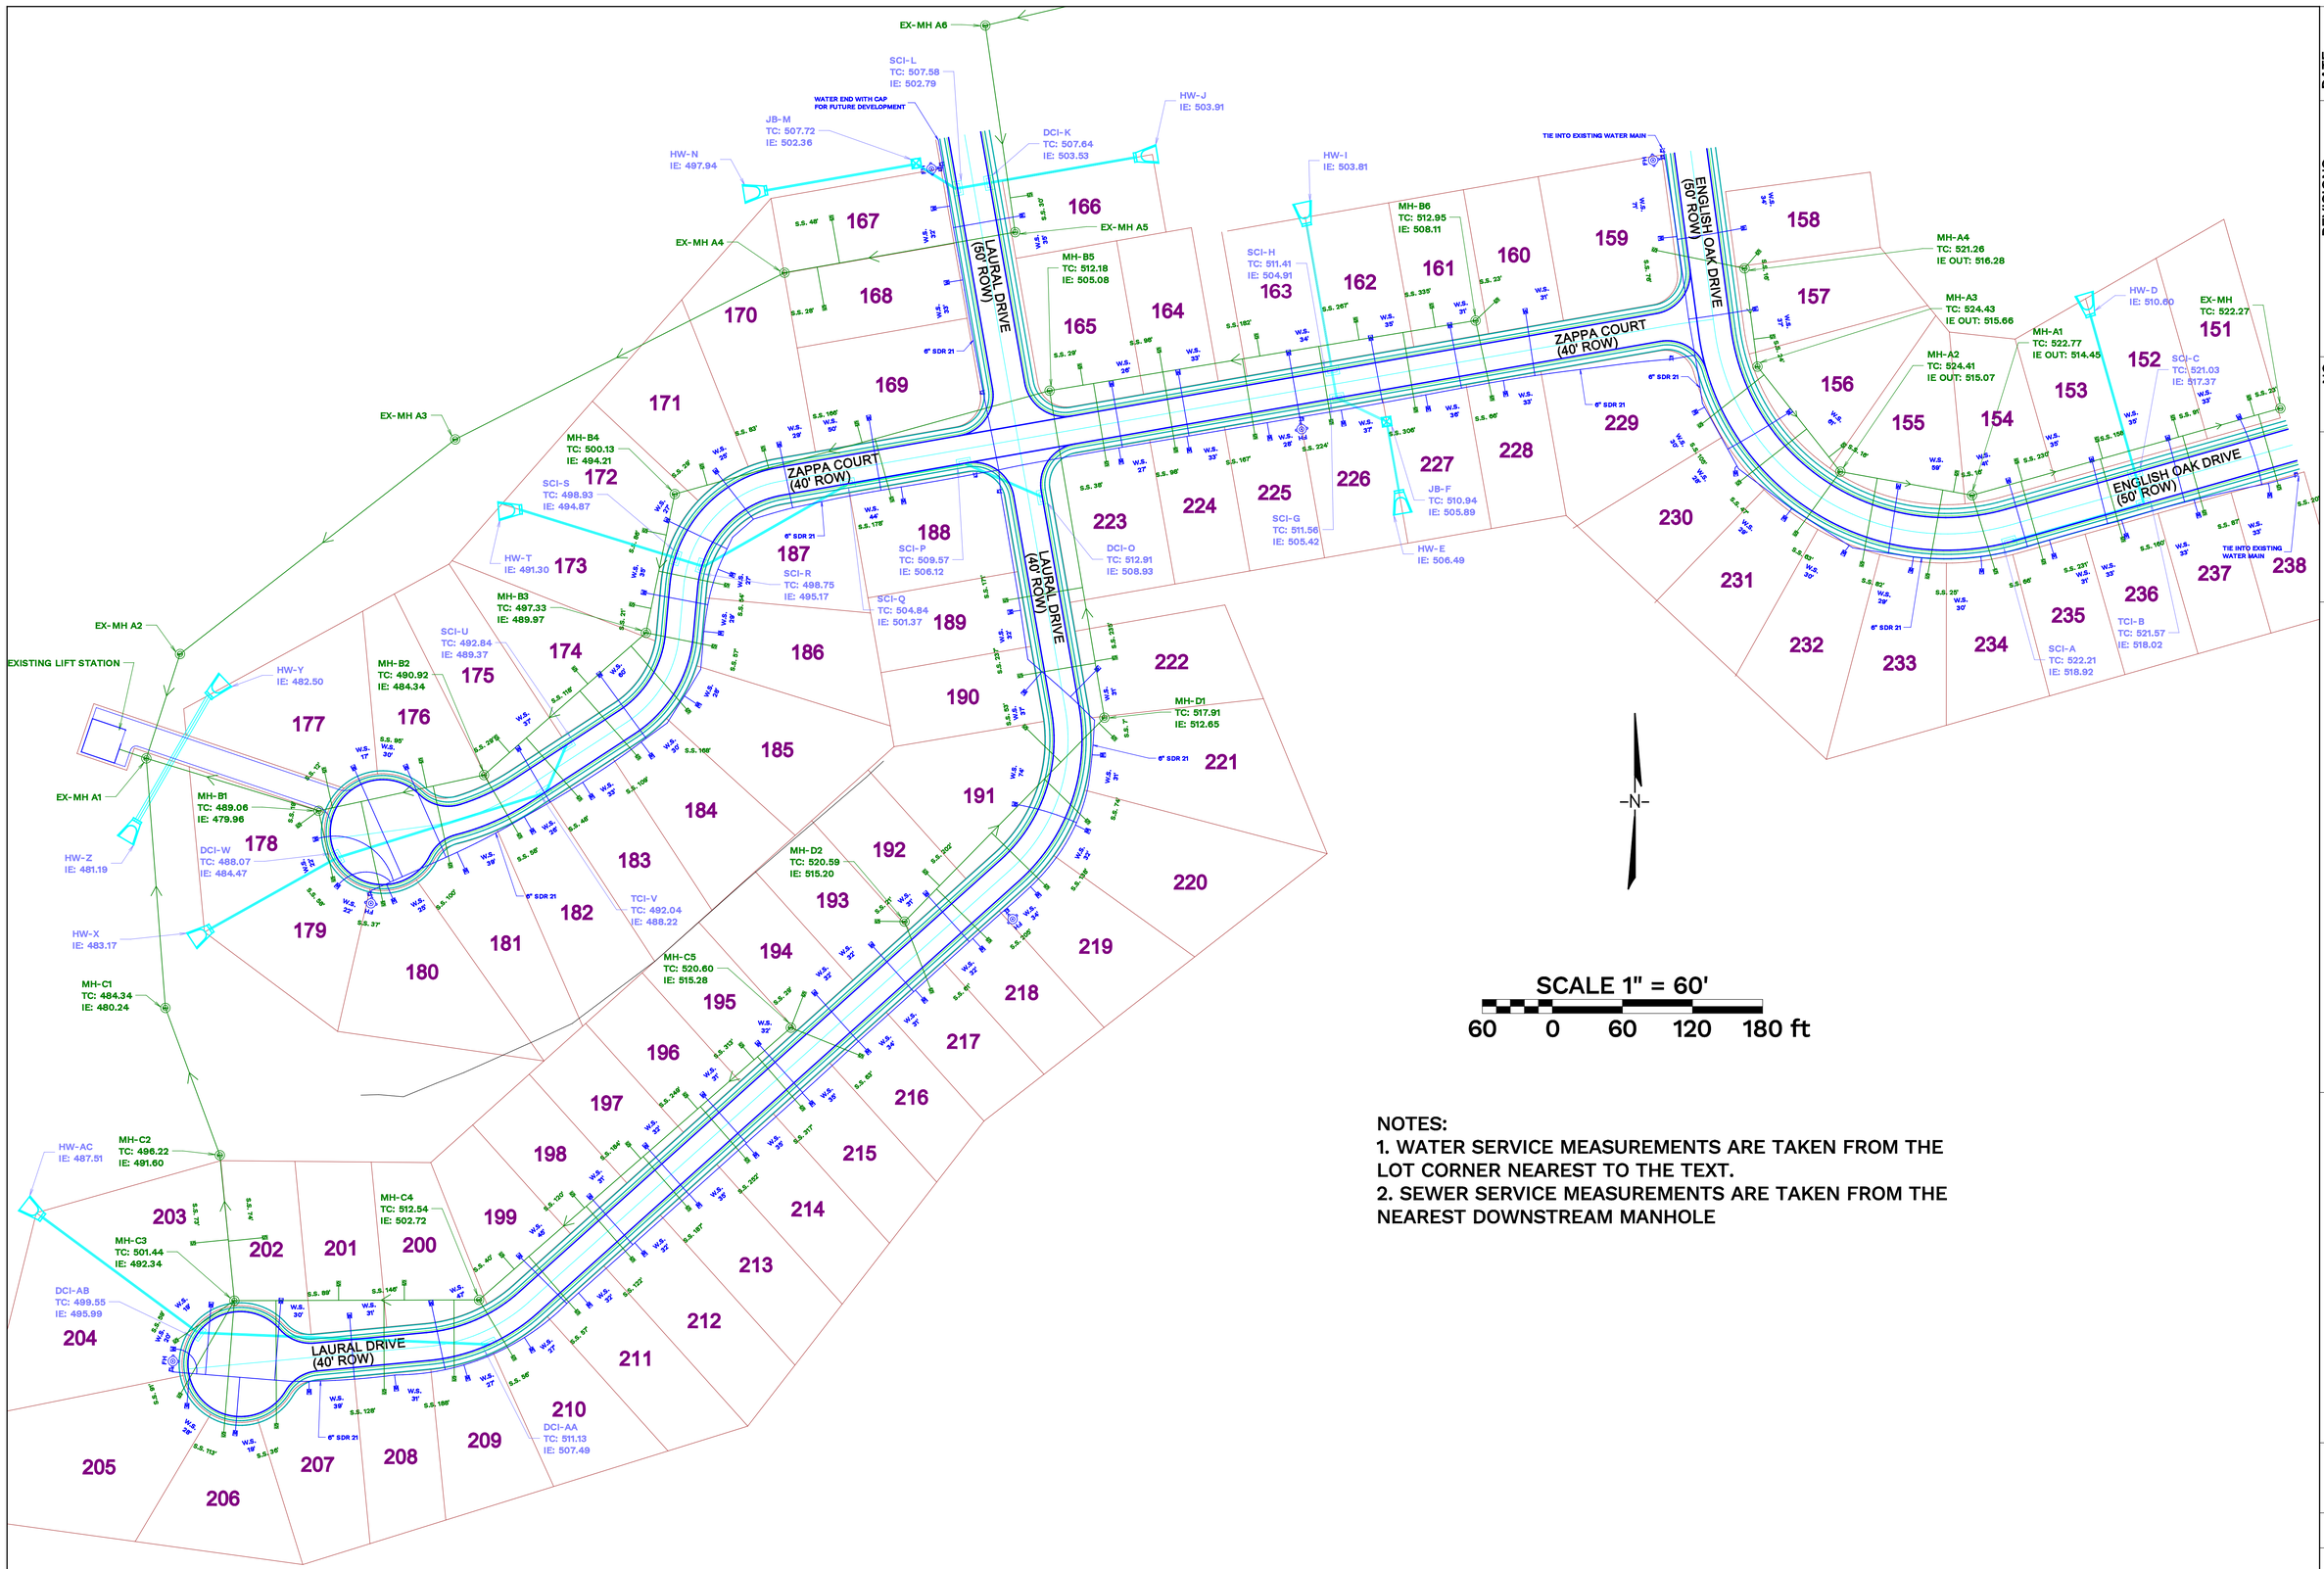

NOTES:
1. WATER SERVICE MEASUREMENTS ARE TAKEN FROM THE LOT CORNER NEAREST TO THE TEXT.
2. SEWER SERVICE MEASUREMENTS ARE TAKEN FROM THE NEAREST DOWNSTREAM MANHOLE

DATE:

REVISIONS

NO.

AS-BUILT EXHIBIT

THE OAKS SECTION 2
CLARKSVILLE, TN

BYARD CONSTRUCTION, LLC
324 INNOVATON WAY
CLARKSVILLE, TN
OFFICE: (931) 358-4700

SHEET
1 OF 1