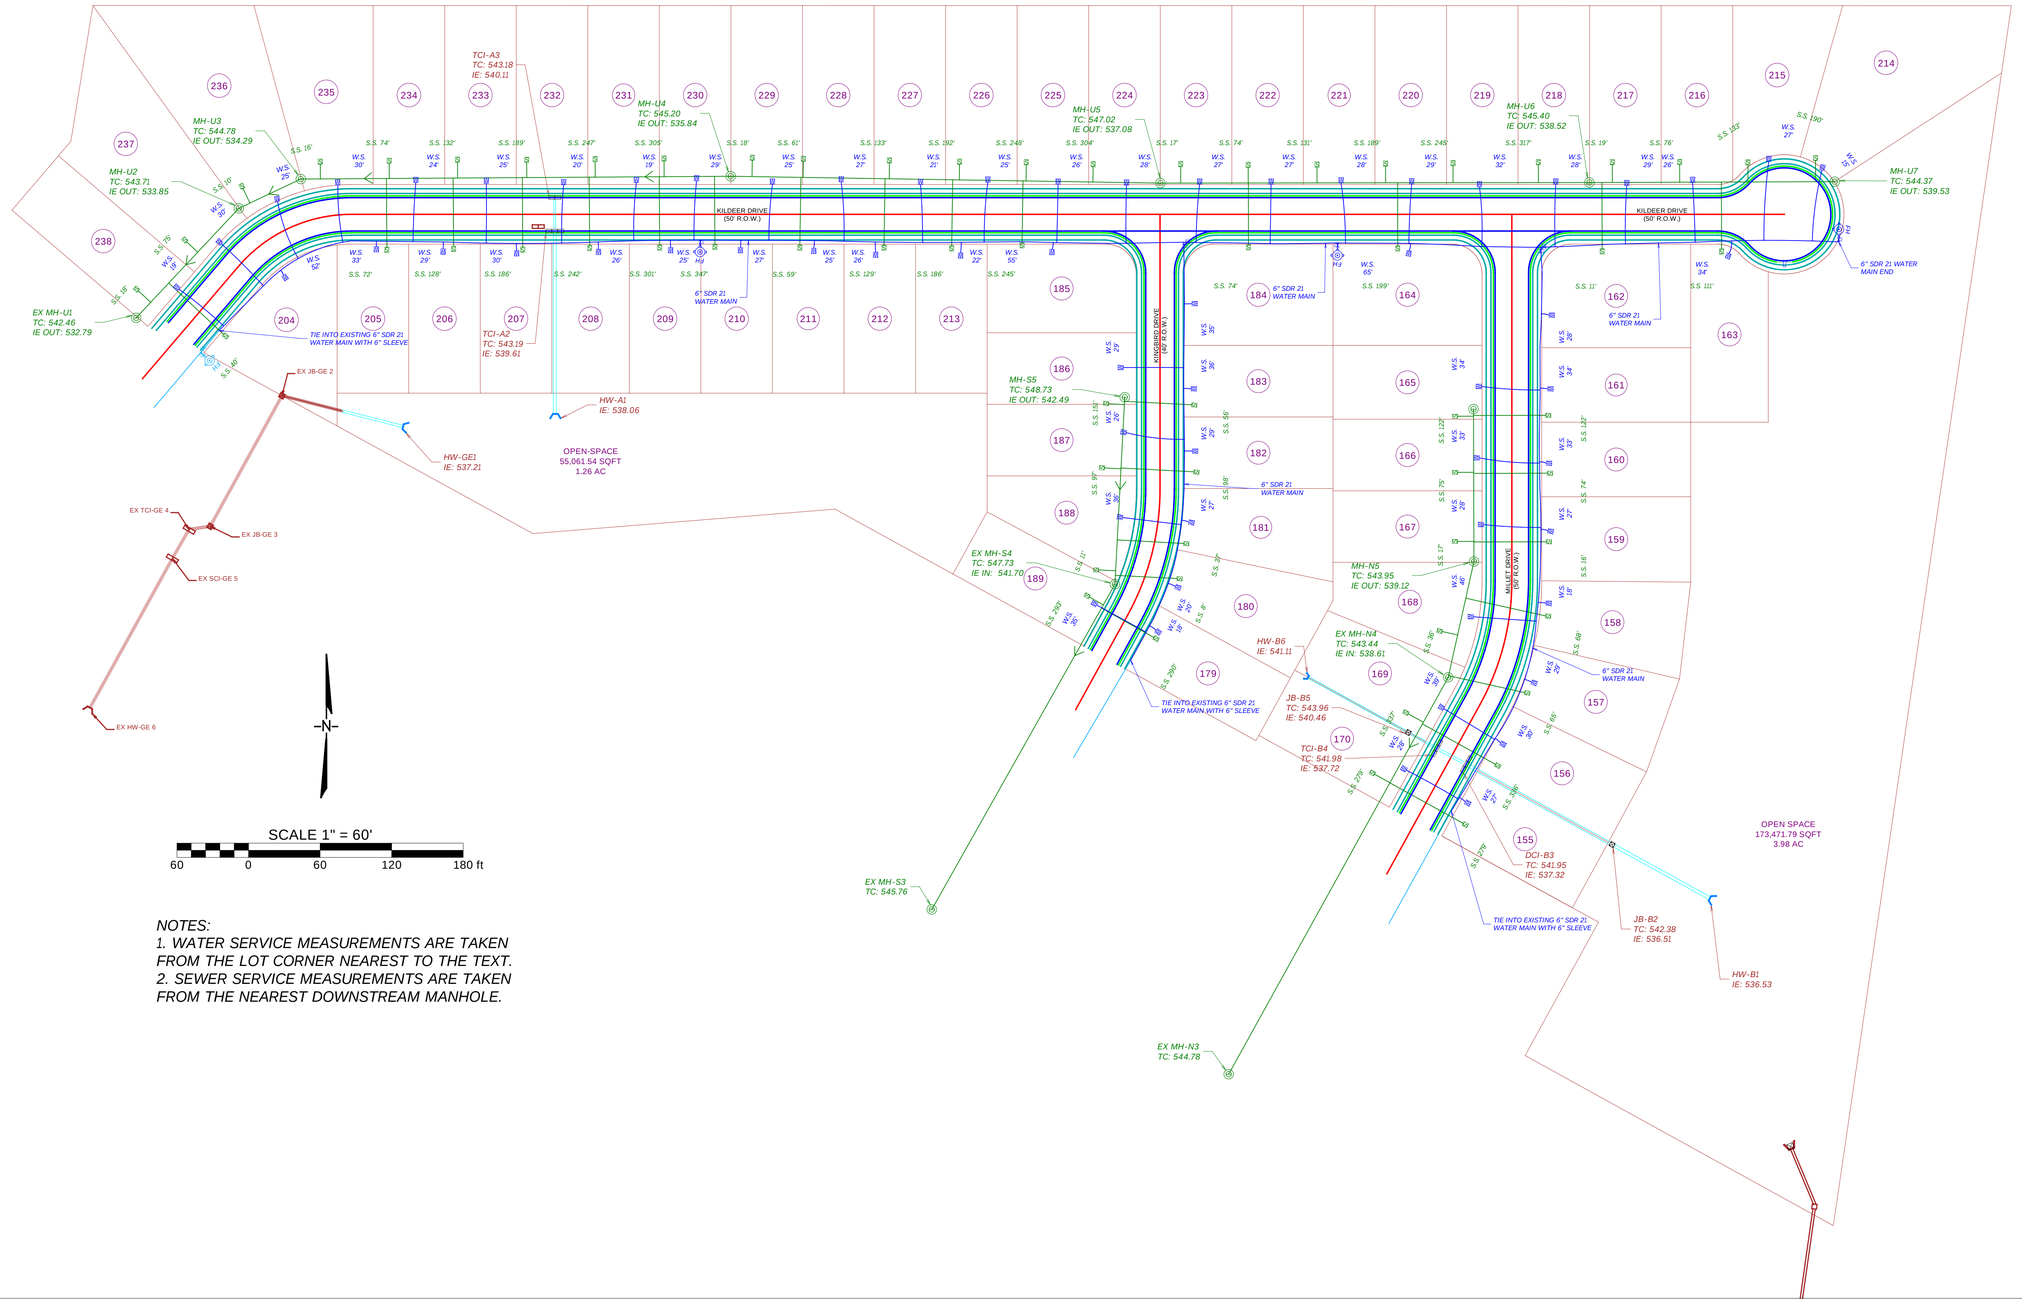

NOTES:
1. WATER SERVICE MEASUREMENTS ARE TAKEN FROM THE LOT CORNER NEAREST TO THE TEXT.
2. SEWER SERVICE MEASUREMENTS ARE TAKEN FROM THE NEAREST DOWNSTREAM MANHOLE.

NO.	REVISIONS	DATE:

AS-BUILT EXHIBIT

SUMMERFIELD 2F
CLARKSVILLE,TN

BYARD CONSTRUCTION, LLC
324 INNOVATON WAY
CLARKSVILLE, TN
OFFICE: (931) 358-4700

SHEET

1 OF 1